


04DM12-146 160

260

0374-2140

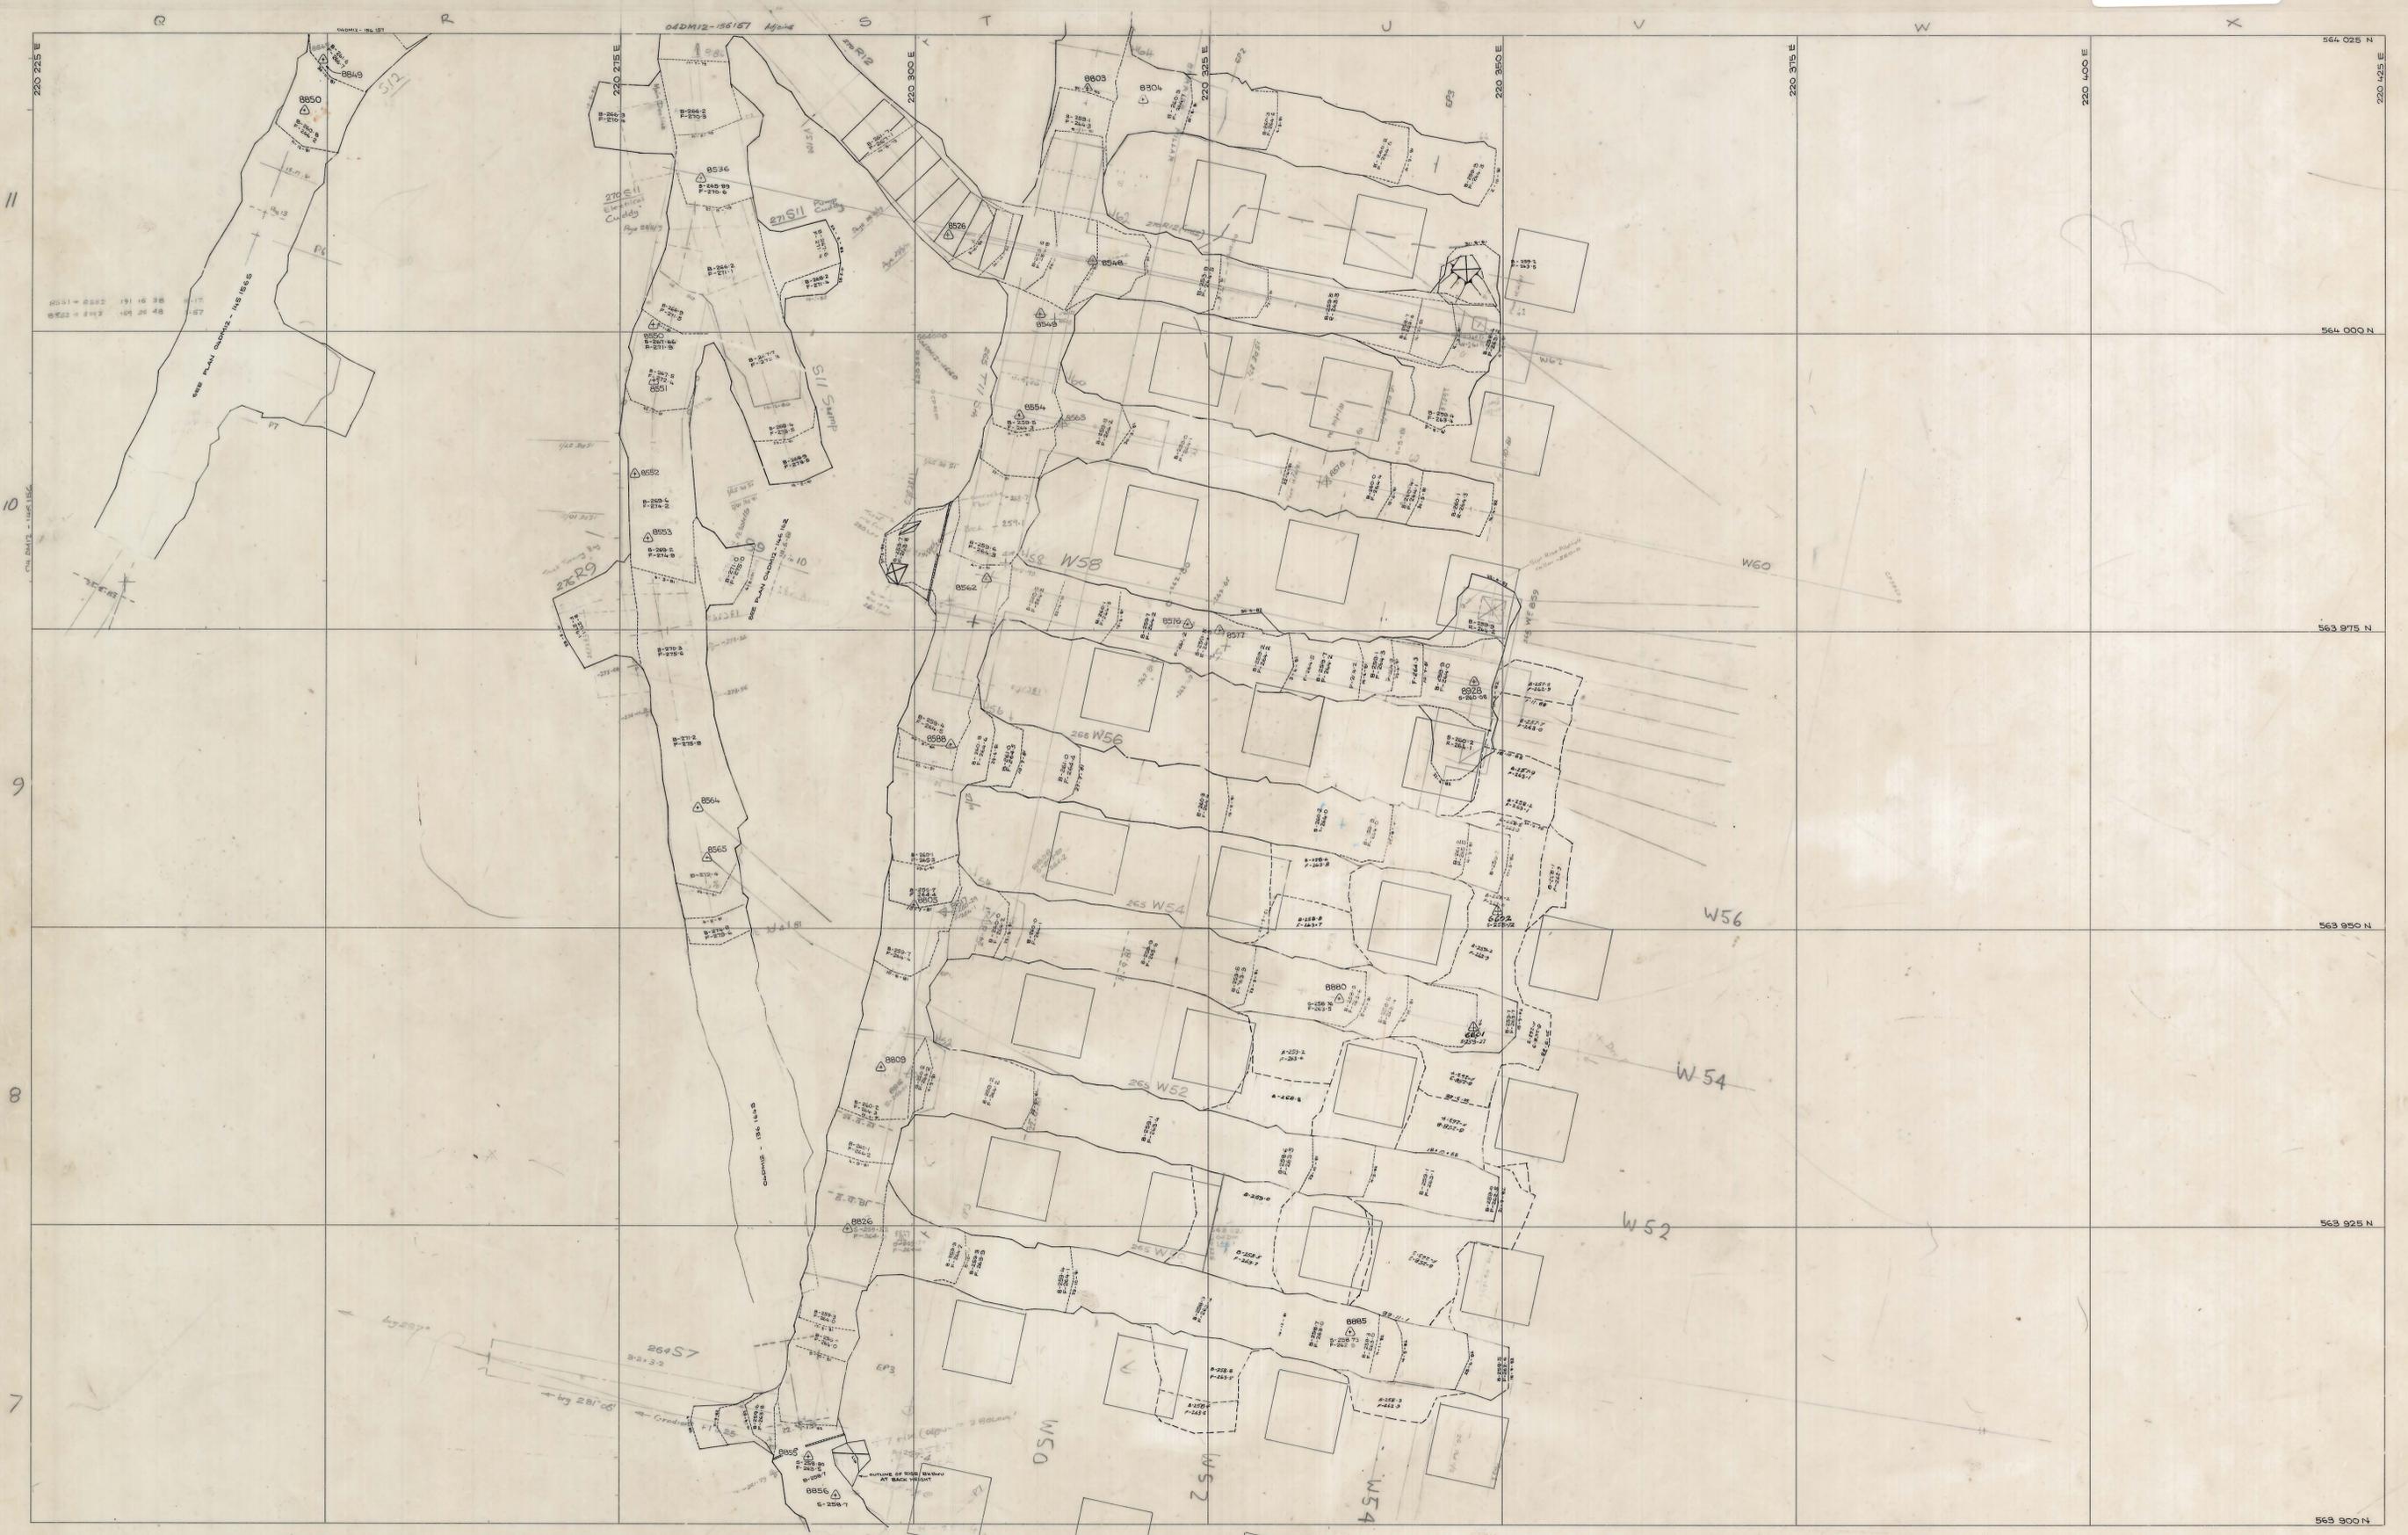

SCALE 1:250

2-1 Plans  
 03DM12-3017 280 Lev DYM  
 DMCS 122 - 280 Lev  
 W31105-3004 267 59 W 210 N 200 Lev



LOCATION  
 DOLPHIN MINE

SUBJECT  
 MAIN DECLINE

**KIS** KING ISLAND SCHEELITE  
 A DIVISION OF WARRIOR INTERNATIONAL

GRASSY KING ISLAND

PLAN NUMBER  
 04DM12 - 146 160

146 160