


04DM12-156 116

-150 LEVEL

0374-2144

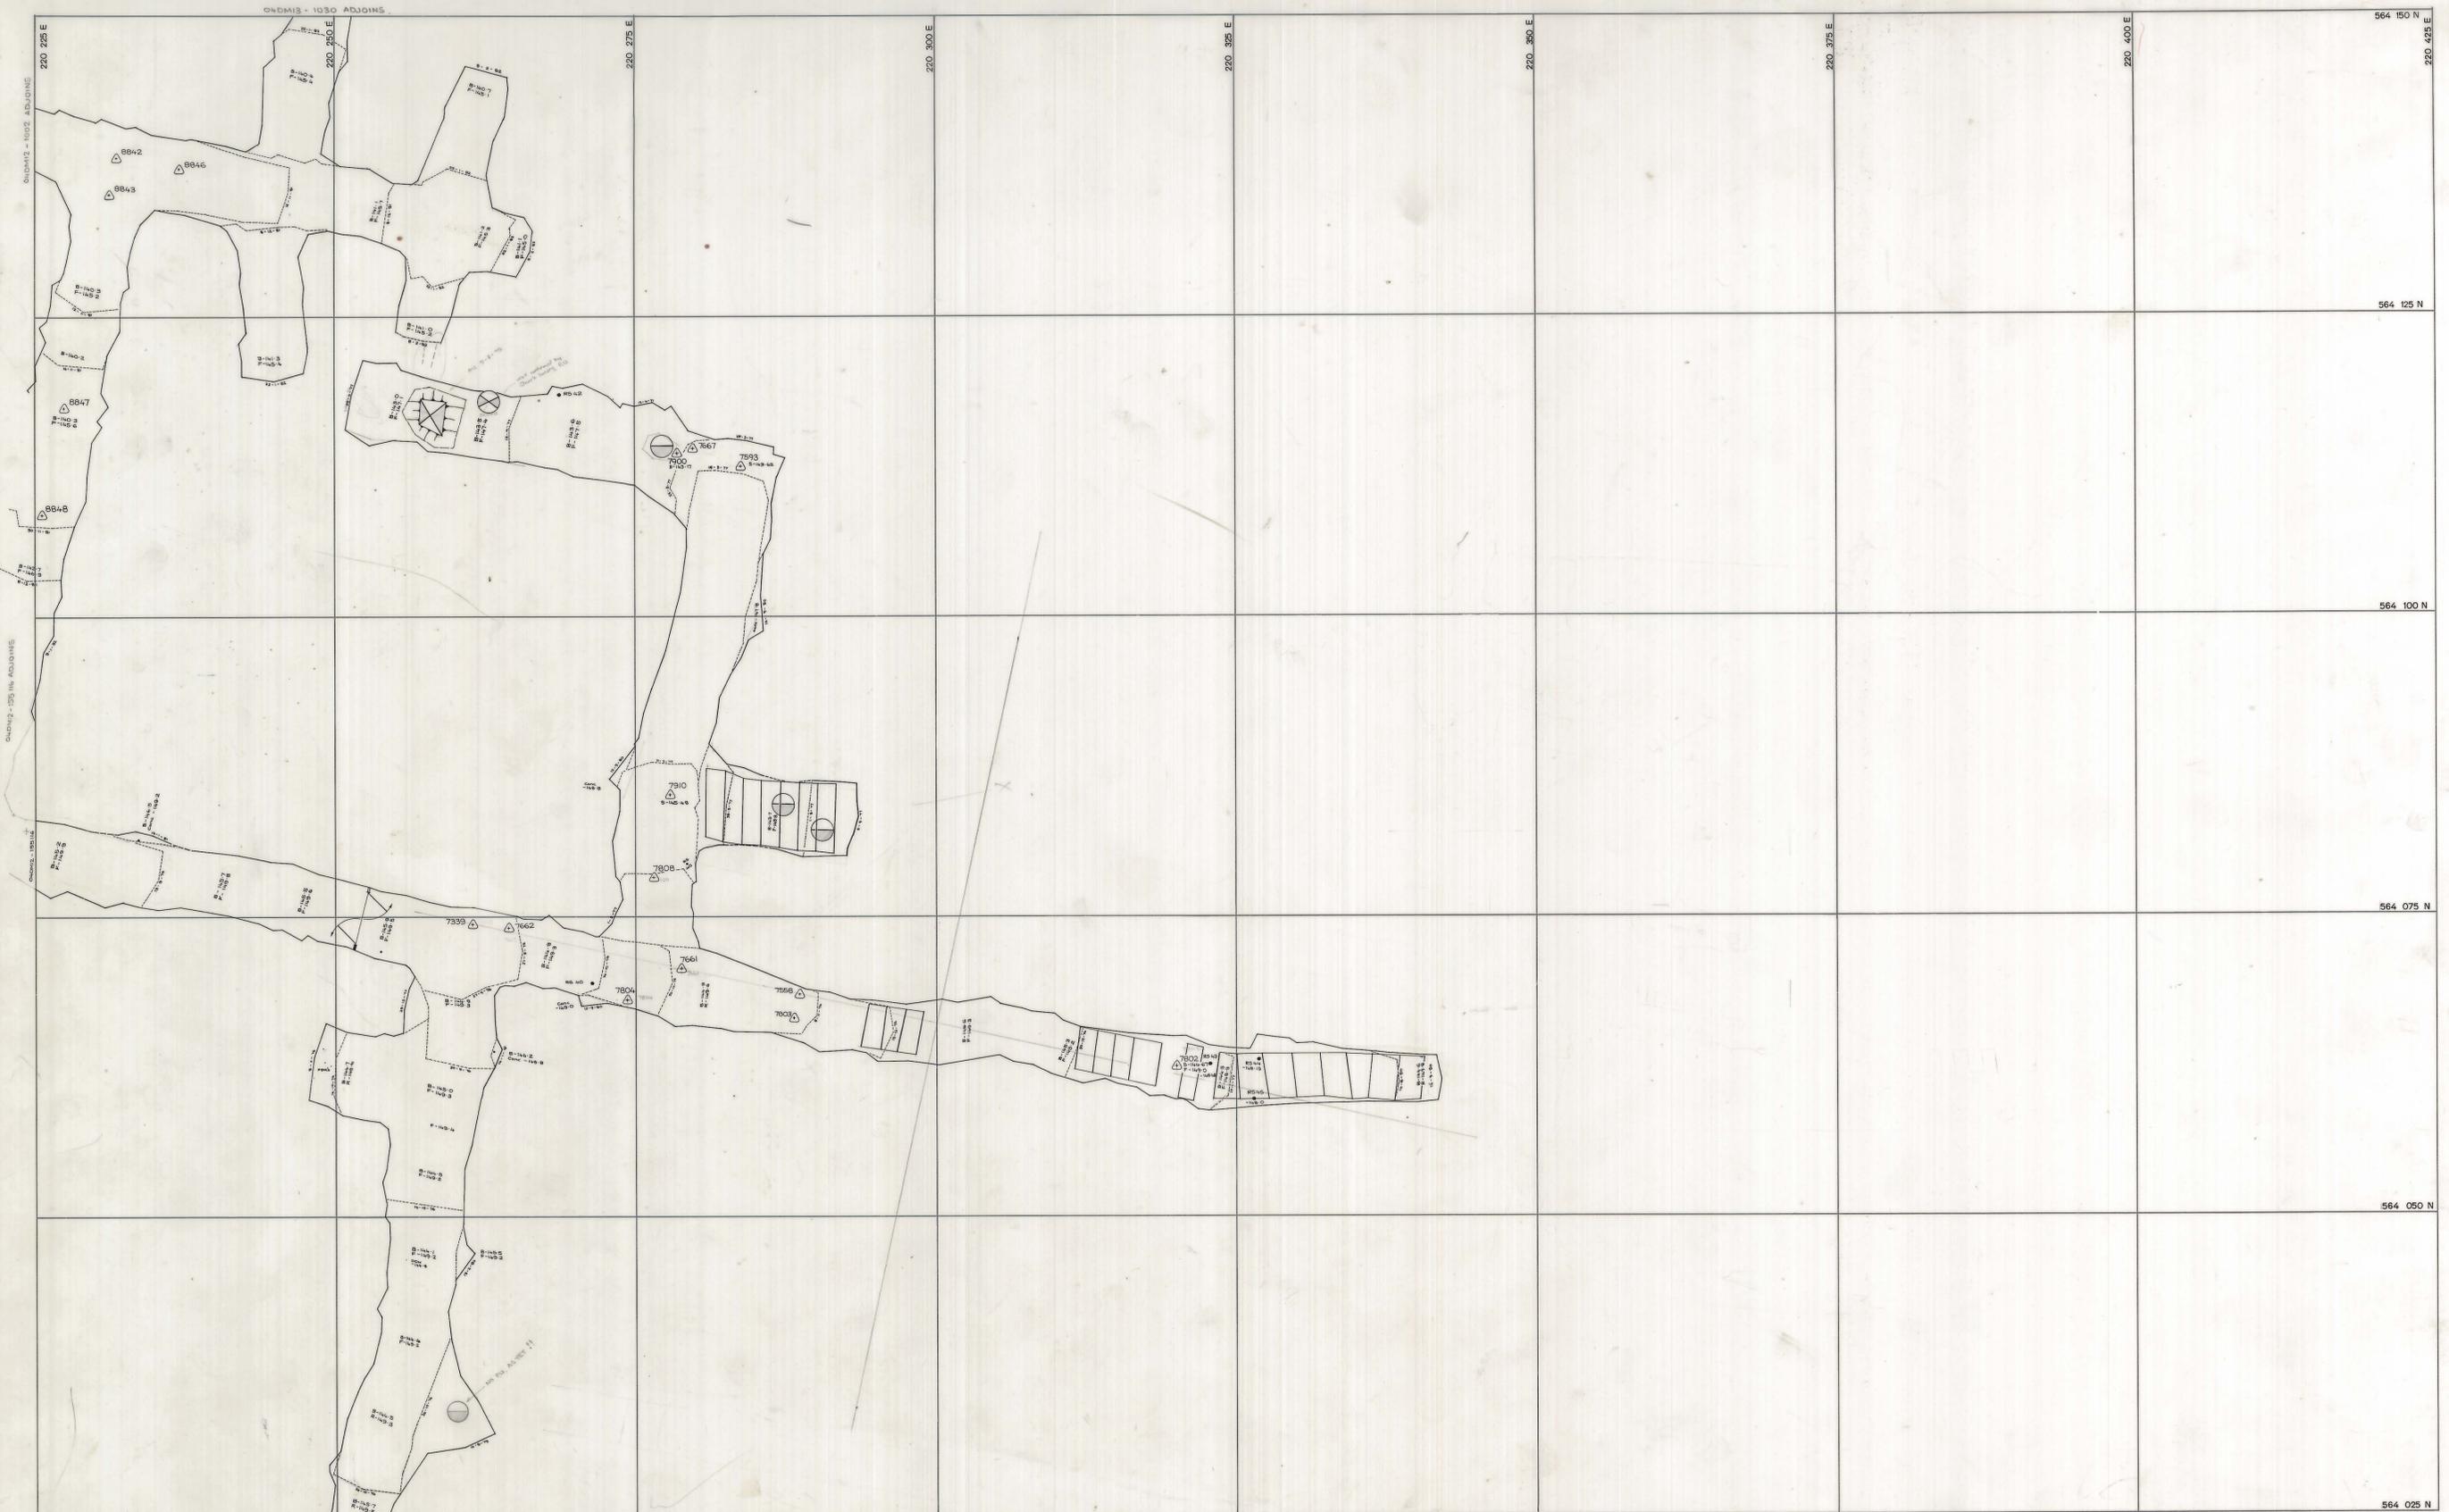

OILCAYL - 1016 ADJOINS - HOWEVER NOTE M14 (N15) DRIVE INCORRECTLY PLOTTED

	SCALE 1:250	<p>north</p>	<p>LOCATION DOLFIN MINE</p> <p>SUBJECT -150m LEVEL DEVELOPMENT</p>	<p>KING ISLAND SCHEELITE A DIVISION OF WARMAN INTERNATIONAL</p> <p>GRASSY KING ISLAND</p> <p>PLAN NUMBER 04DM12 - 156 116</p>
--	-------------	--------------	--	---