


0374 - 215

04BH15 - 105 - 94



SCALE 1:500

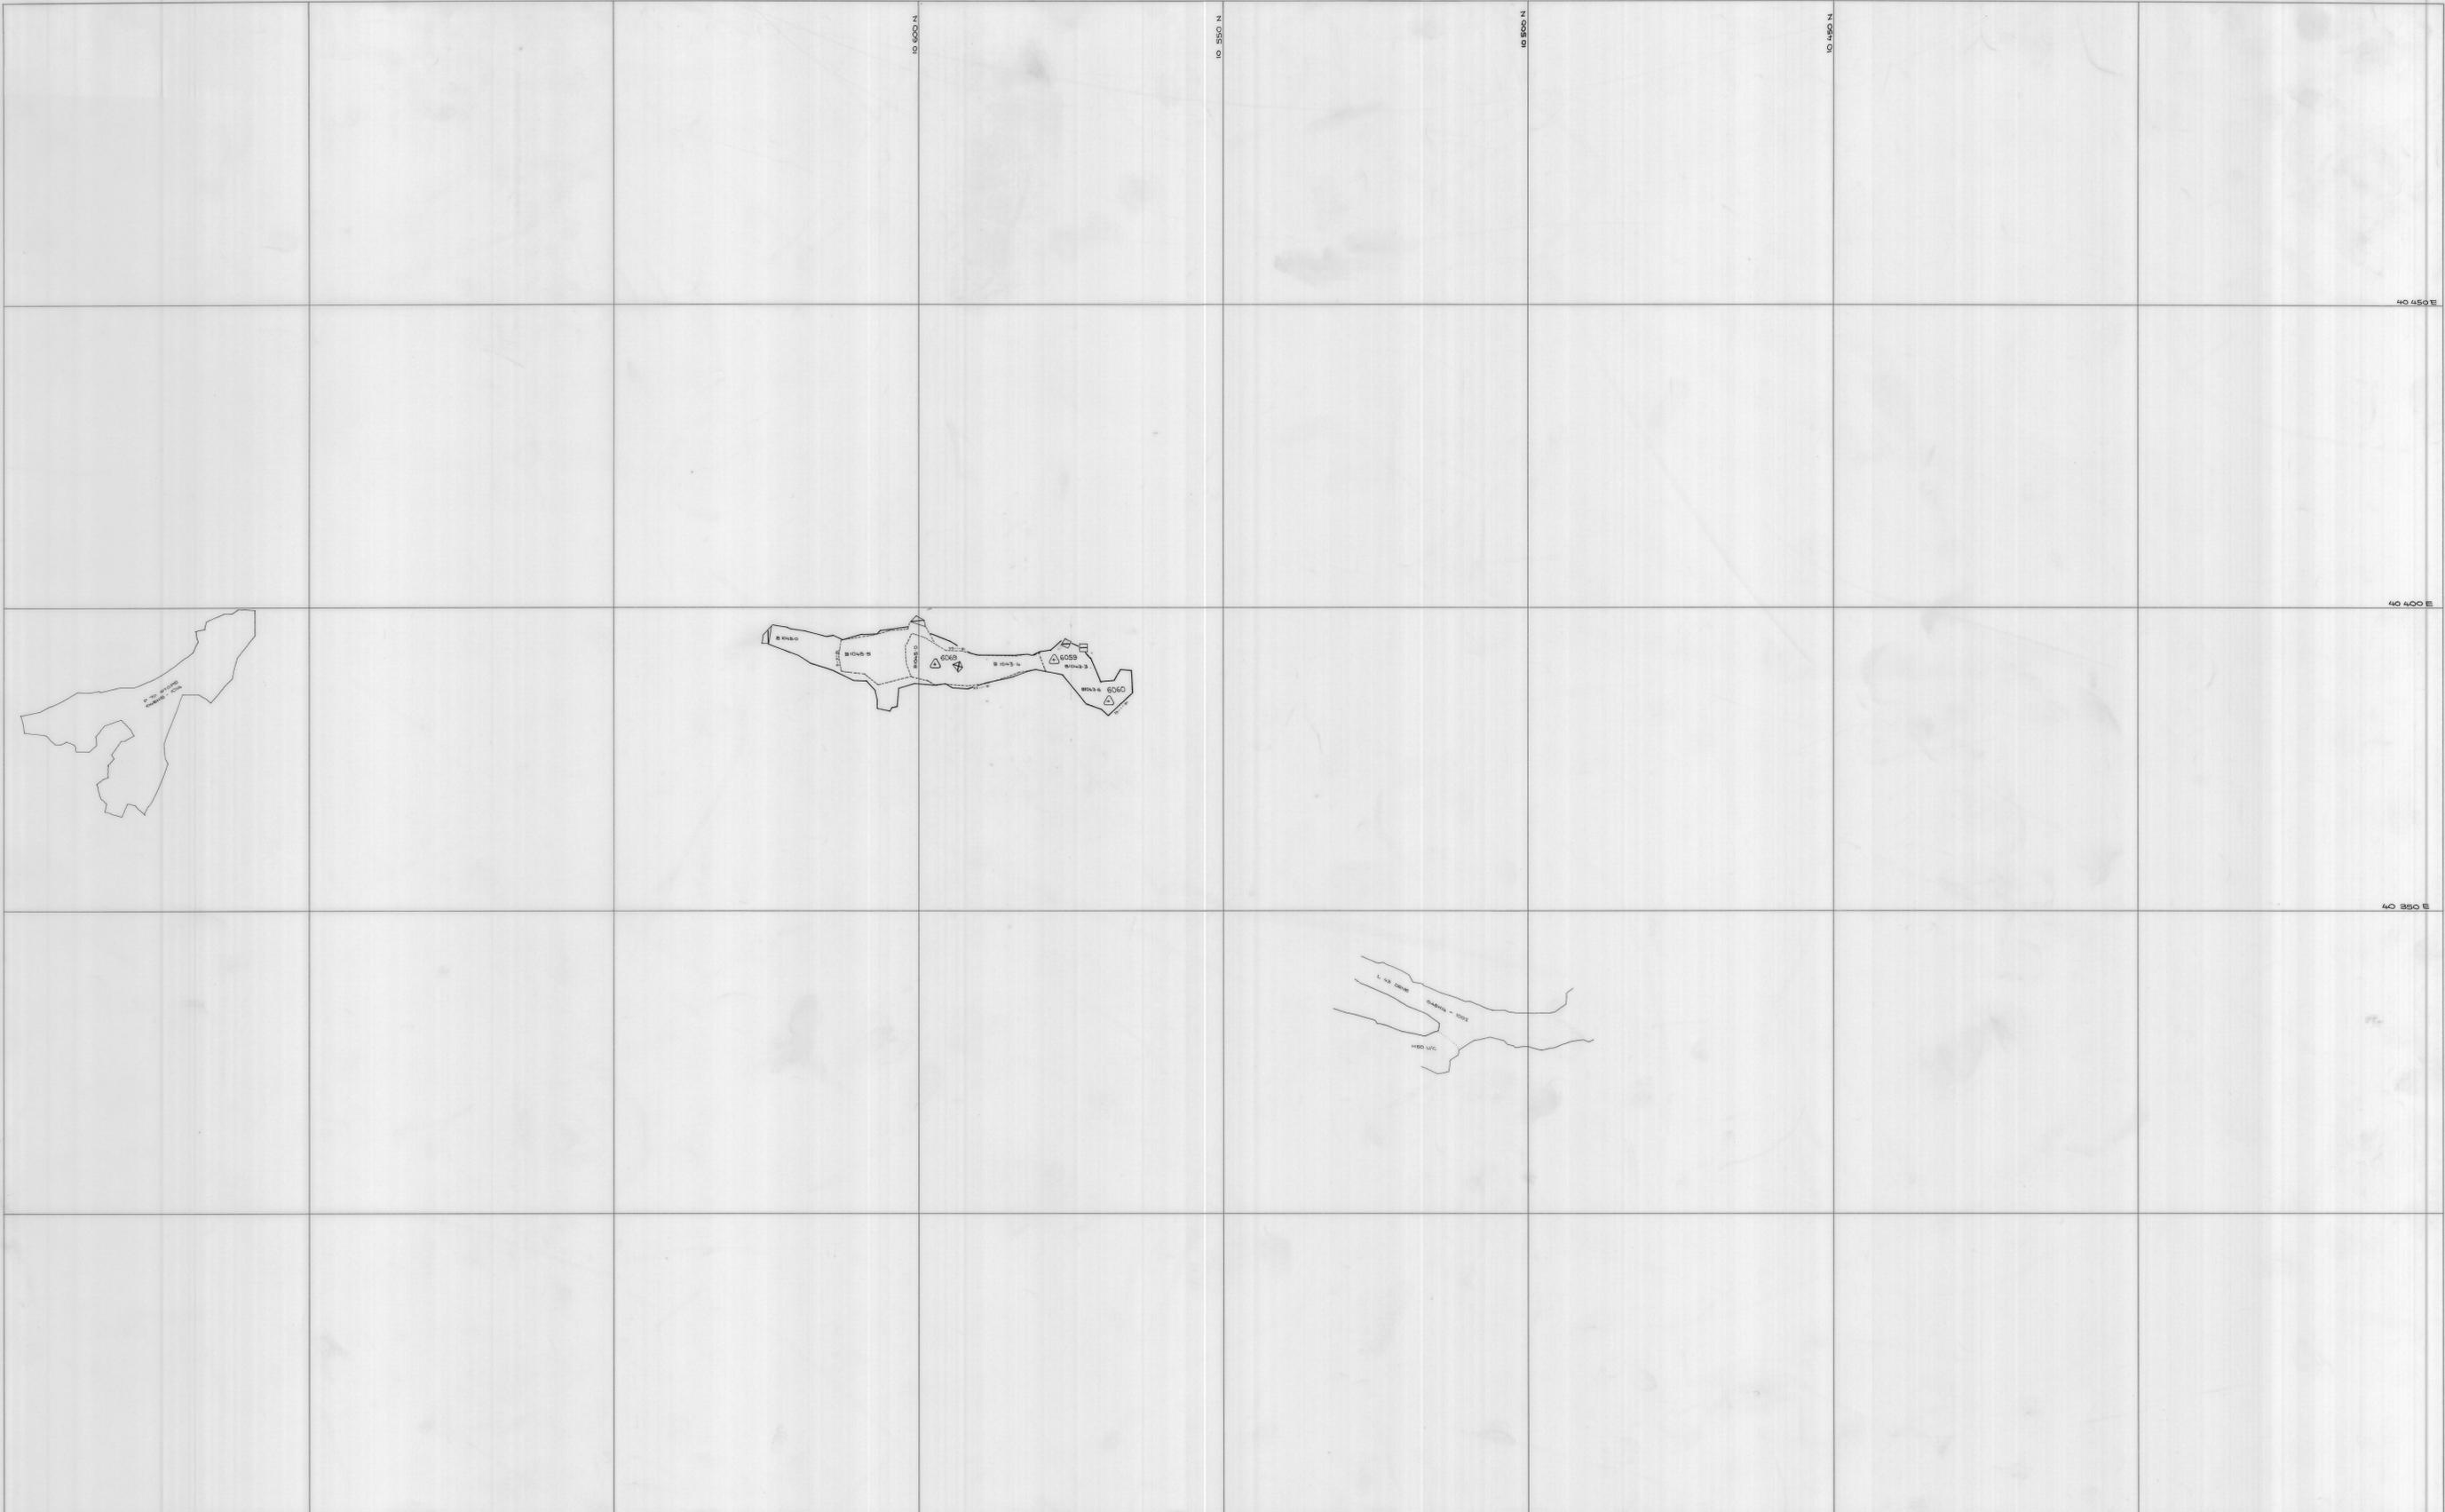

north

LOCATION BOLD HEAD MINE

SUBJECT

P57 STOPE
6th lift

KIS KING ISLAND SCHEELITE
A DIVISION OF HARBAN INTERNATIONAL

GRASSY KING ISLAND

PLAN NUMBER 04BH15 - 105 - 94