


04DM13 - 146 147

0374_2150

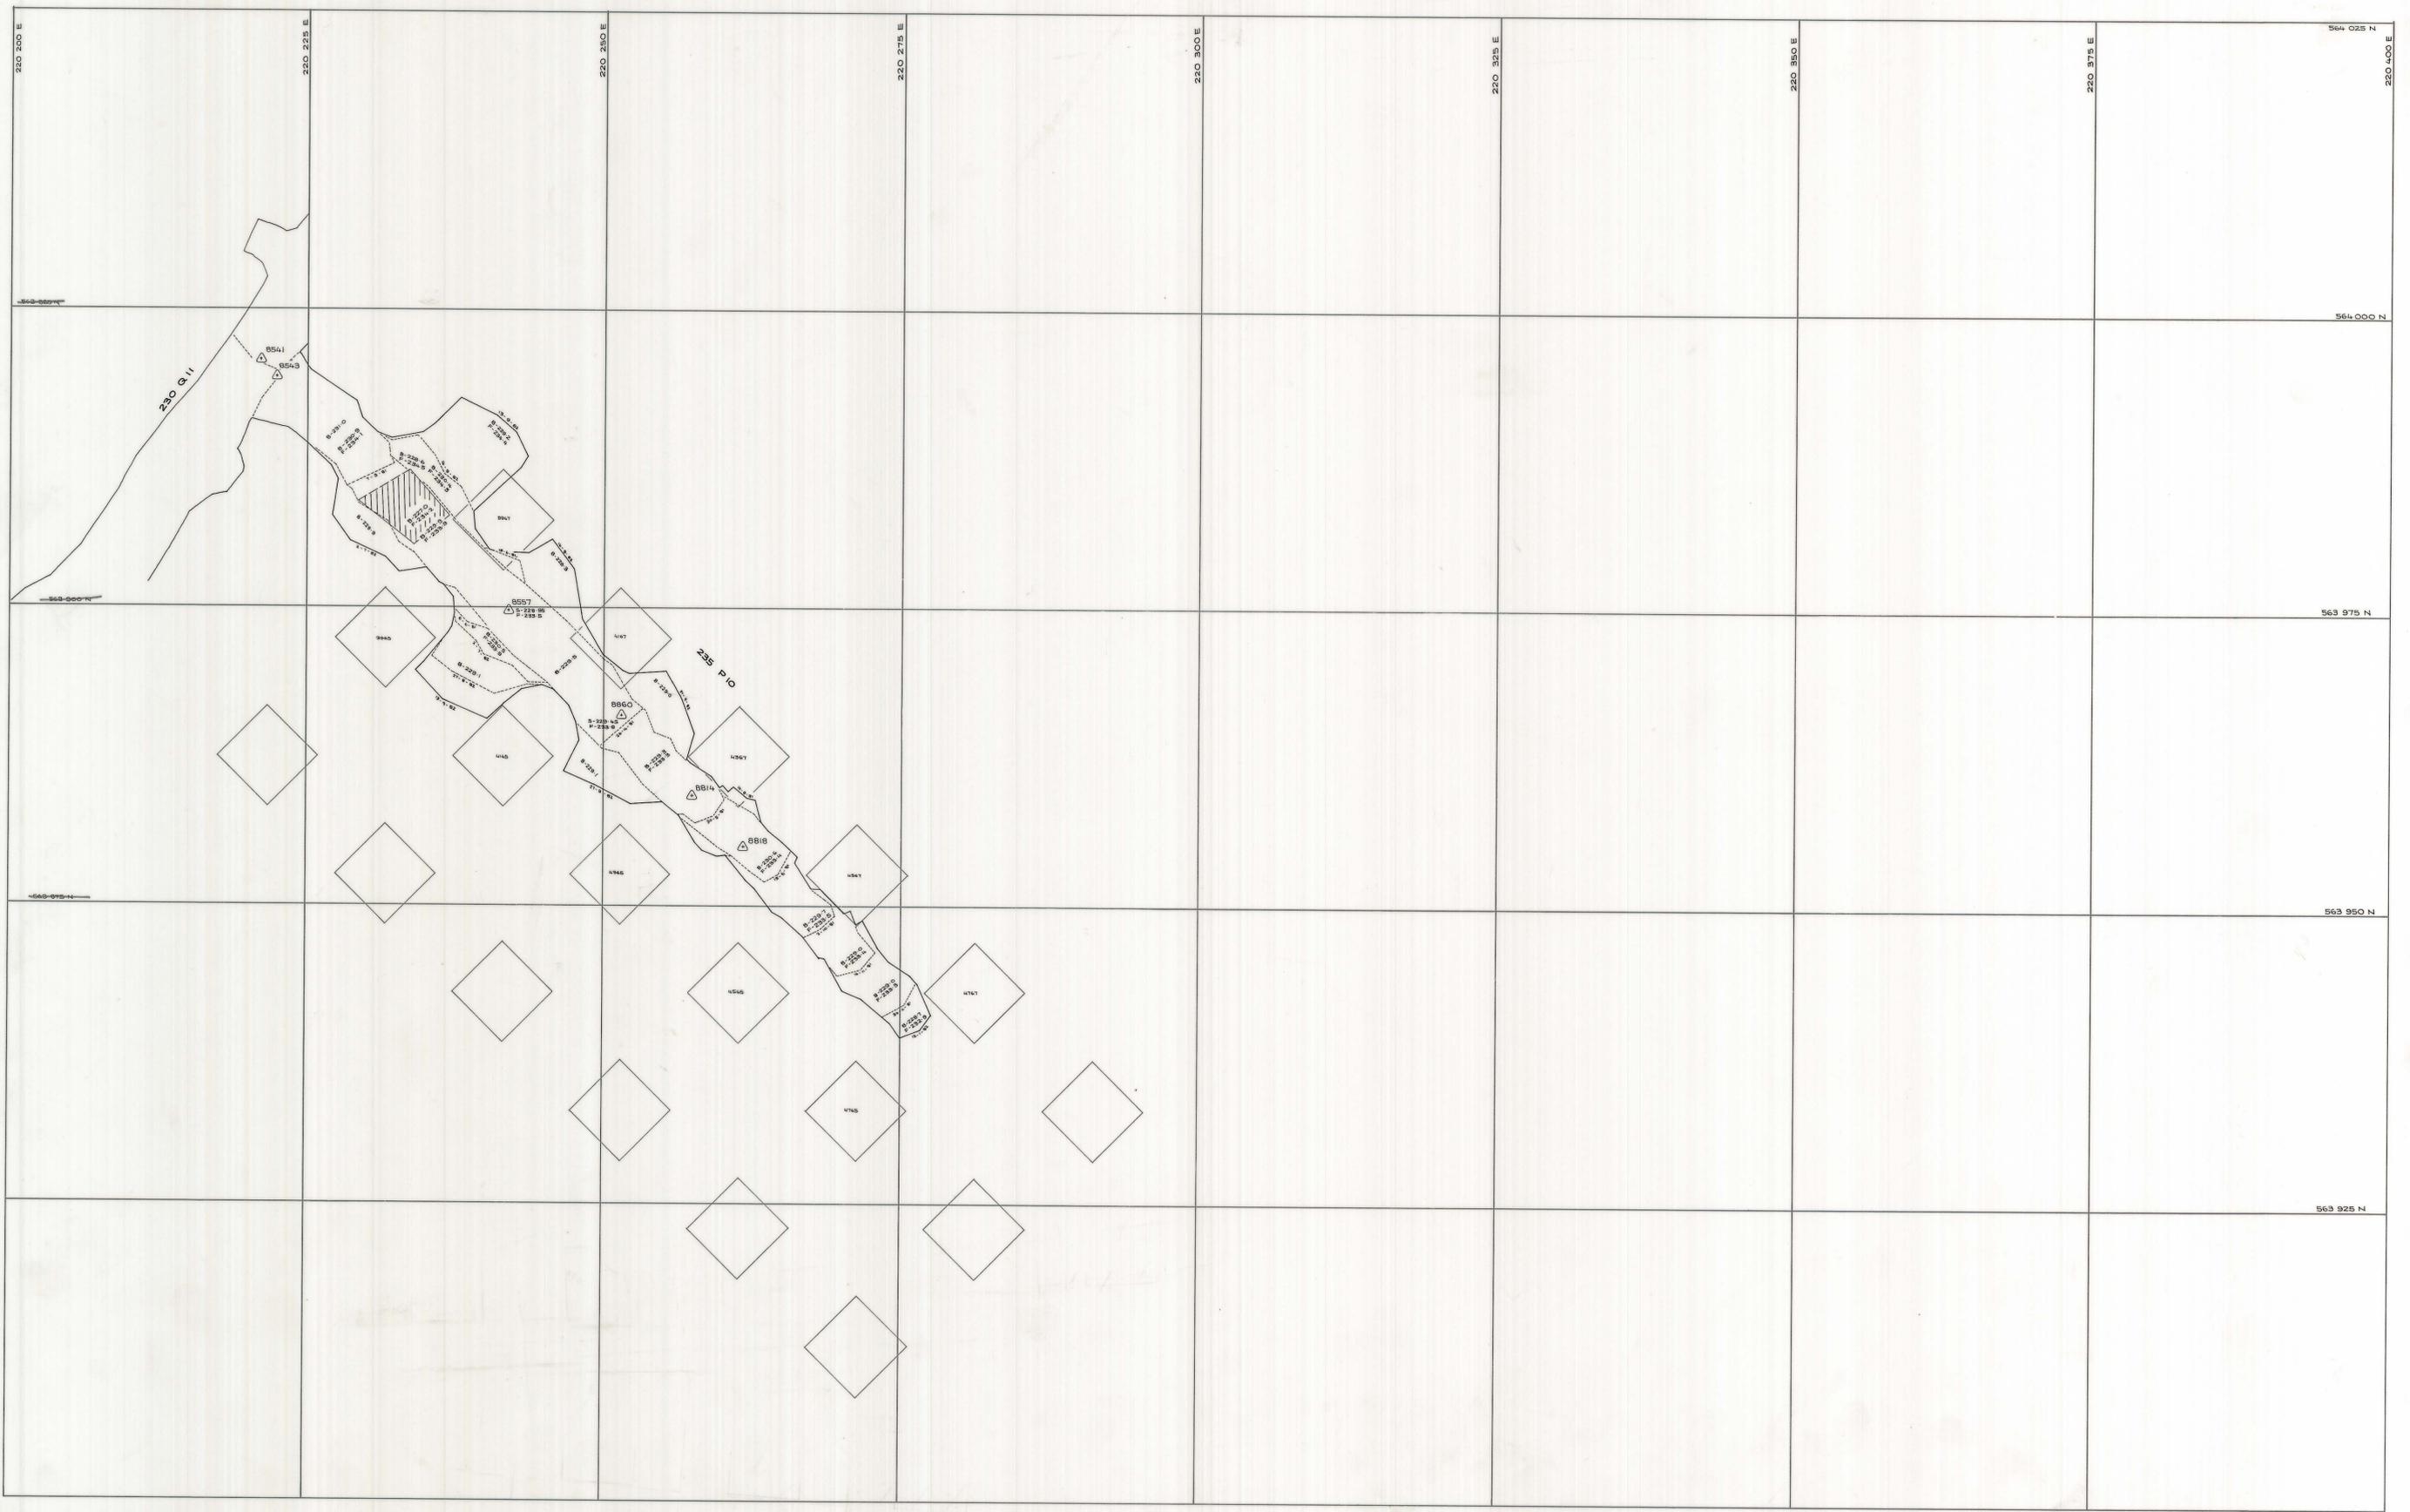

	<p>SCALE 1: 250</p>		<p>LOCATION DOLPHIN MINE</p> <p>SUBJECT LOWER CENTRAL STOPE - 235 P 10</p>	<p>GRASSY KING ISLAND</p> <p>PLAN NUMBER 04DM13 - 146 147</p>
--	---------------------	--	--	---