


04DM12 - 165 129S

MID WEDGE
RAMPS

0374 - 2154

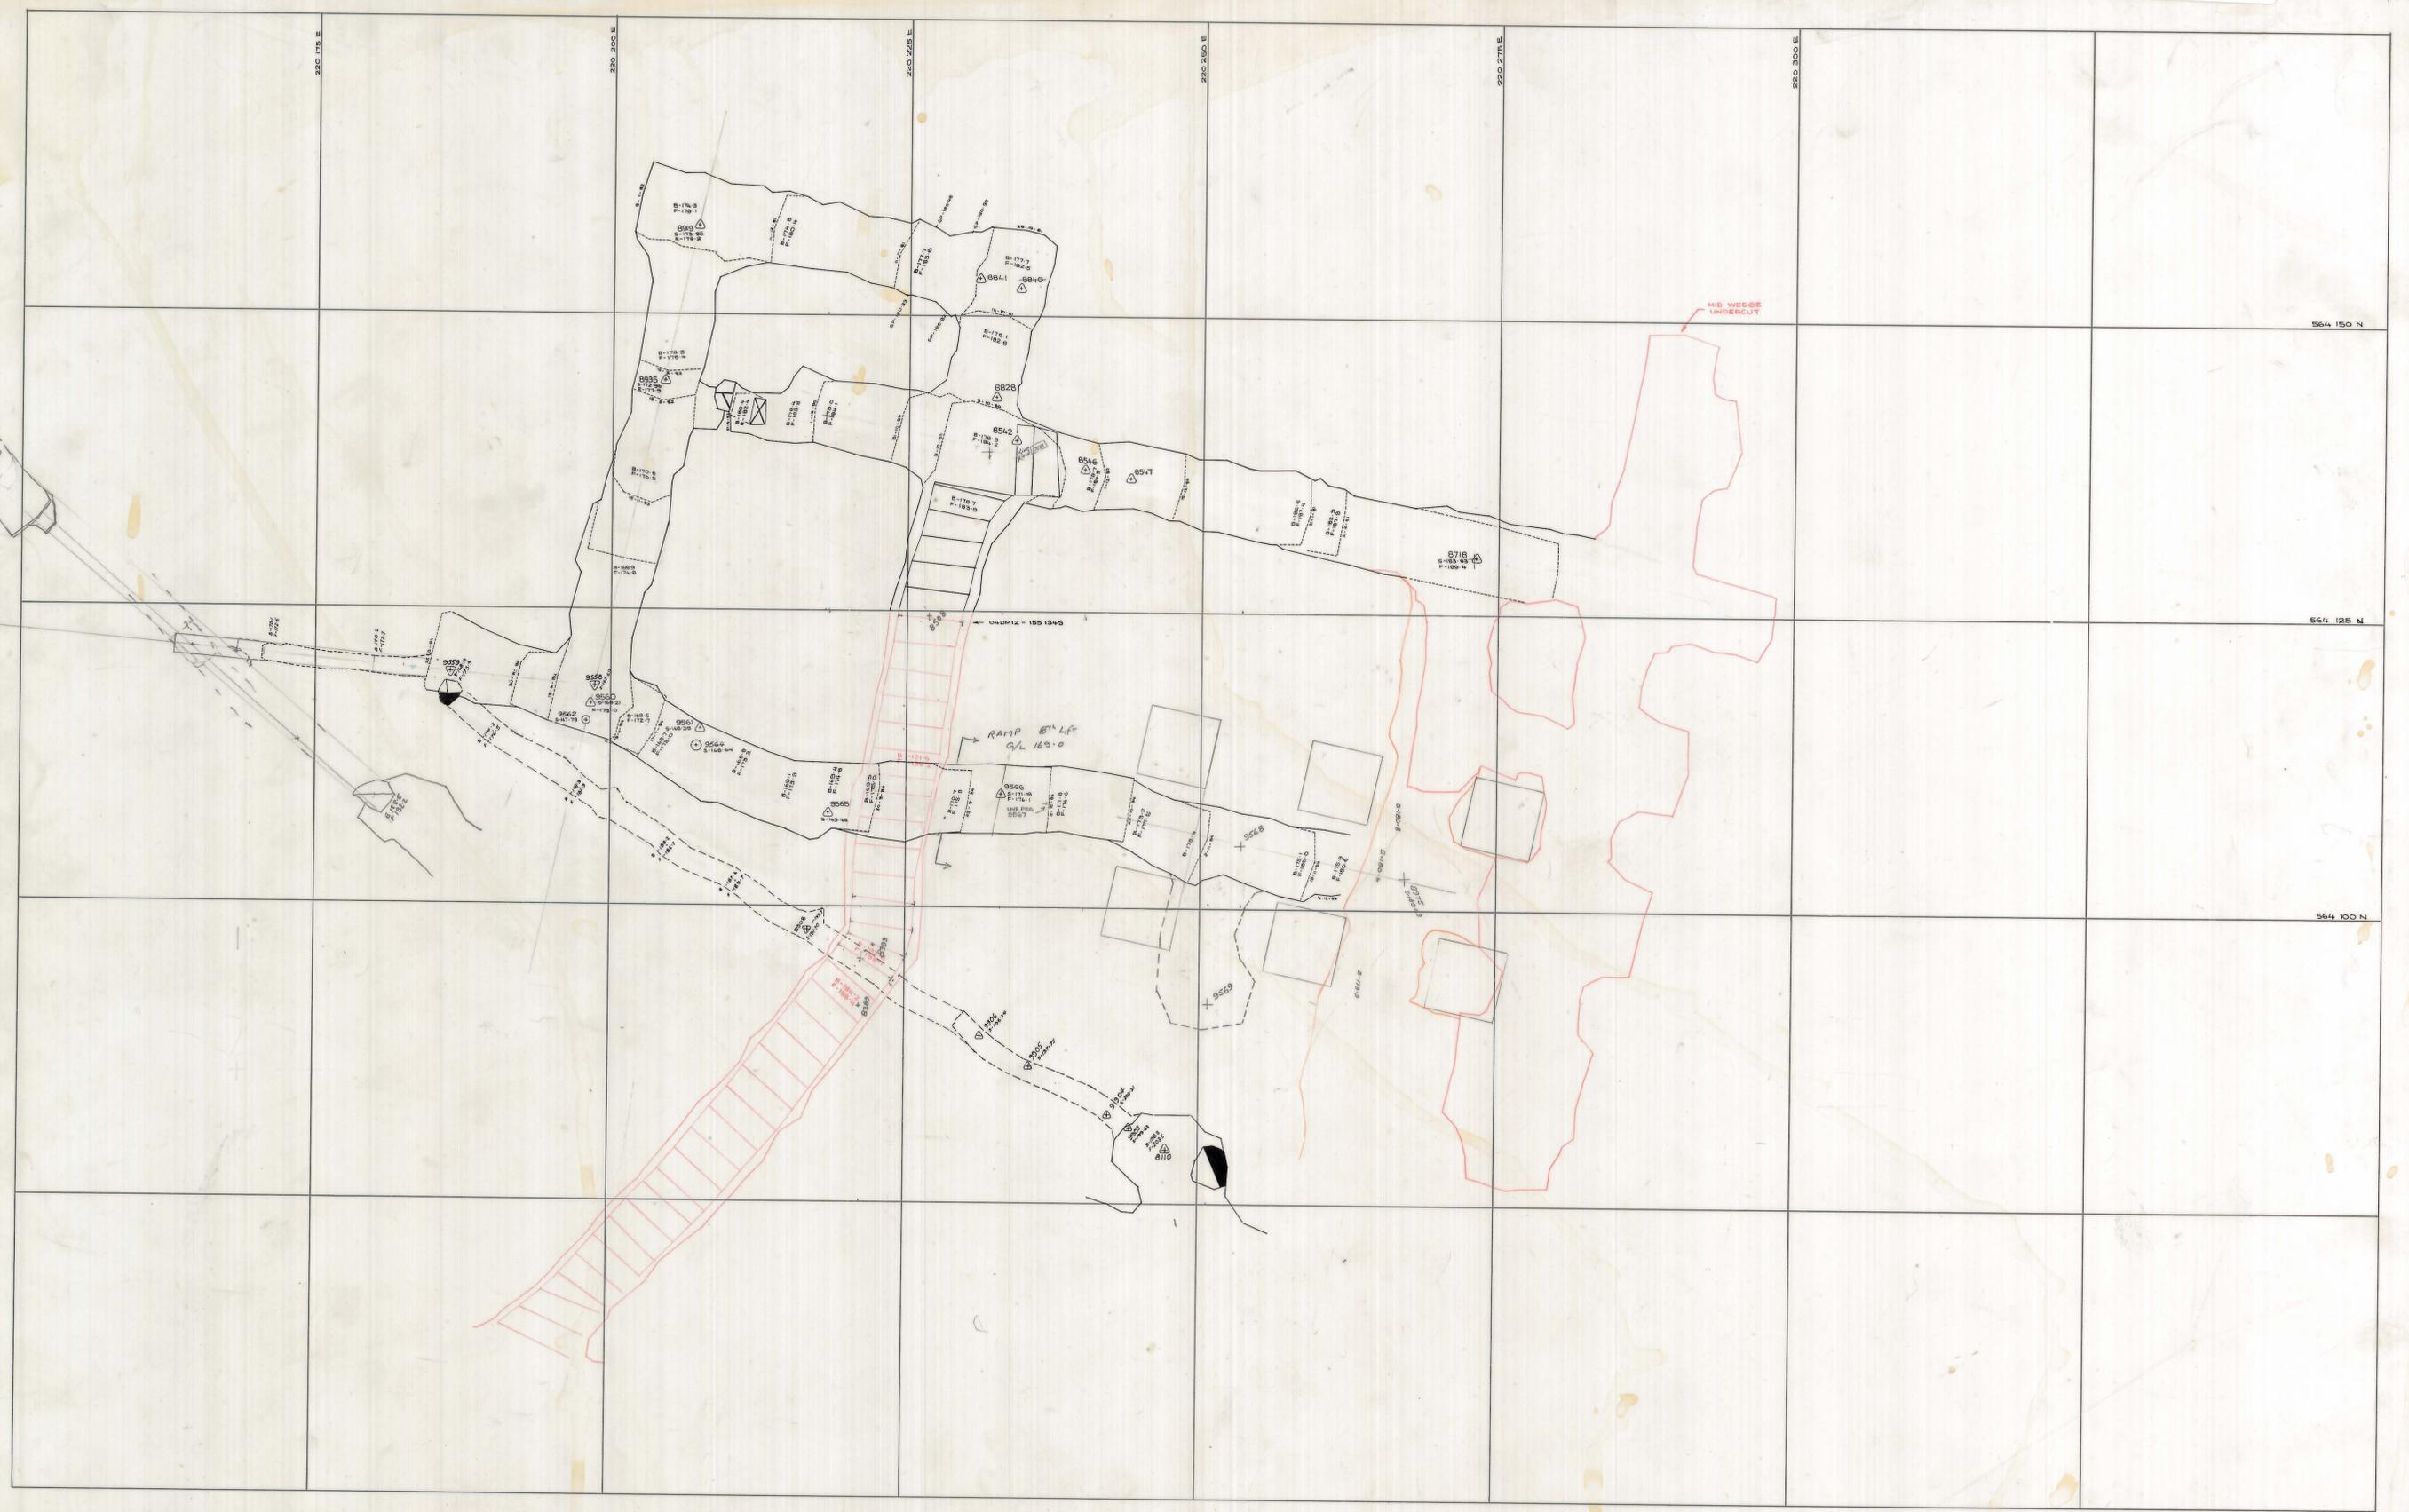

	<p>SCALE 1:250</p>		<p>LOCATION DOLPHIN MINE</p> <p>SUBJECT MID WEDGE STOPE ACCESS RAMPS</p>	<p>KING ISLAND SCHEELITE A DIVISION OF WARRMAX INTERNATIONAL</p> <p>GRASSY KING ISLAND</p> <p>Our mine PLAN NUMBER 04DM12 - 165 129S</p>
--	--------------------	--	--	--