


5 cm

27 JUN 1981

04DM12 - 146 142

0374\_2159

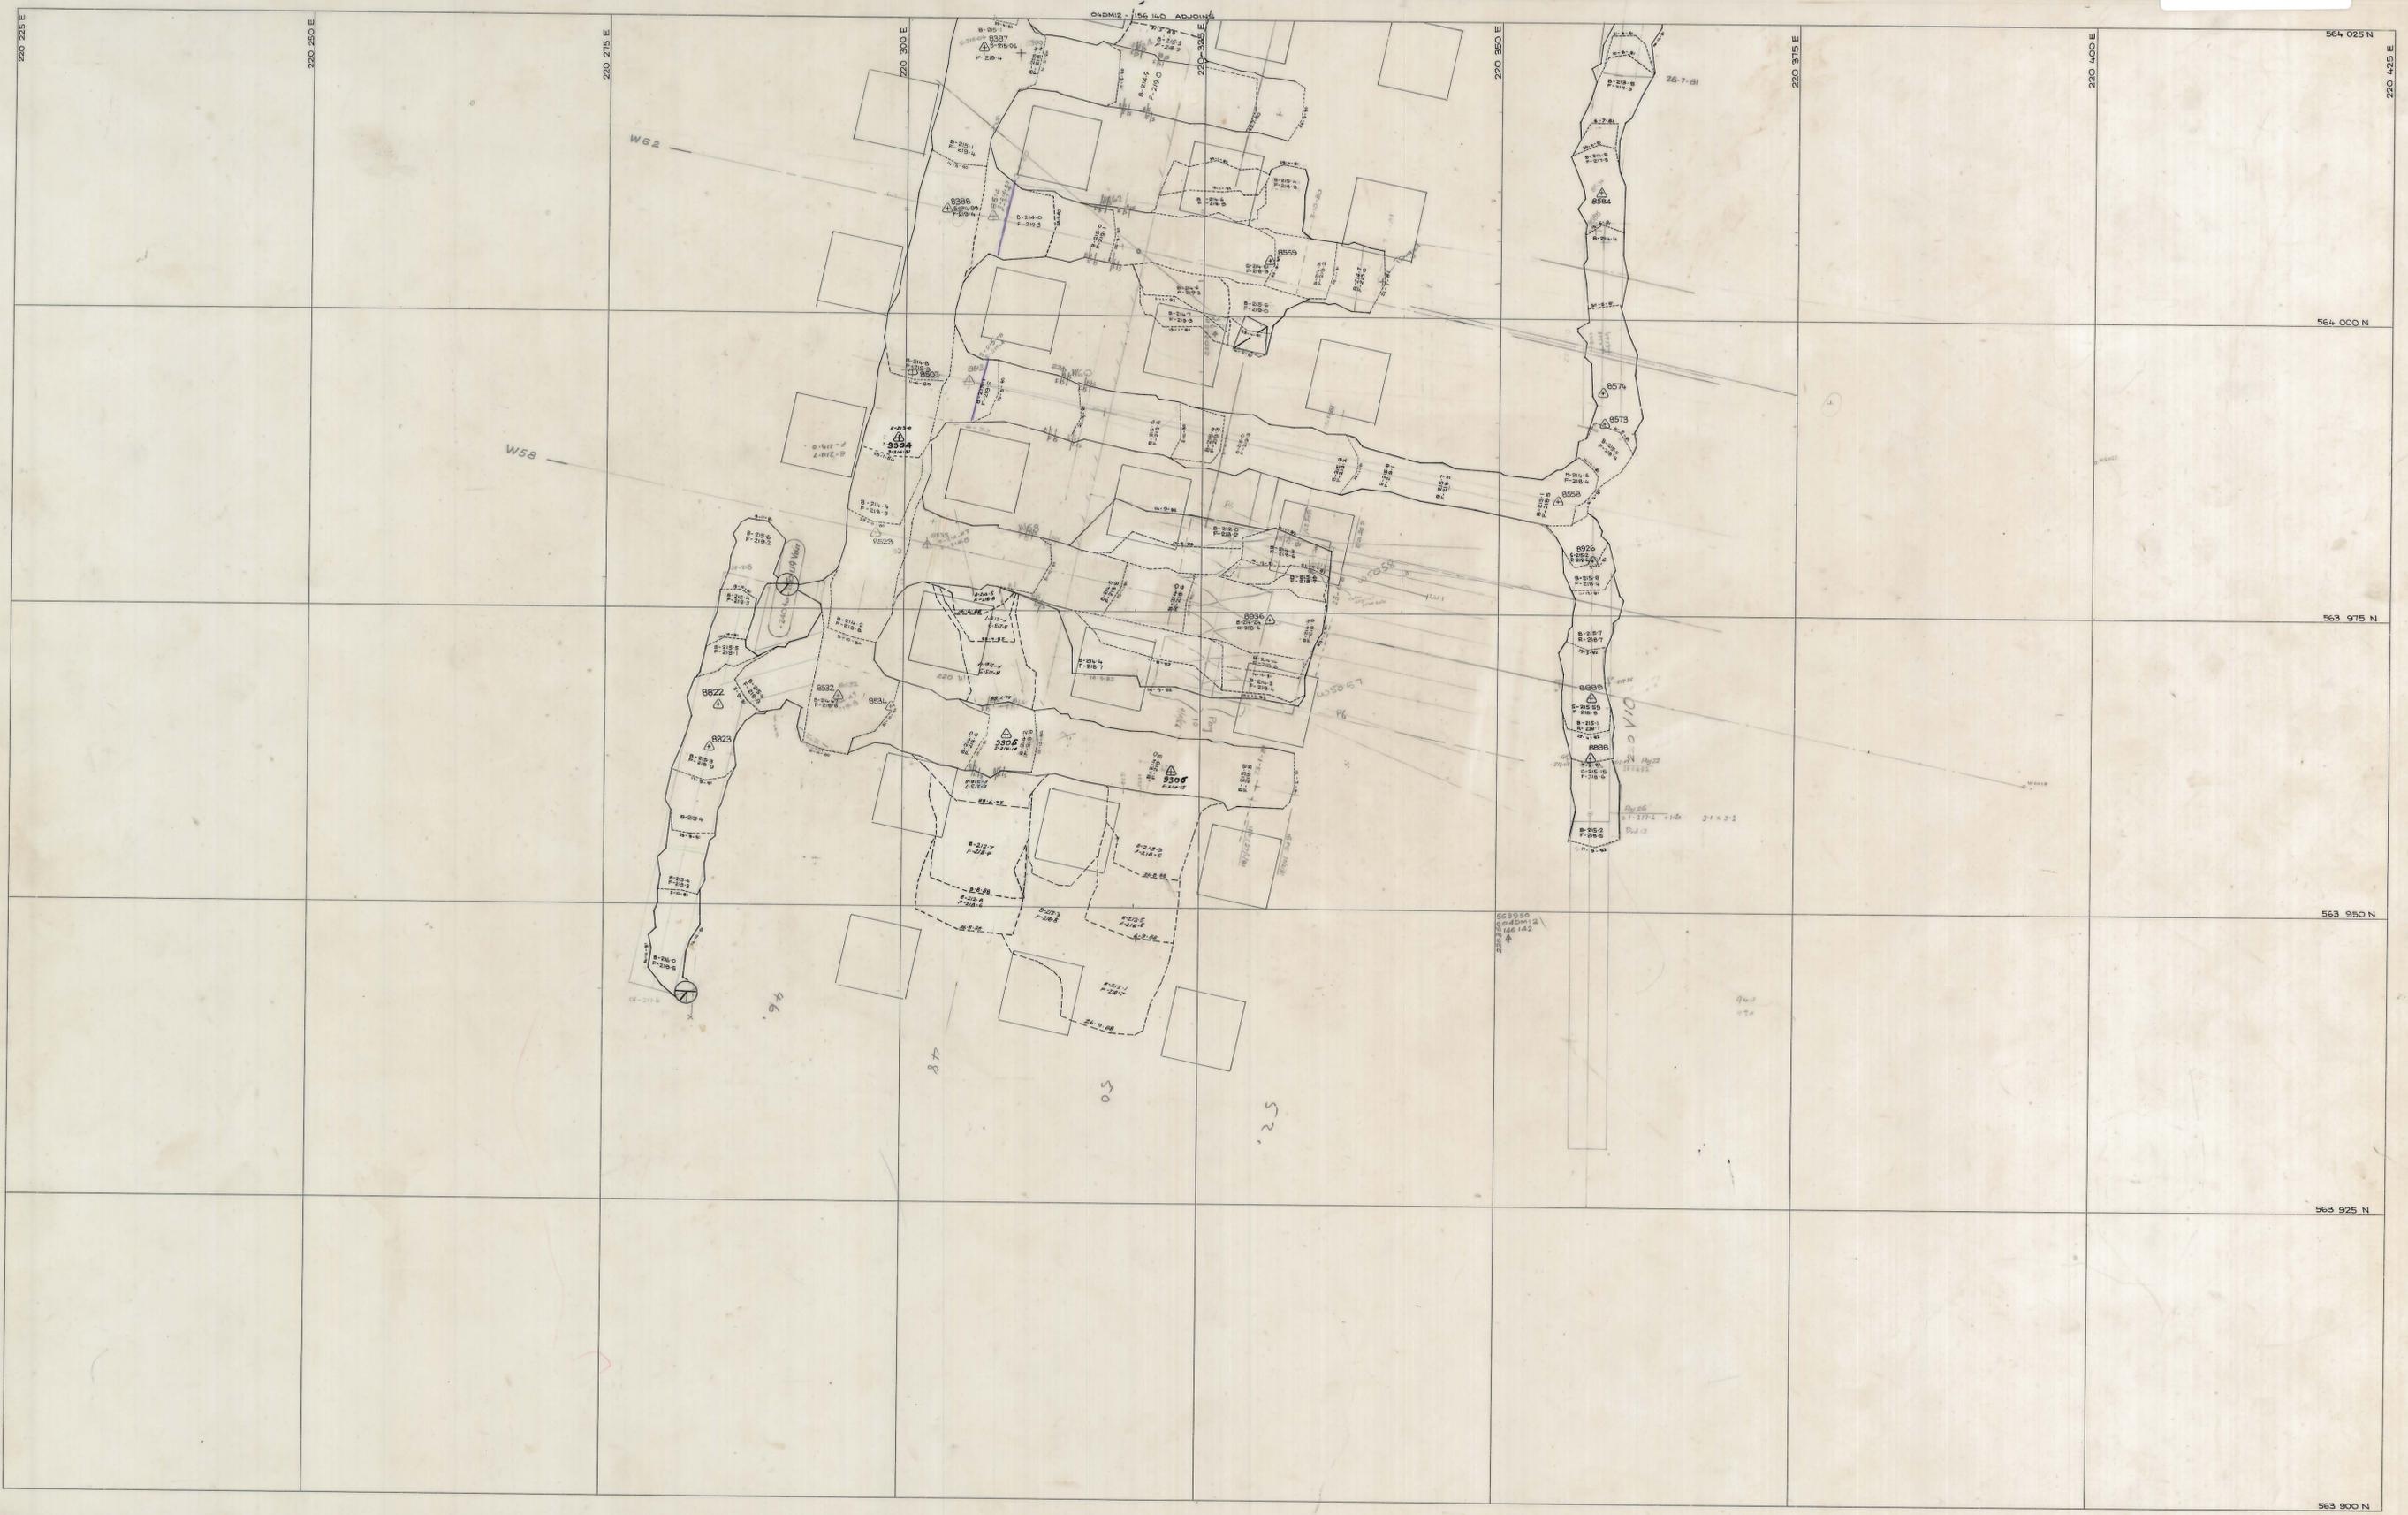

<p>SCALE 1:250</p> <p>0374_2159 118 W62 + 012</p> <p>north</p>	<p>LOCATION DOLPHIN MINE</p> <p>SUBJECT LOWER WEDGE STOPE ACCESS -220m ZONE</p>	<p><b>KIS</b> KING ISLAND SCHEELITE A DIVISION OF WARMAN INTERNATIONAL</p> <p>GRASSY KING ISLAND</p> <p>PLAN NUMBER 04DM12 - 146 142</p>
--	---	--