


5 cm

27 JUN 1982

04DM12 - 155 099

I 17

0374 - 2160

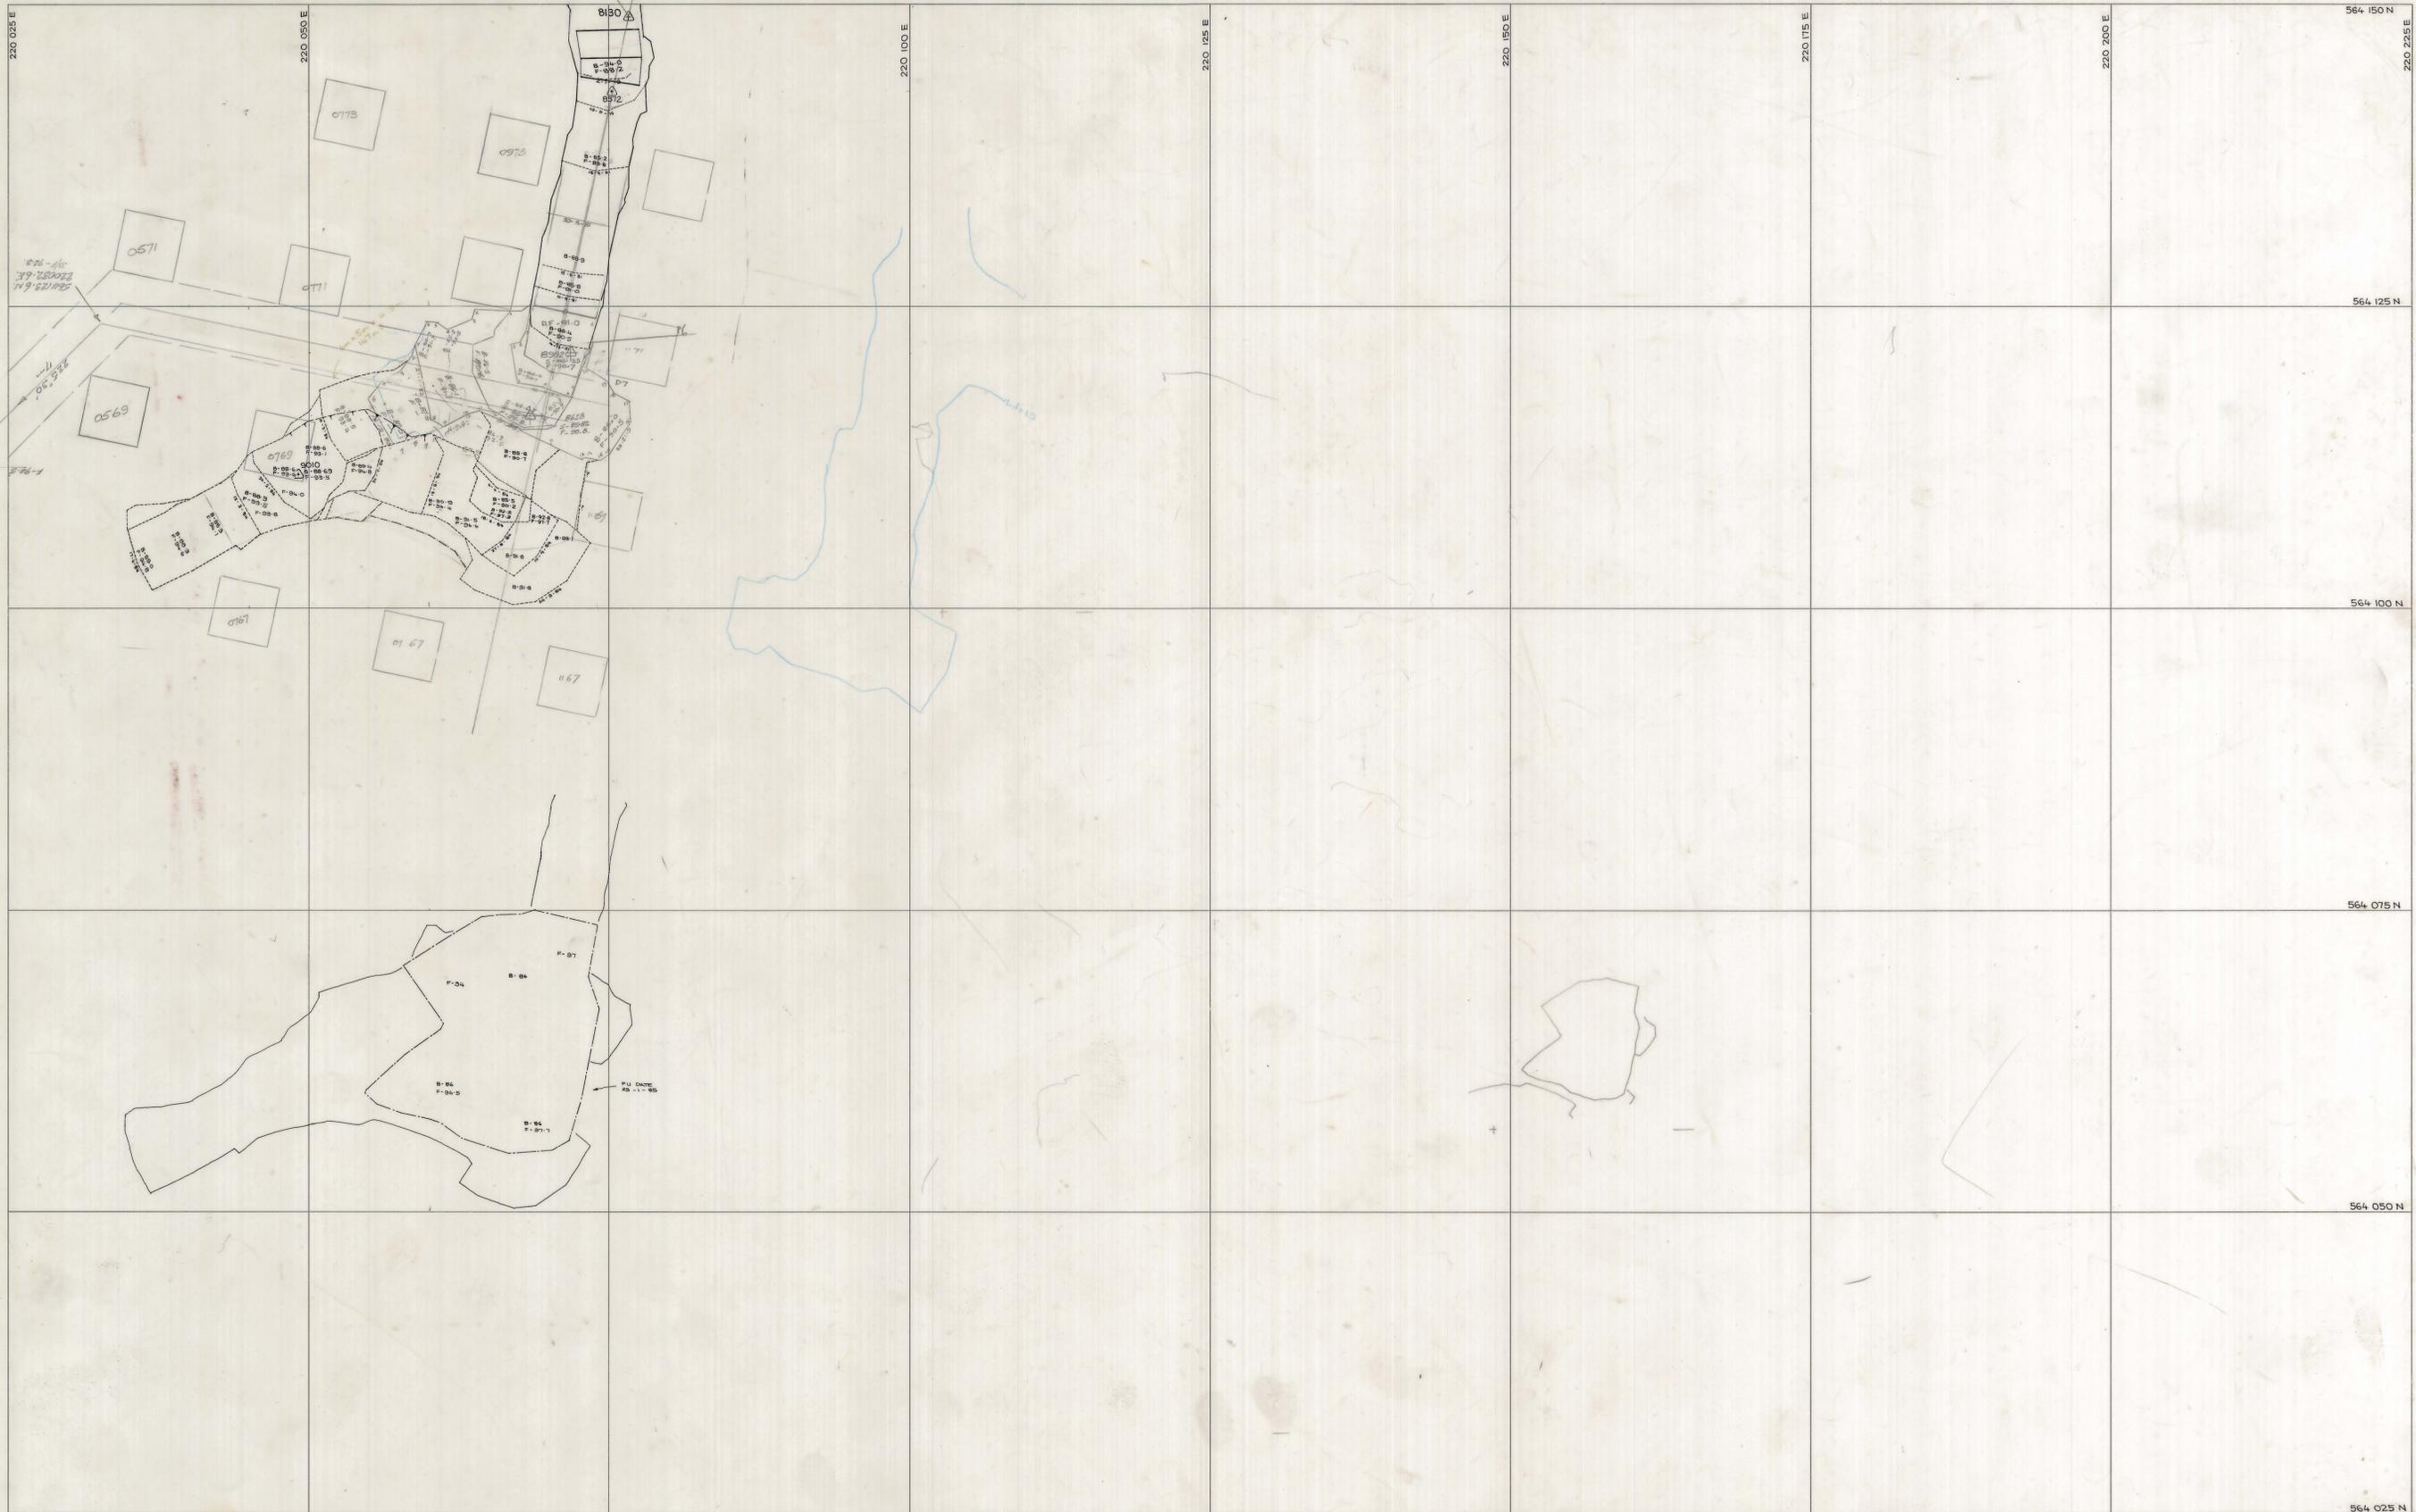

SCALE 1:250

LOCATION DOLPHIN MINE

SUBJECT I 17  
ACCESS TO C CENTRAL



PLAN NUMBER 04DM12 - 155 099

north