




0374-2162

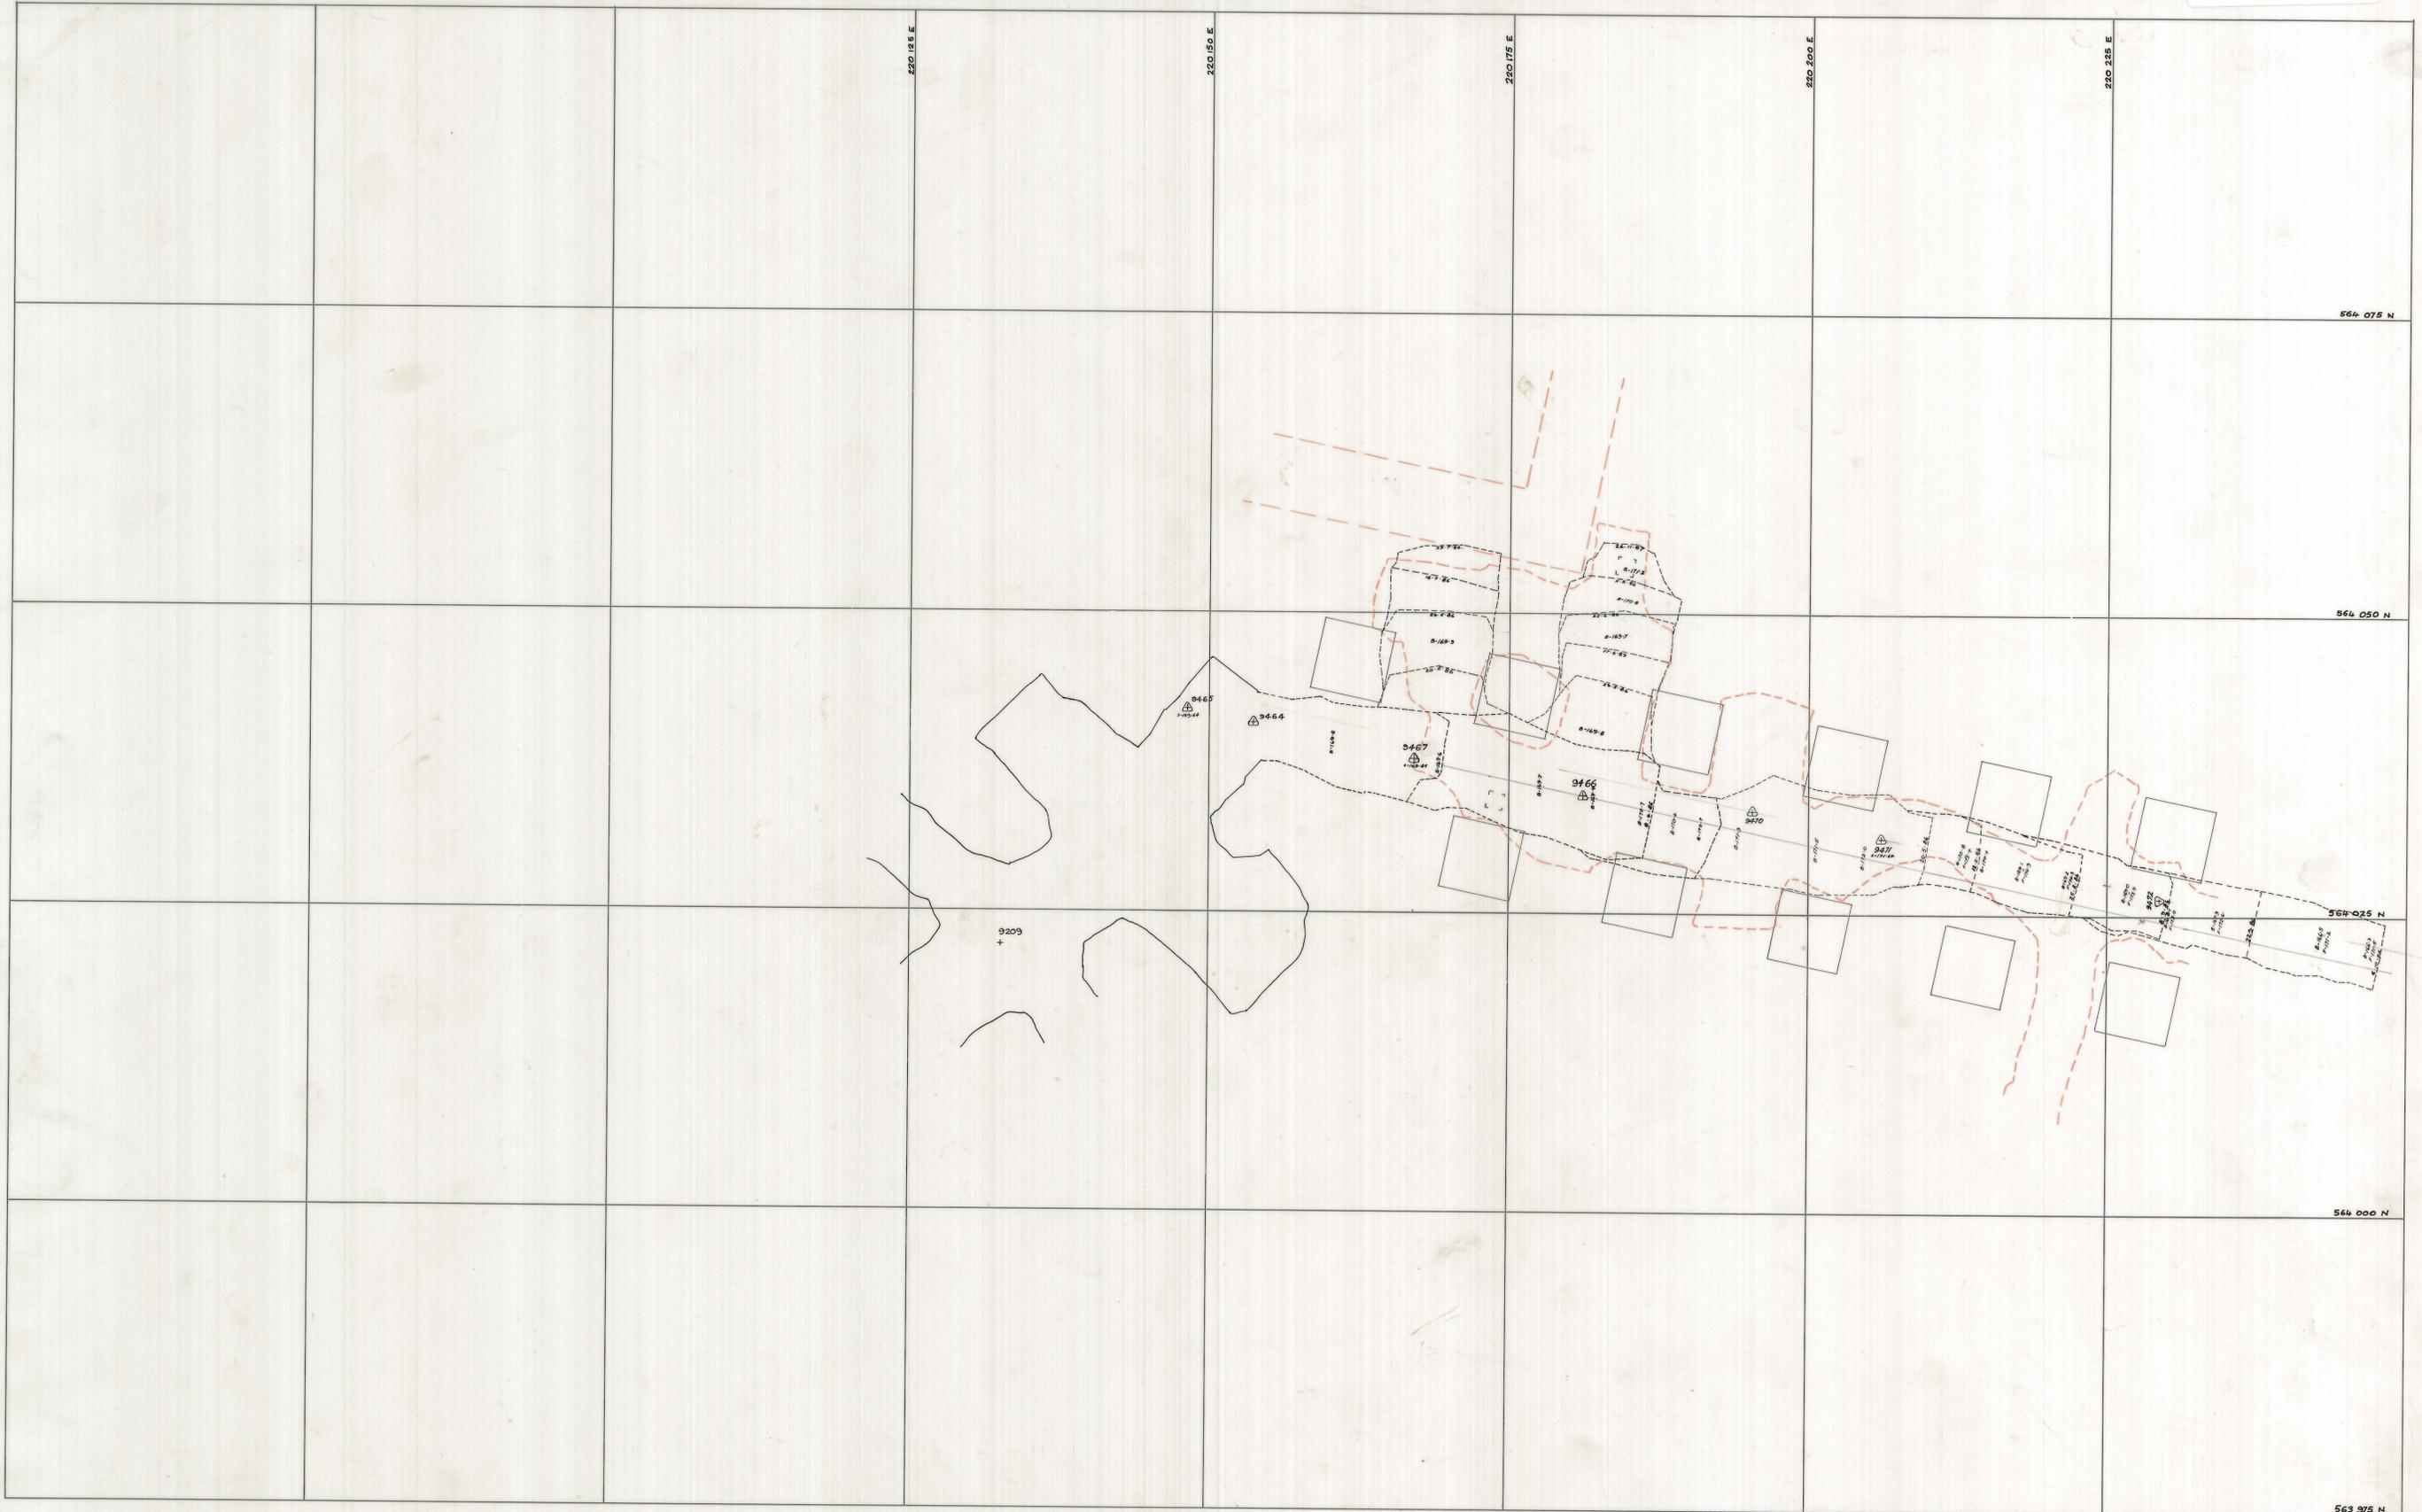

|  |                    |  |  |   |
|--|--------------------|--|--|---|
|  | <p>SCALE 1:250</p> |  | <p>LOCATION</p> <p>SUBJECT</p> <p><b>MID CENTRAL</b></p> <p>-173.5m RL LIFT N°</p> | <p><b>KING ISLAND SCHEELITE</b><br/>A DIVISION OF WARMAN INTERNATIONAL</p> <p>GRASSY KING ISLAND</p> <p>PLAN NUMBER</p> |
|--|--------------------|--|--|---|