
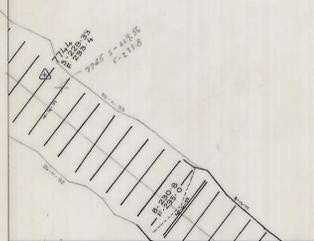


27 JUN 1981

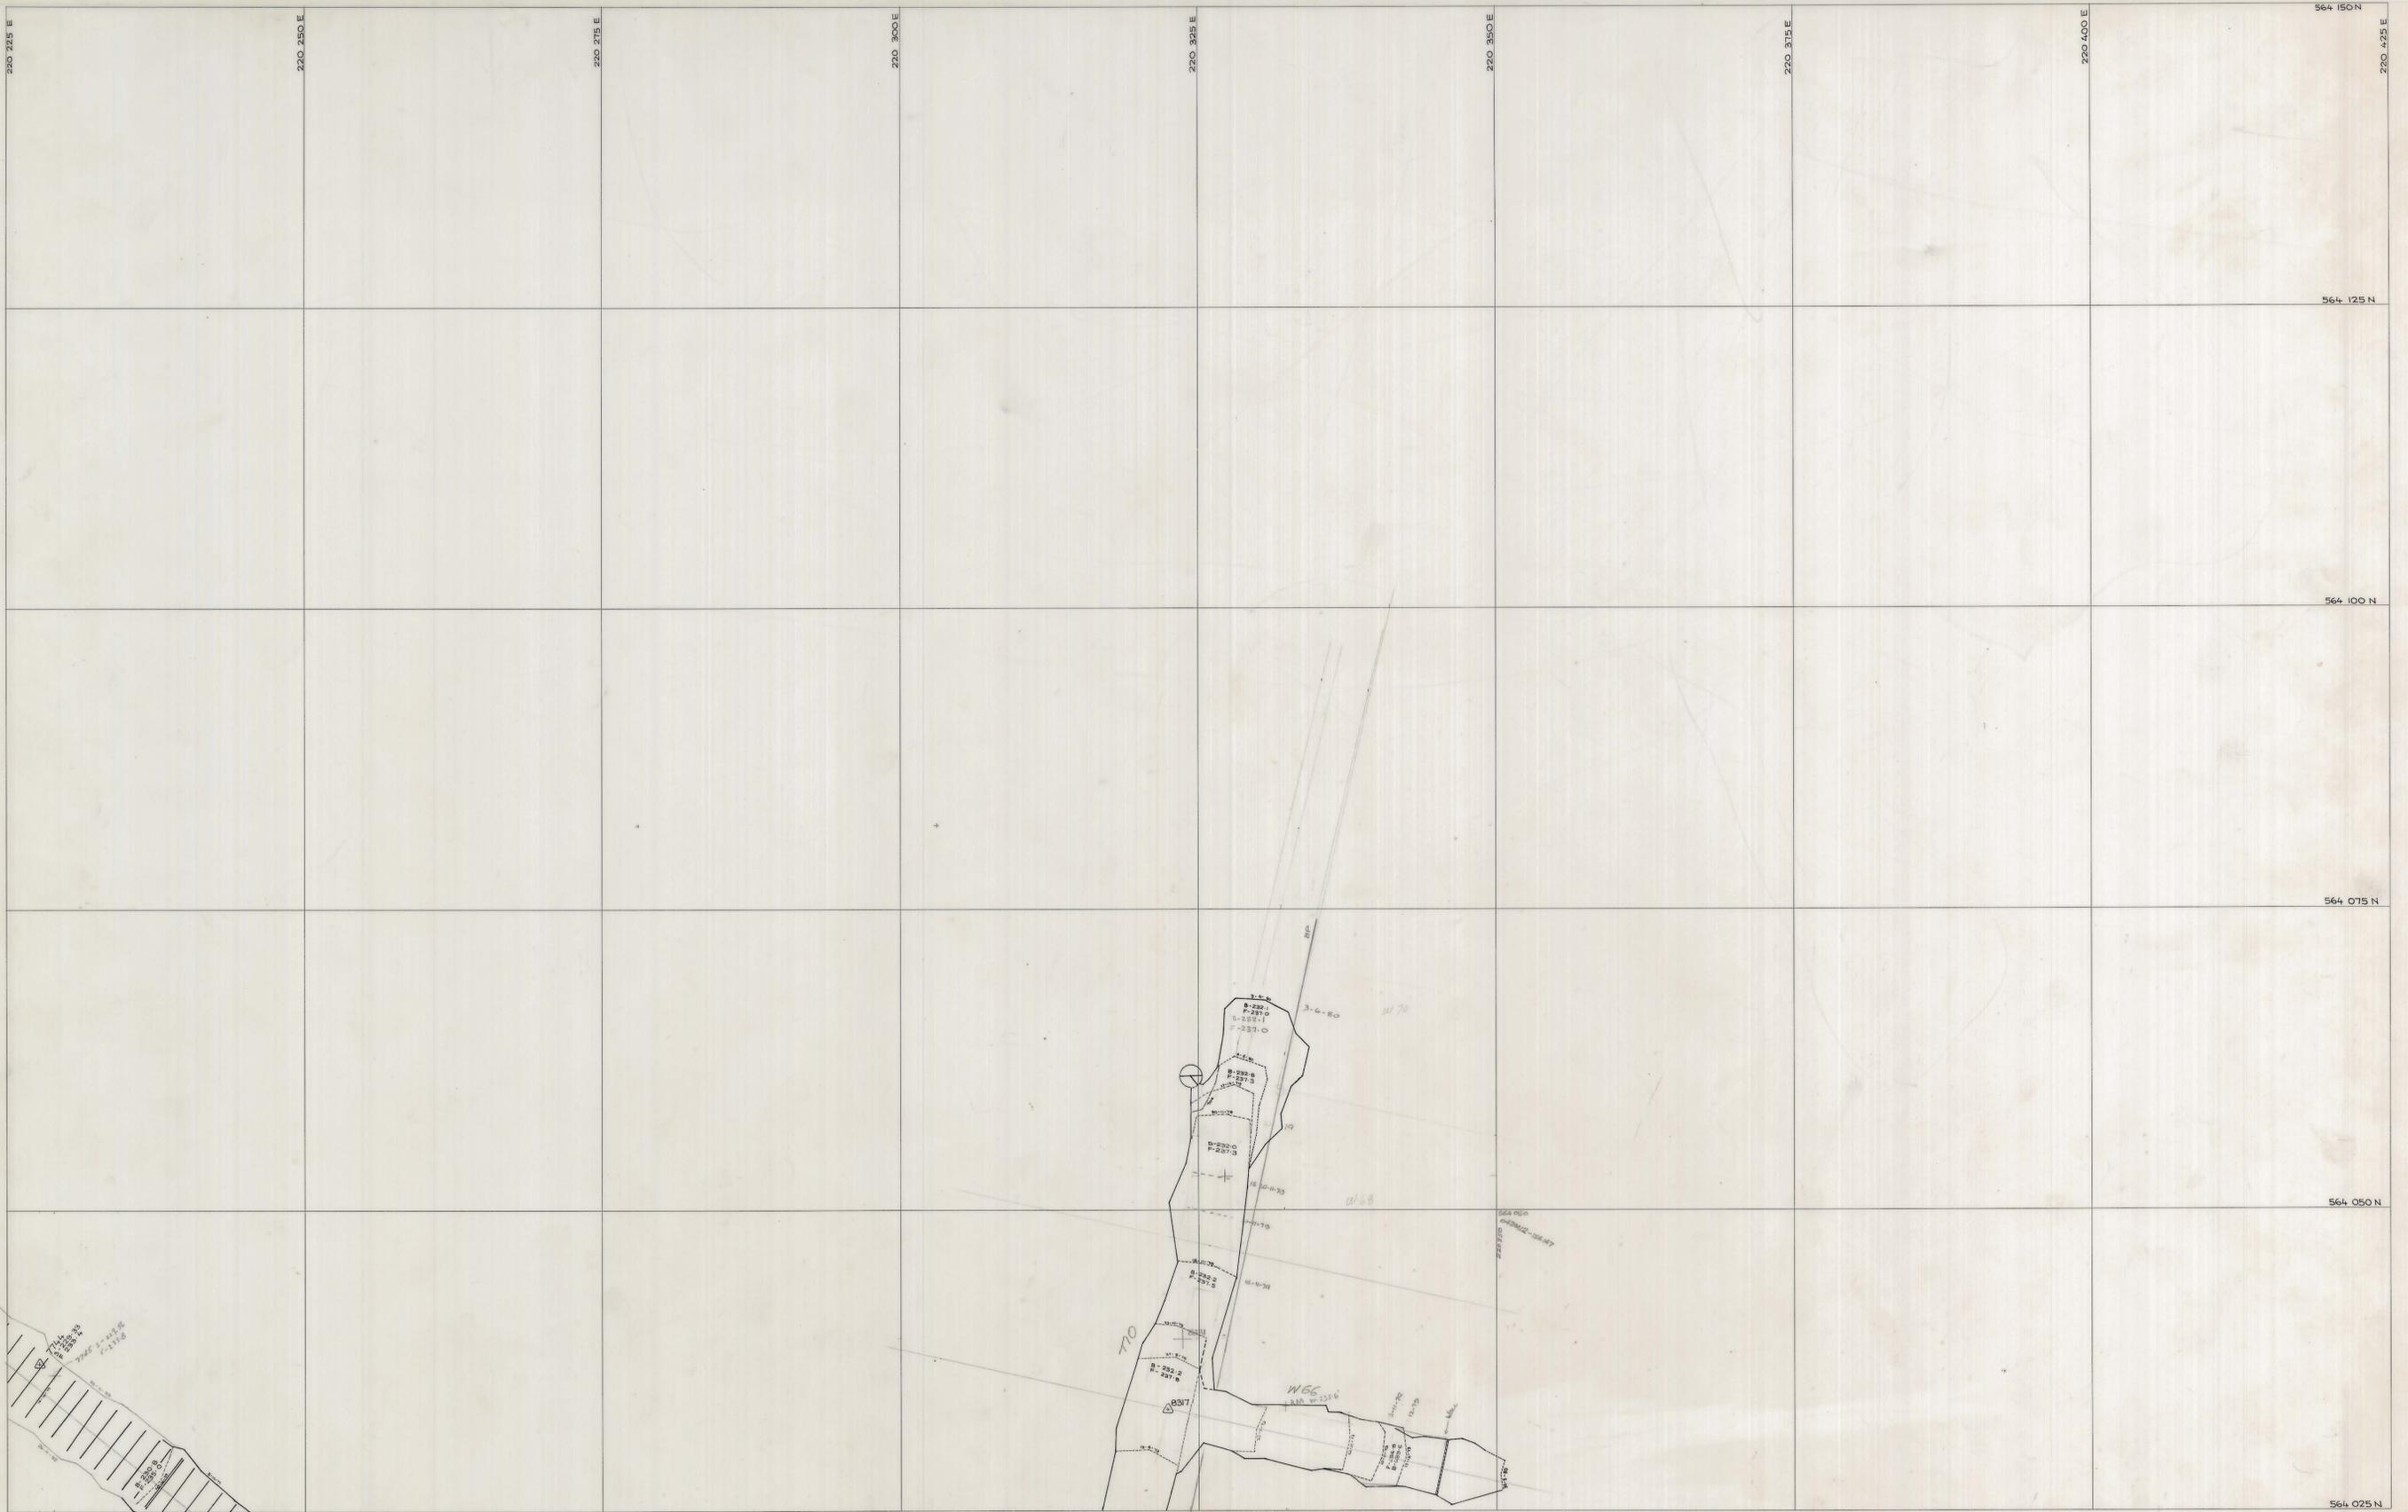

04DM12-156147 adj. 01/81

SCALE 1:250

north

LOCATION DOLPHIN MINE
 SUBJECT MAIN DECLINE

KIS KING ISLAND SCHEELITE
 A DIVISION OF WARMAN INTERNATIONAL
 GRASSY KING ISLAND
 PLAN NUMBER 04DM12 - 156 147