




27 JUN 1981

04DM12-145138 S


PIT STOPE ACCESS
N13 N7
07 P7

0374-2167

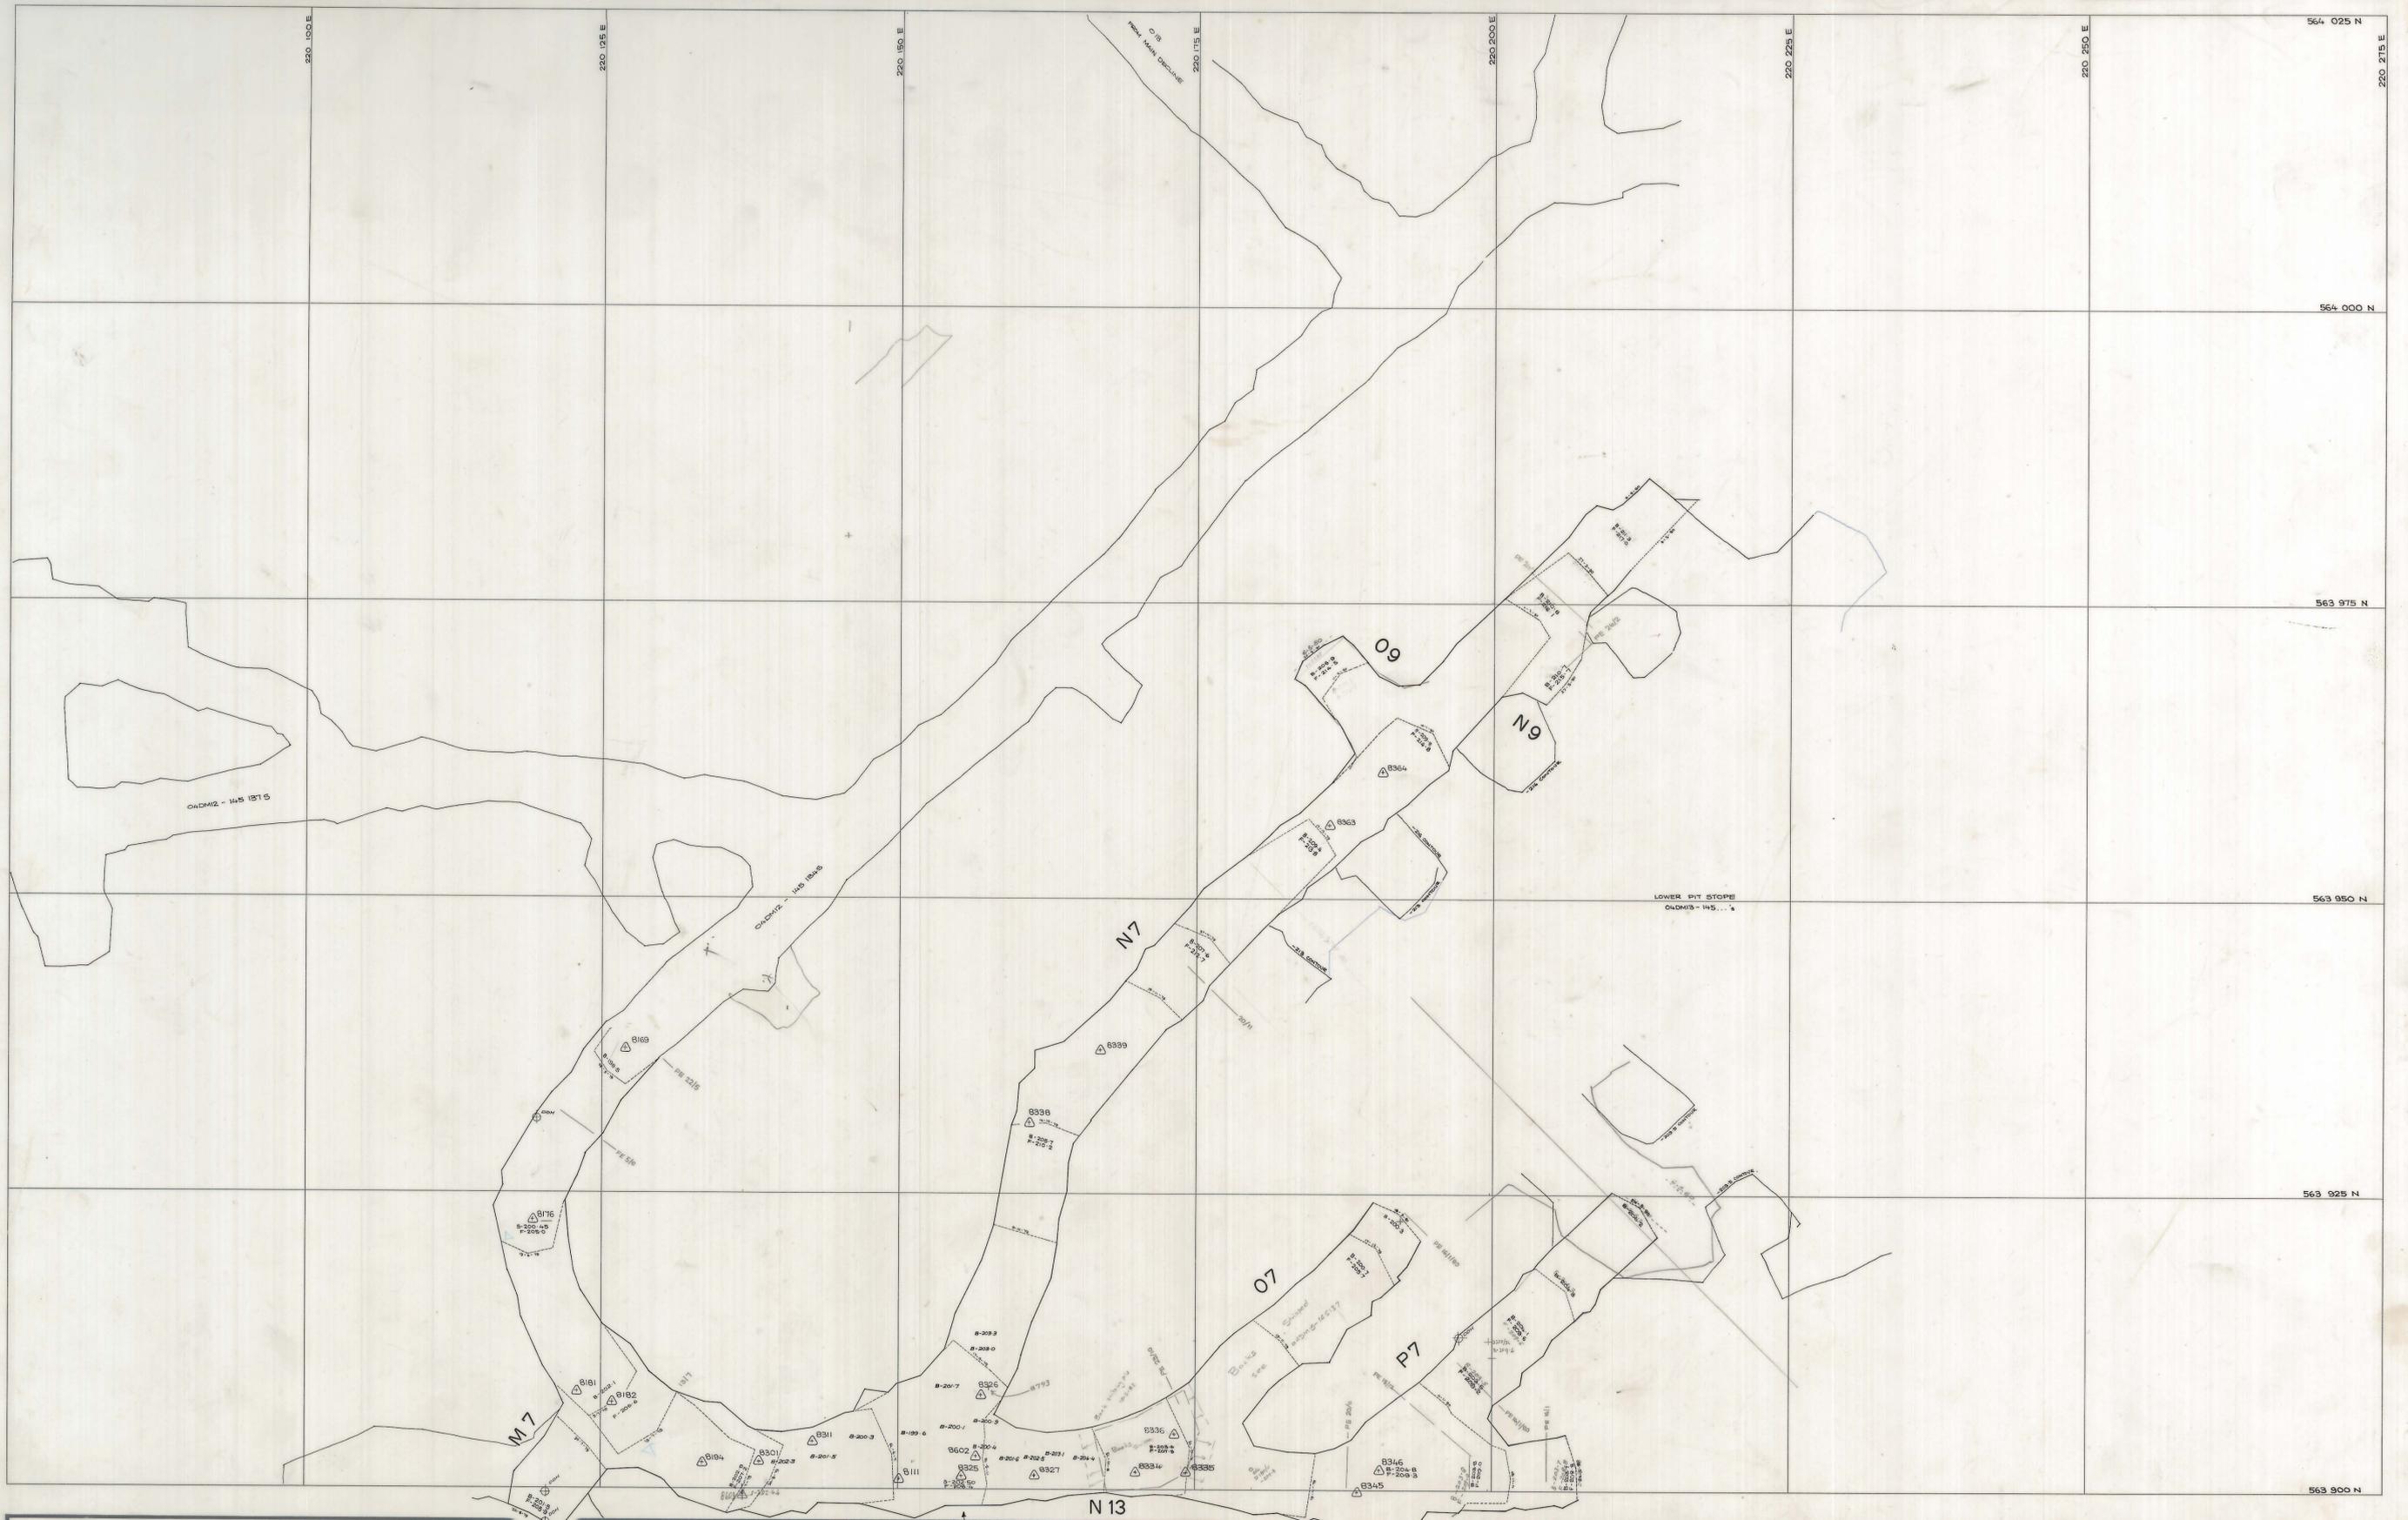

BACK HEIGHTS ALTERED
DUE TO ROCKFALL AND
SLIPPINGS
SLOPING 8/15 DATE 8/1-8

SCALE 1:

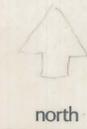

LOCATION

SUBJECT

PIT STOPE ACCESS
N 13 , N7 , O7 , P7

GRASSY KING ISLAND

PLAN NUMBER

04DM12 - 145 138 S