
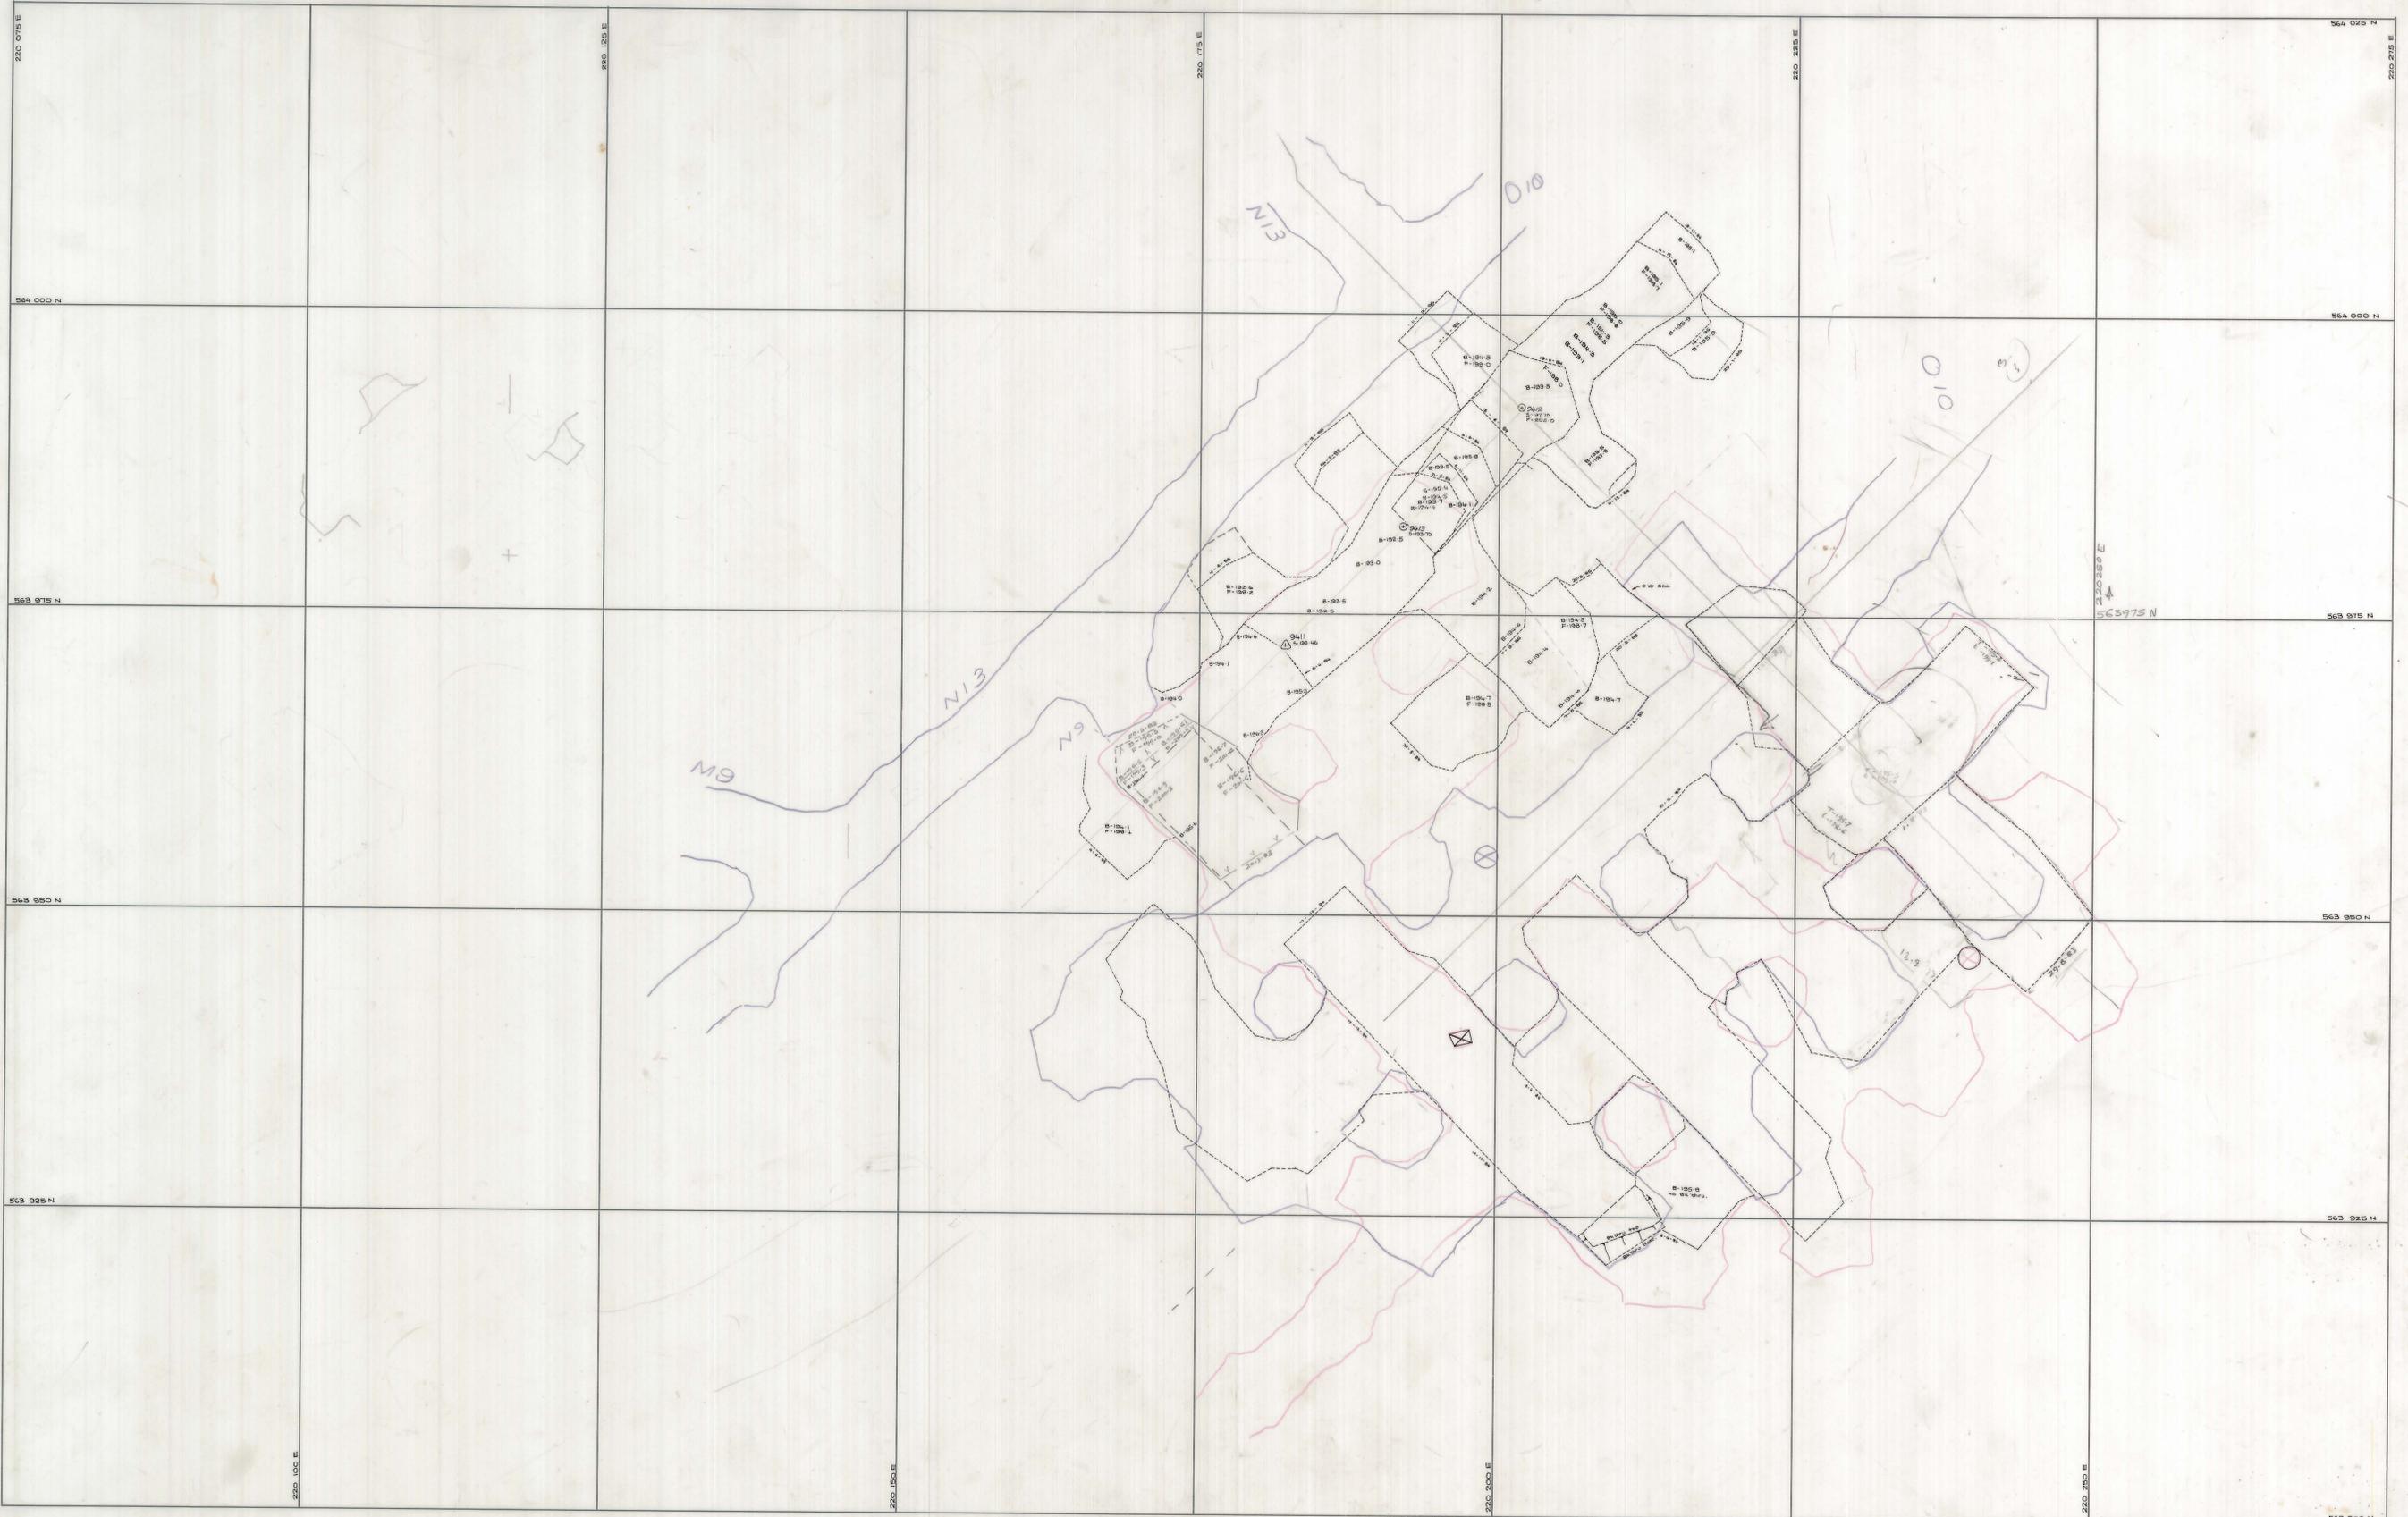


04DM13 - 145 136

L/PIT
LIFT 8

0374 _ 2168

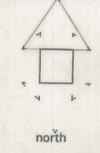

	SCALE 1:250	 north	LOCATION DOLPHIN MINE	 KING ISLAND SCHEELITE A DIVISION OF WARMAN INTERNATIONAL GRASSY KING ISLAND
			SUBJECT O10 / LOWER PIT lift 7 CROWN PILLAR Lift 8	