
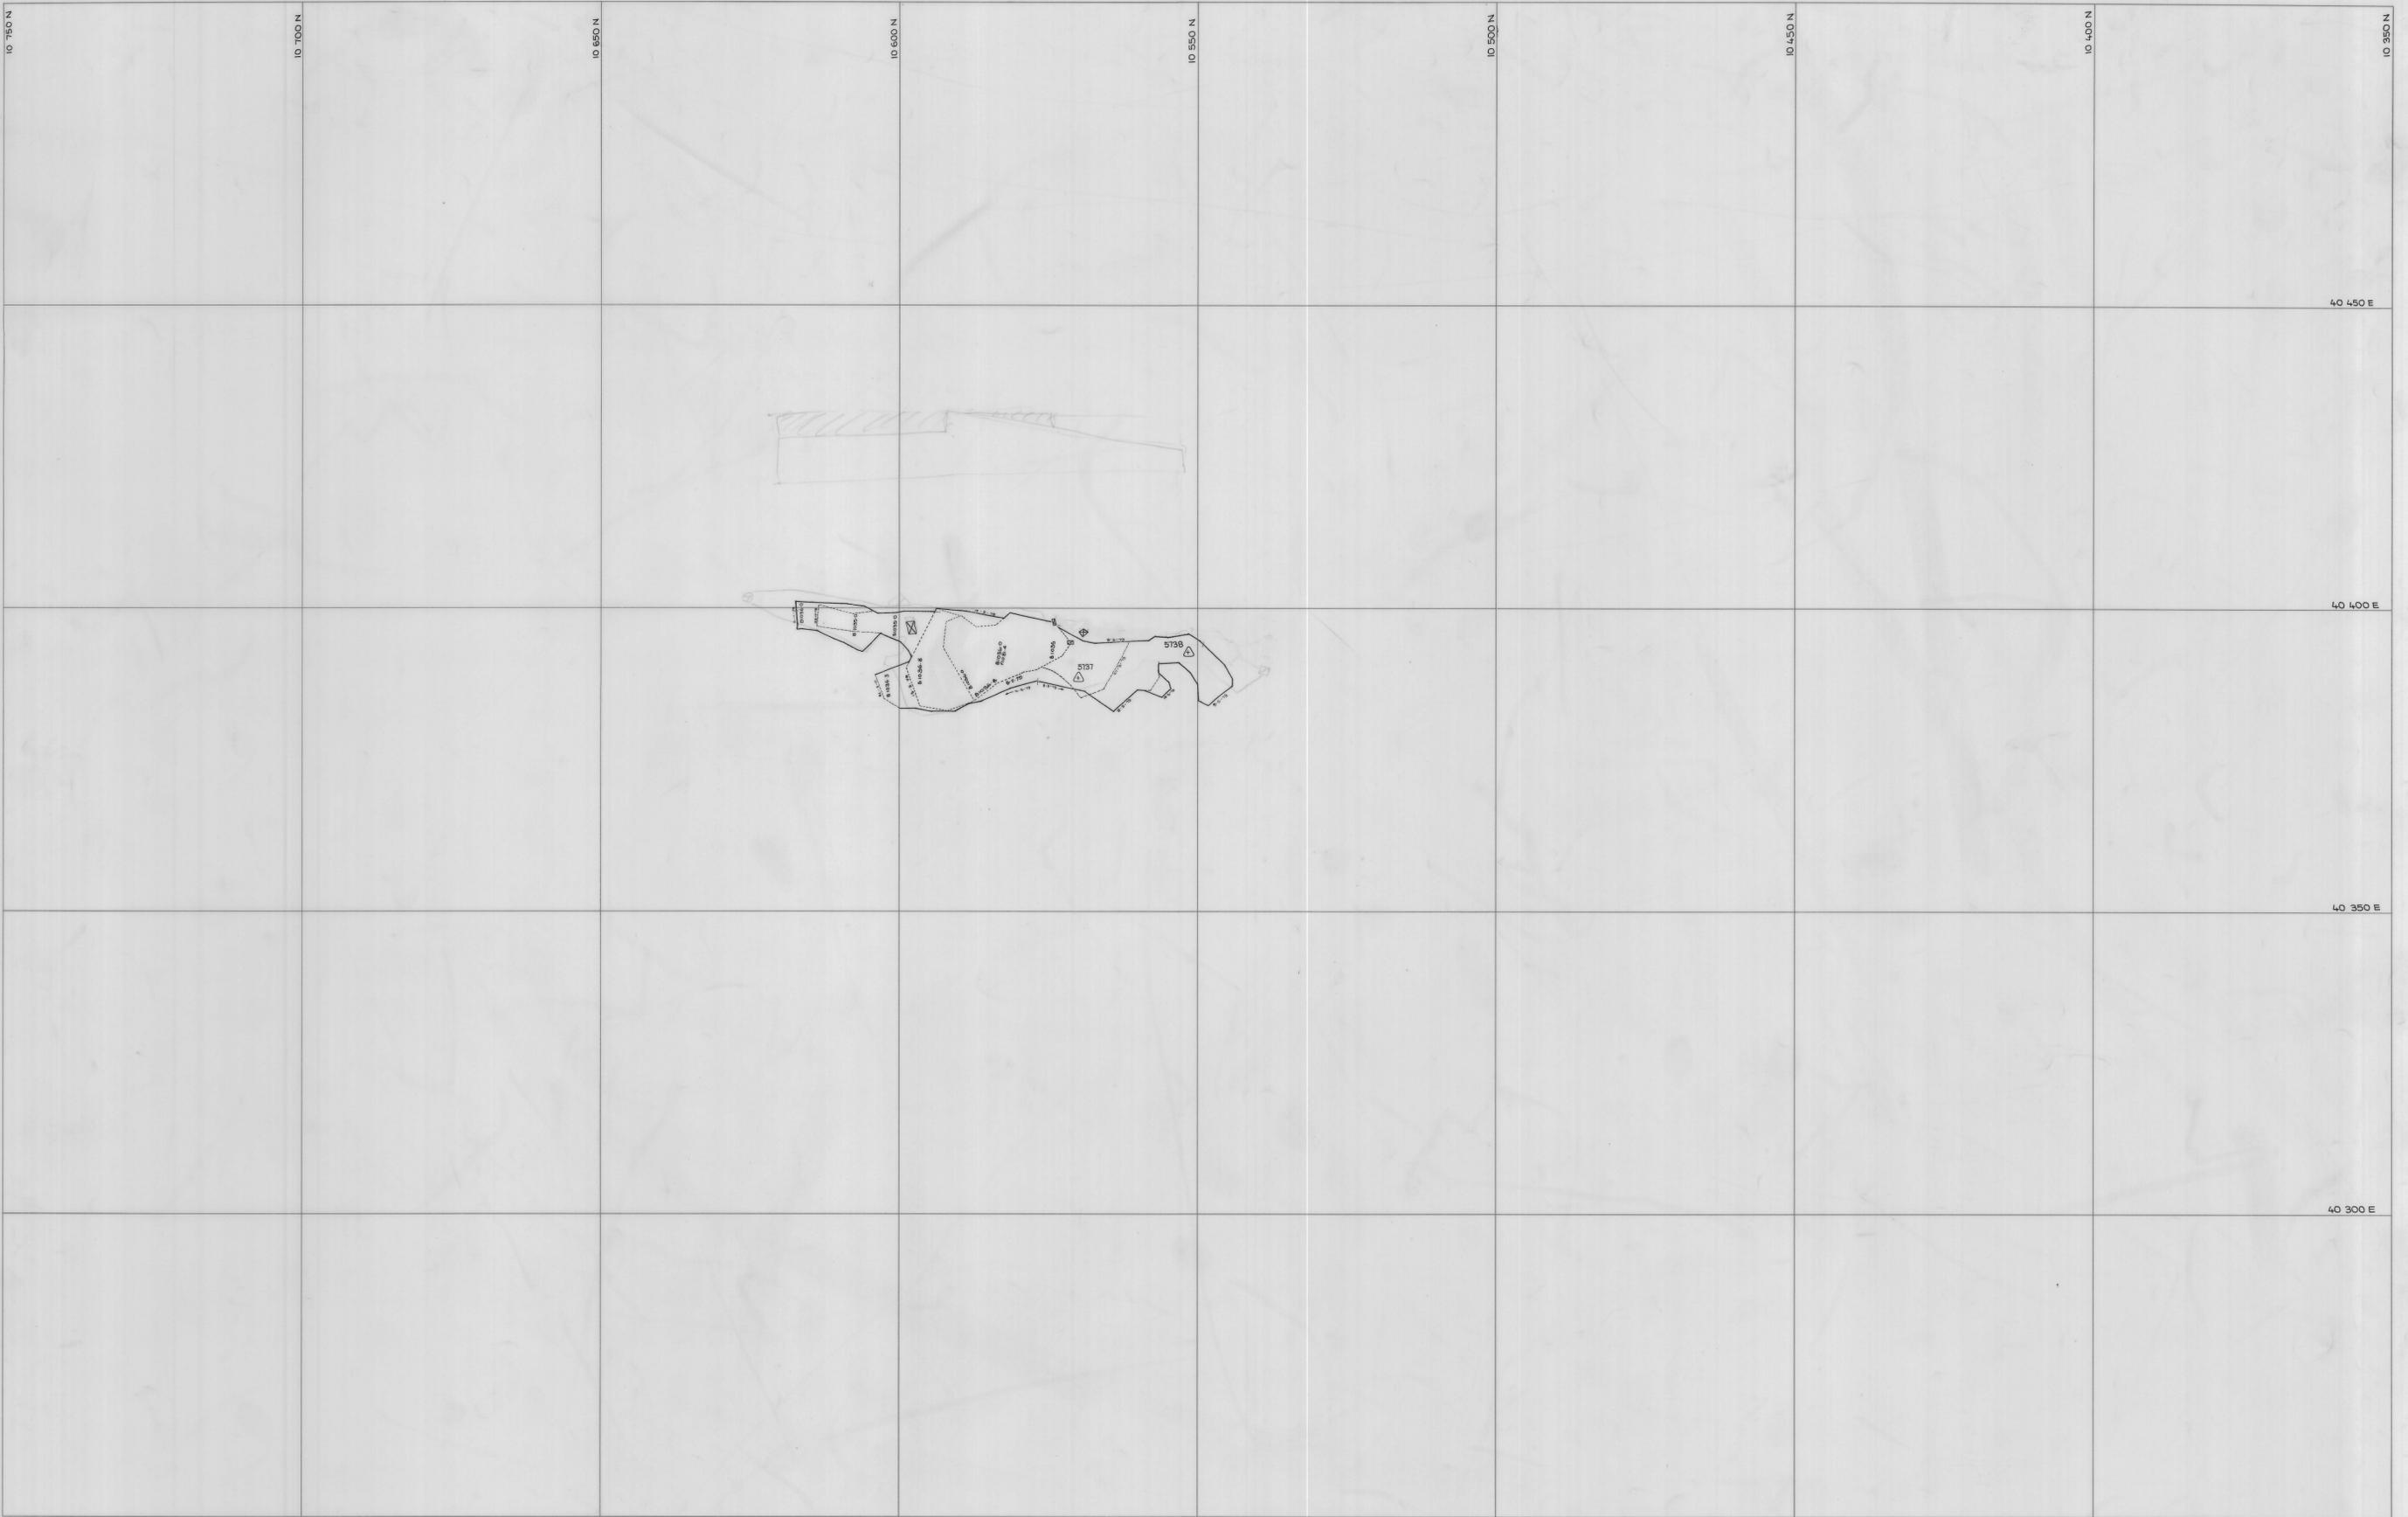


0374-218

04BH15-105-97

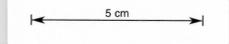

	SCALE 1:500		LOCATION BOLD HEAD MINE	 A DIVISION OF WARMAN INTERNATIONAL GRASSY KING ISLAND
		north	SUBJECT <b>P57 STOPE</b> [3rd Lift]	