


27 JUN 1971

04 DM13-1023

C WEDGE
130

0374-2181

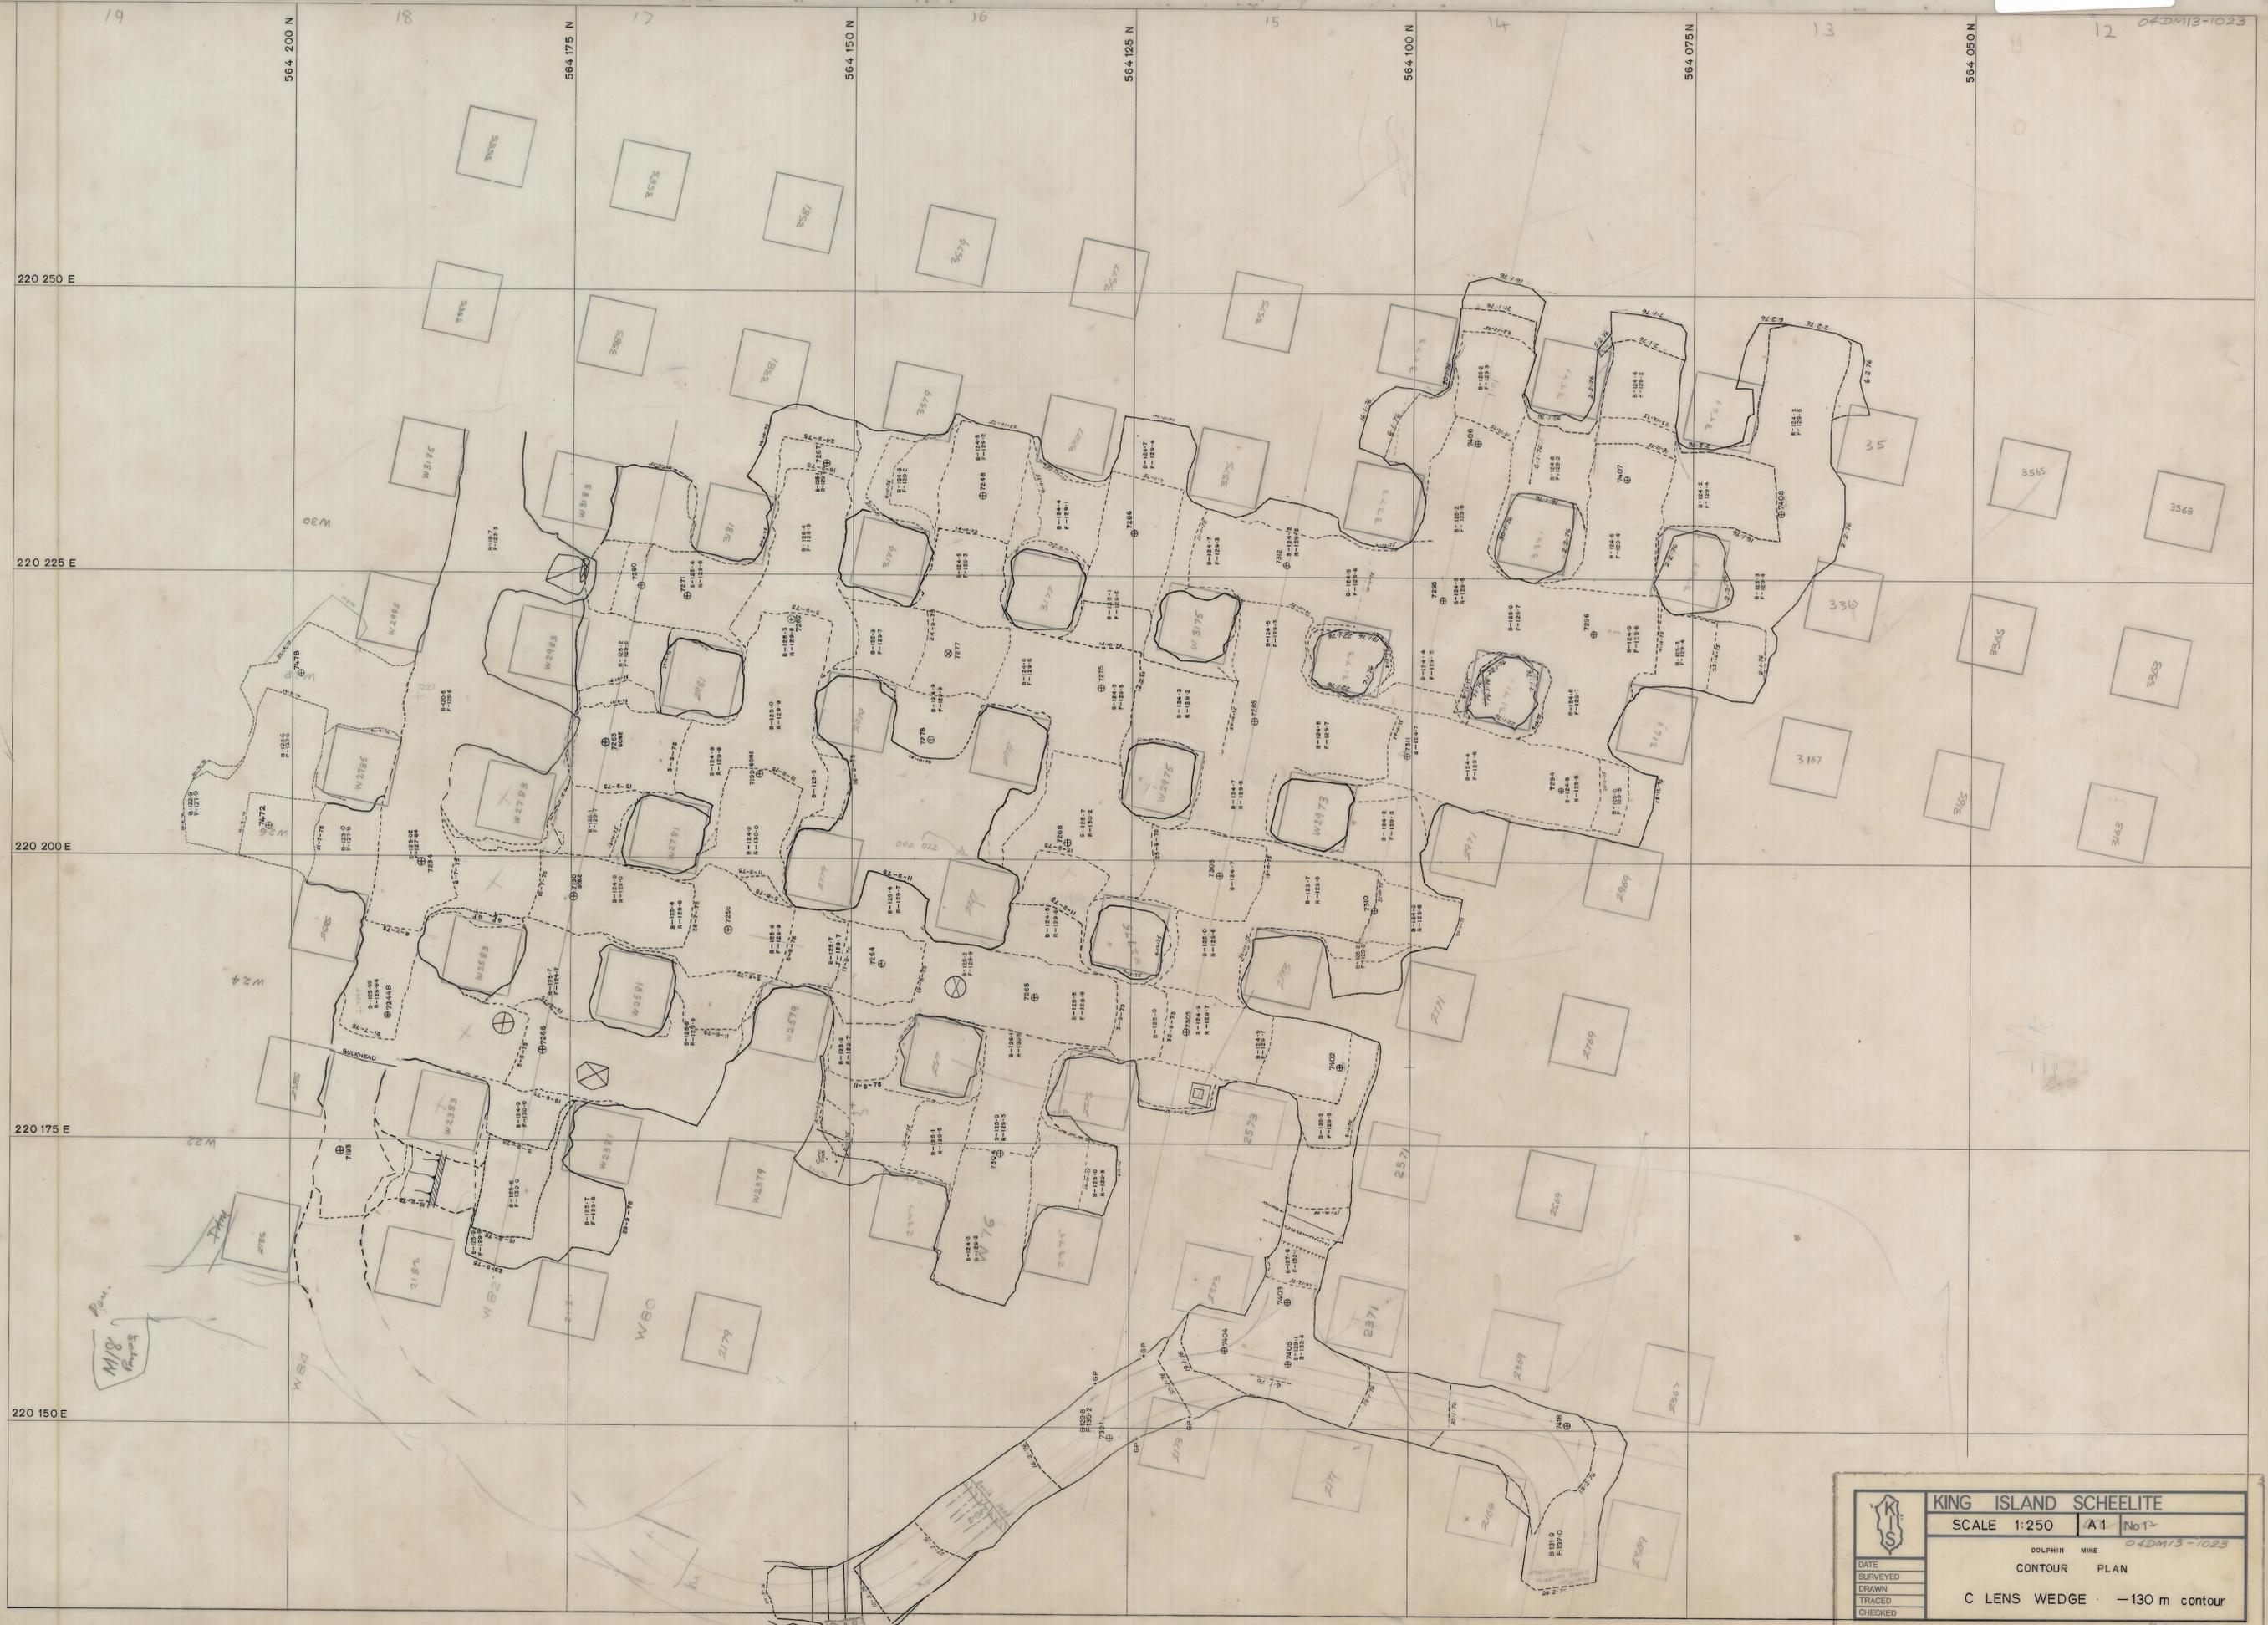

	KING ISLAND SCHEELITE		
	SCALE 1:250	A1	No 1
DATE SURVEYED	DOLPHIN MINE 04DM13-1023		
DRAWN	CONTOUR PLAN		
TRACED	C LENS WEDGE - 130 m contour		
CHECKED			