


0374_2186

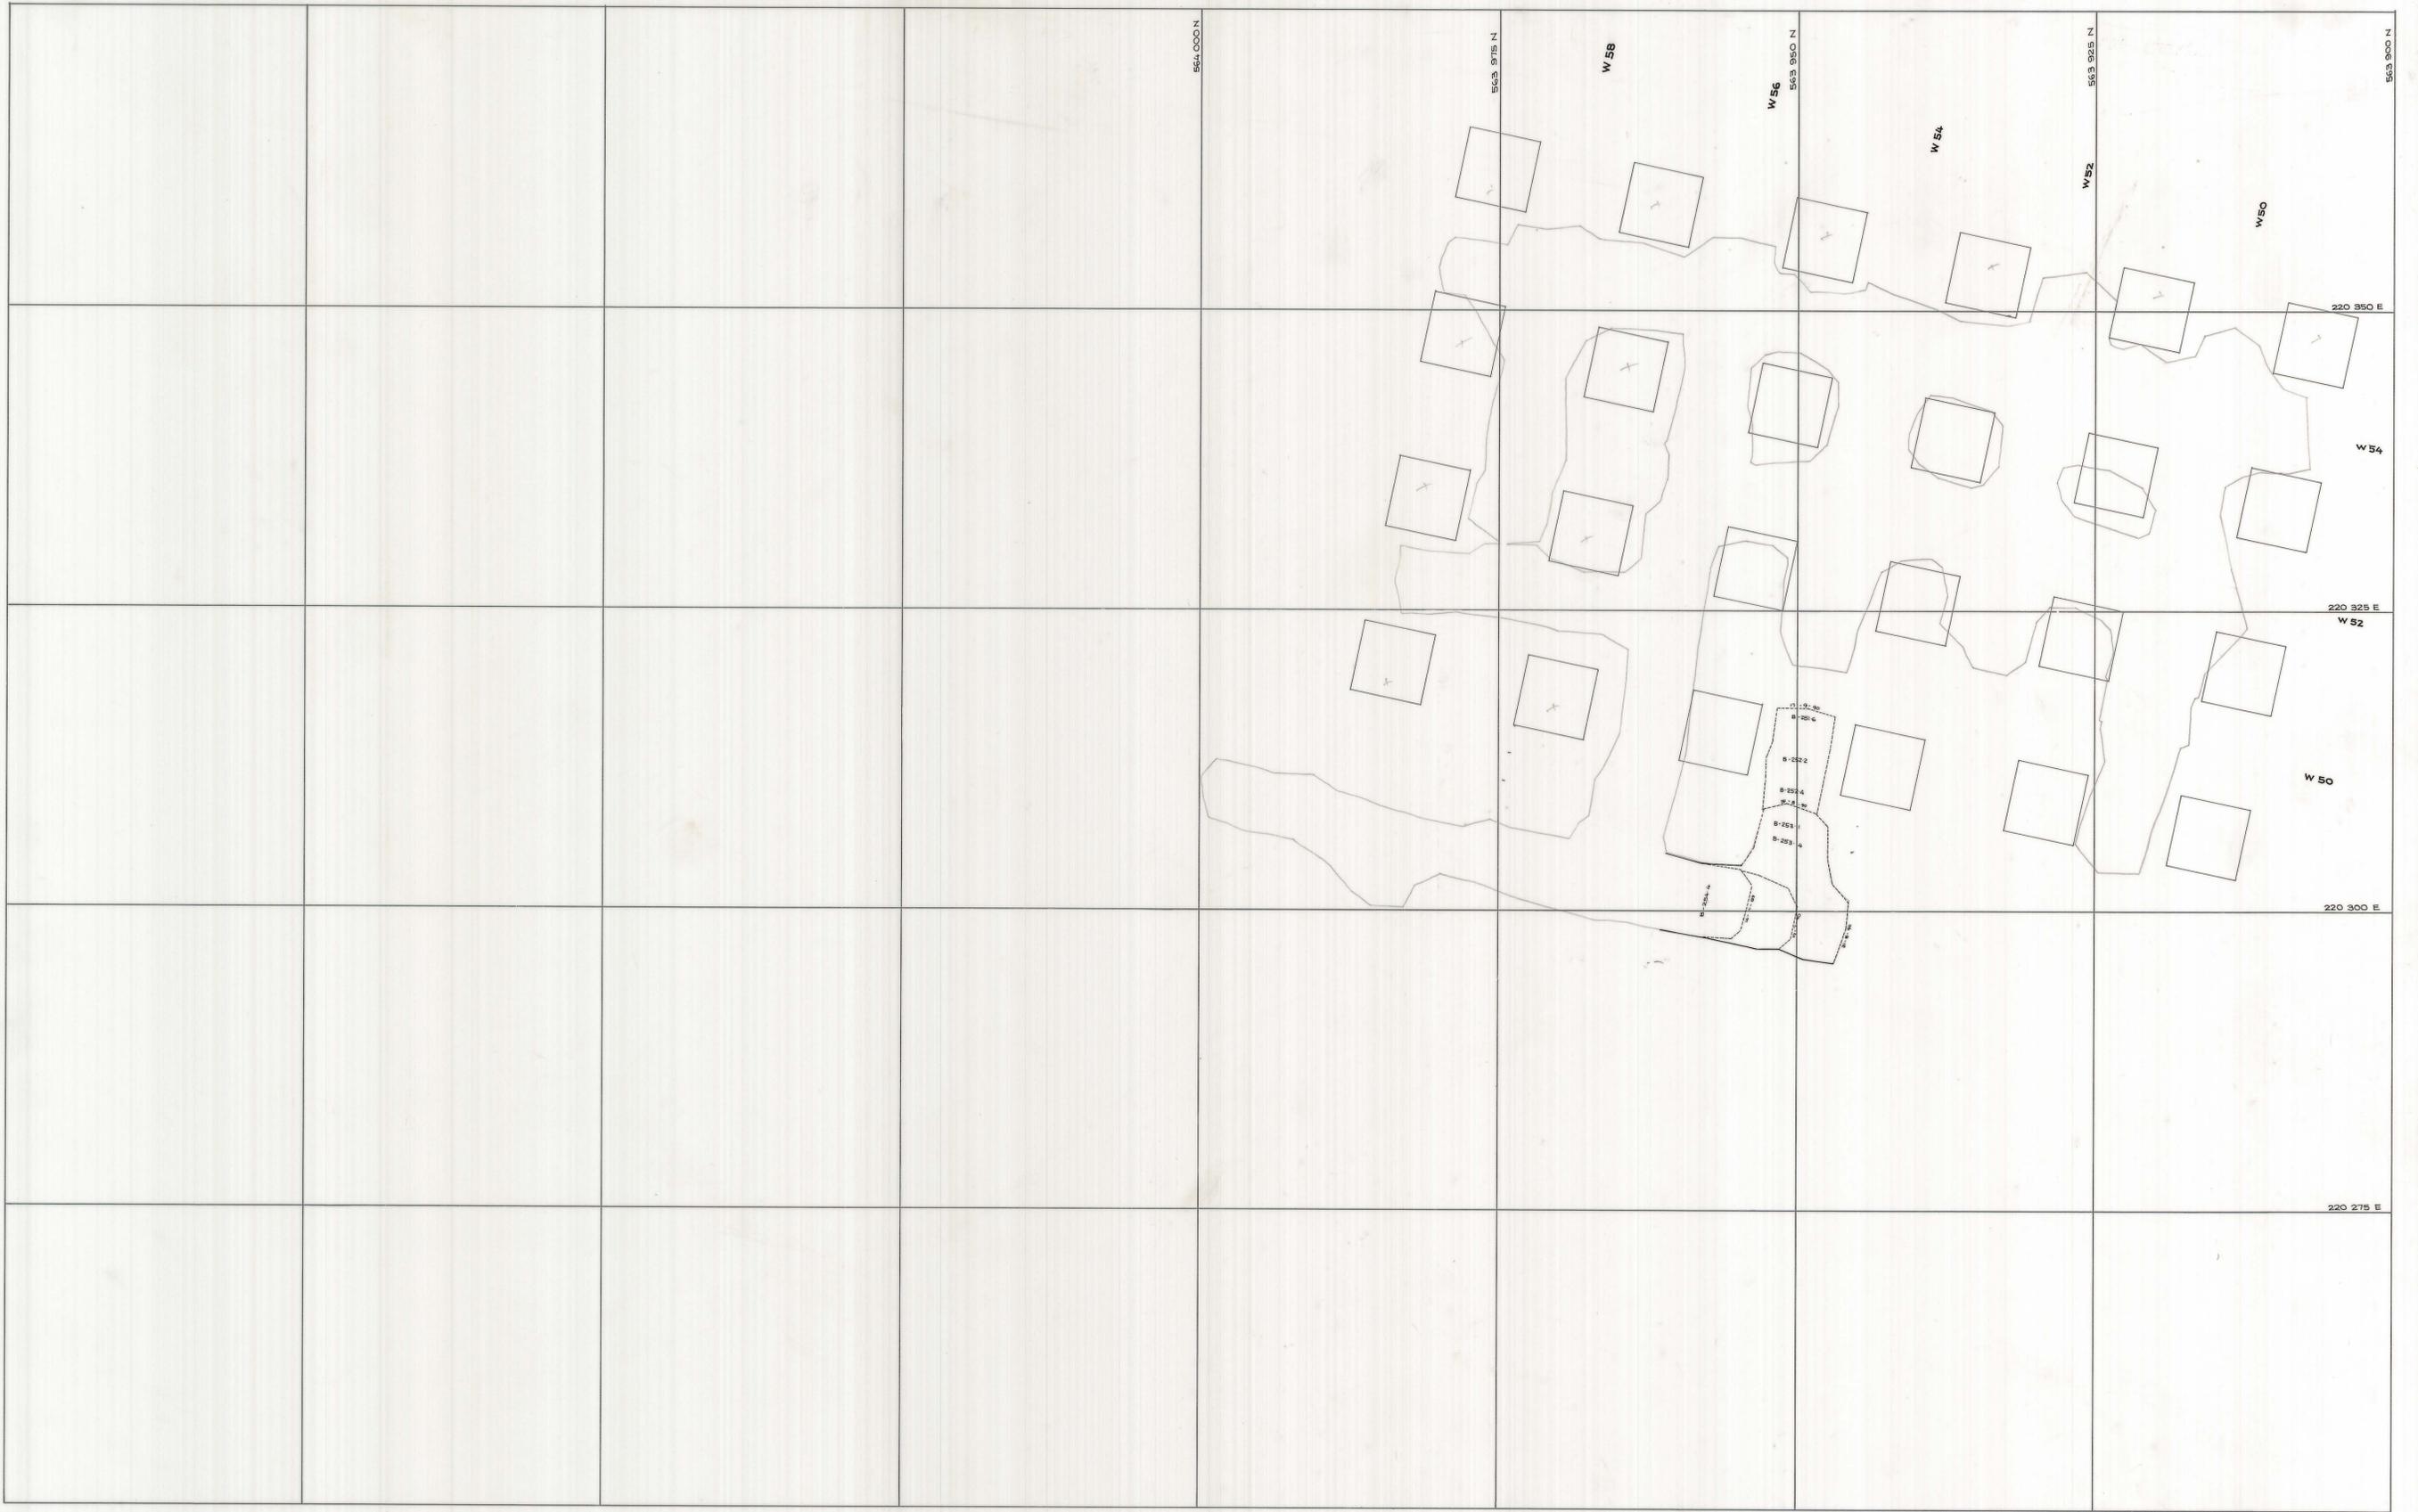

	SCALE 1: 250		LOCATION DOLPHIN MINE SUBJECT LOWER WEDGE STOPE 2ND LIFT -260 m ZONE	 KING ISLAND SCHEELITE A DIVISION OF WARMAN INTERNATIONAL GRASSY KING ISLAND <small>DATE PLOTTED</small> <small>PLAN NUMBER</small>
--	--------------	--	---	--