


0374-219


04BH15-105-98

P57  
2nd  
LIFT

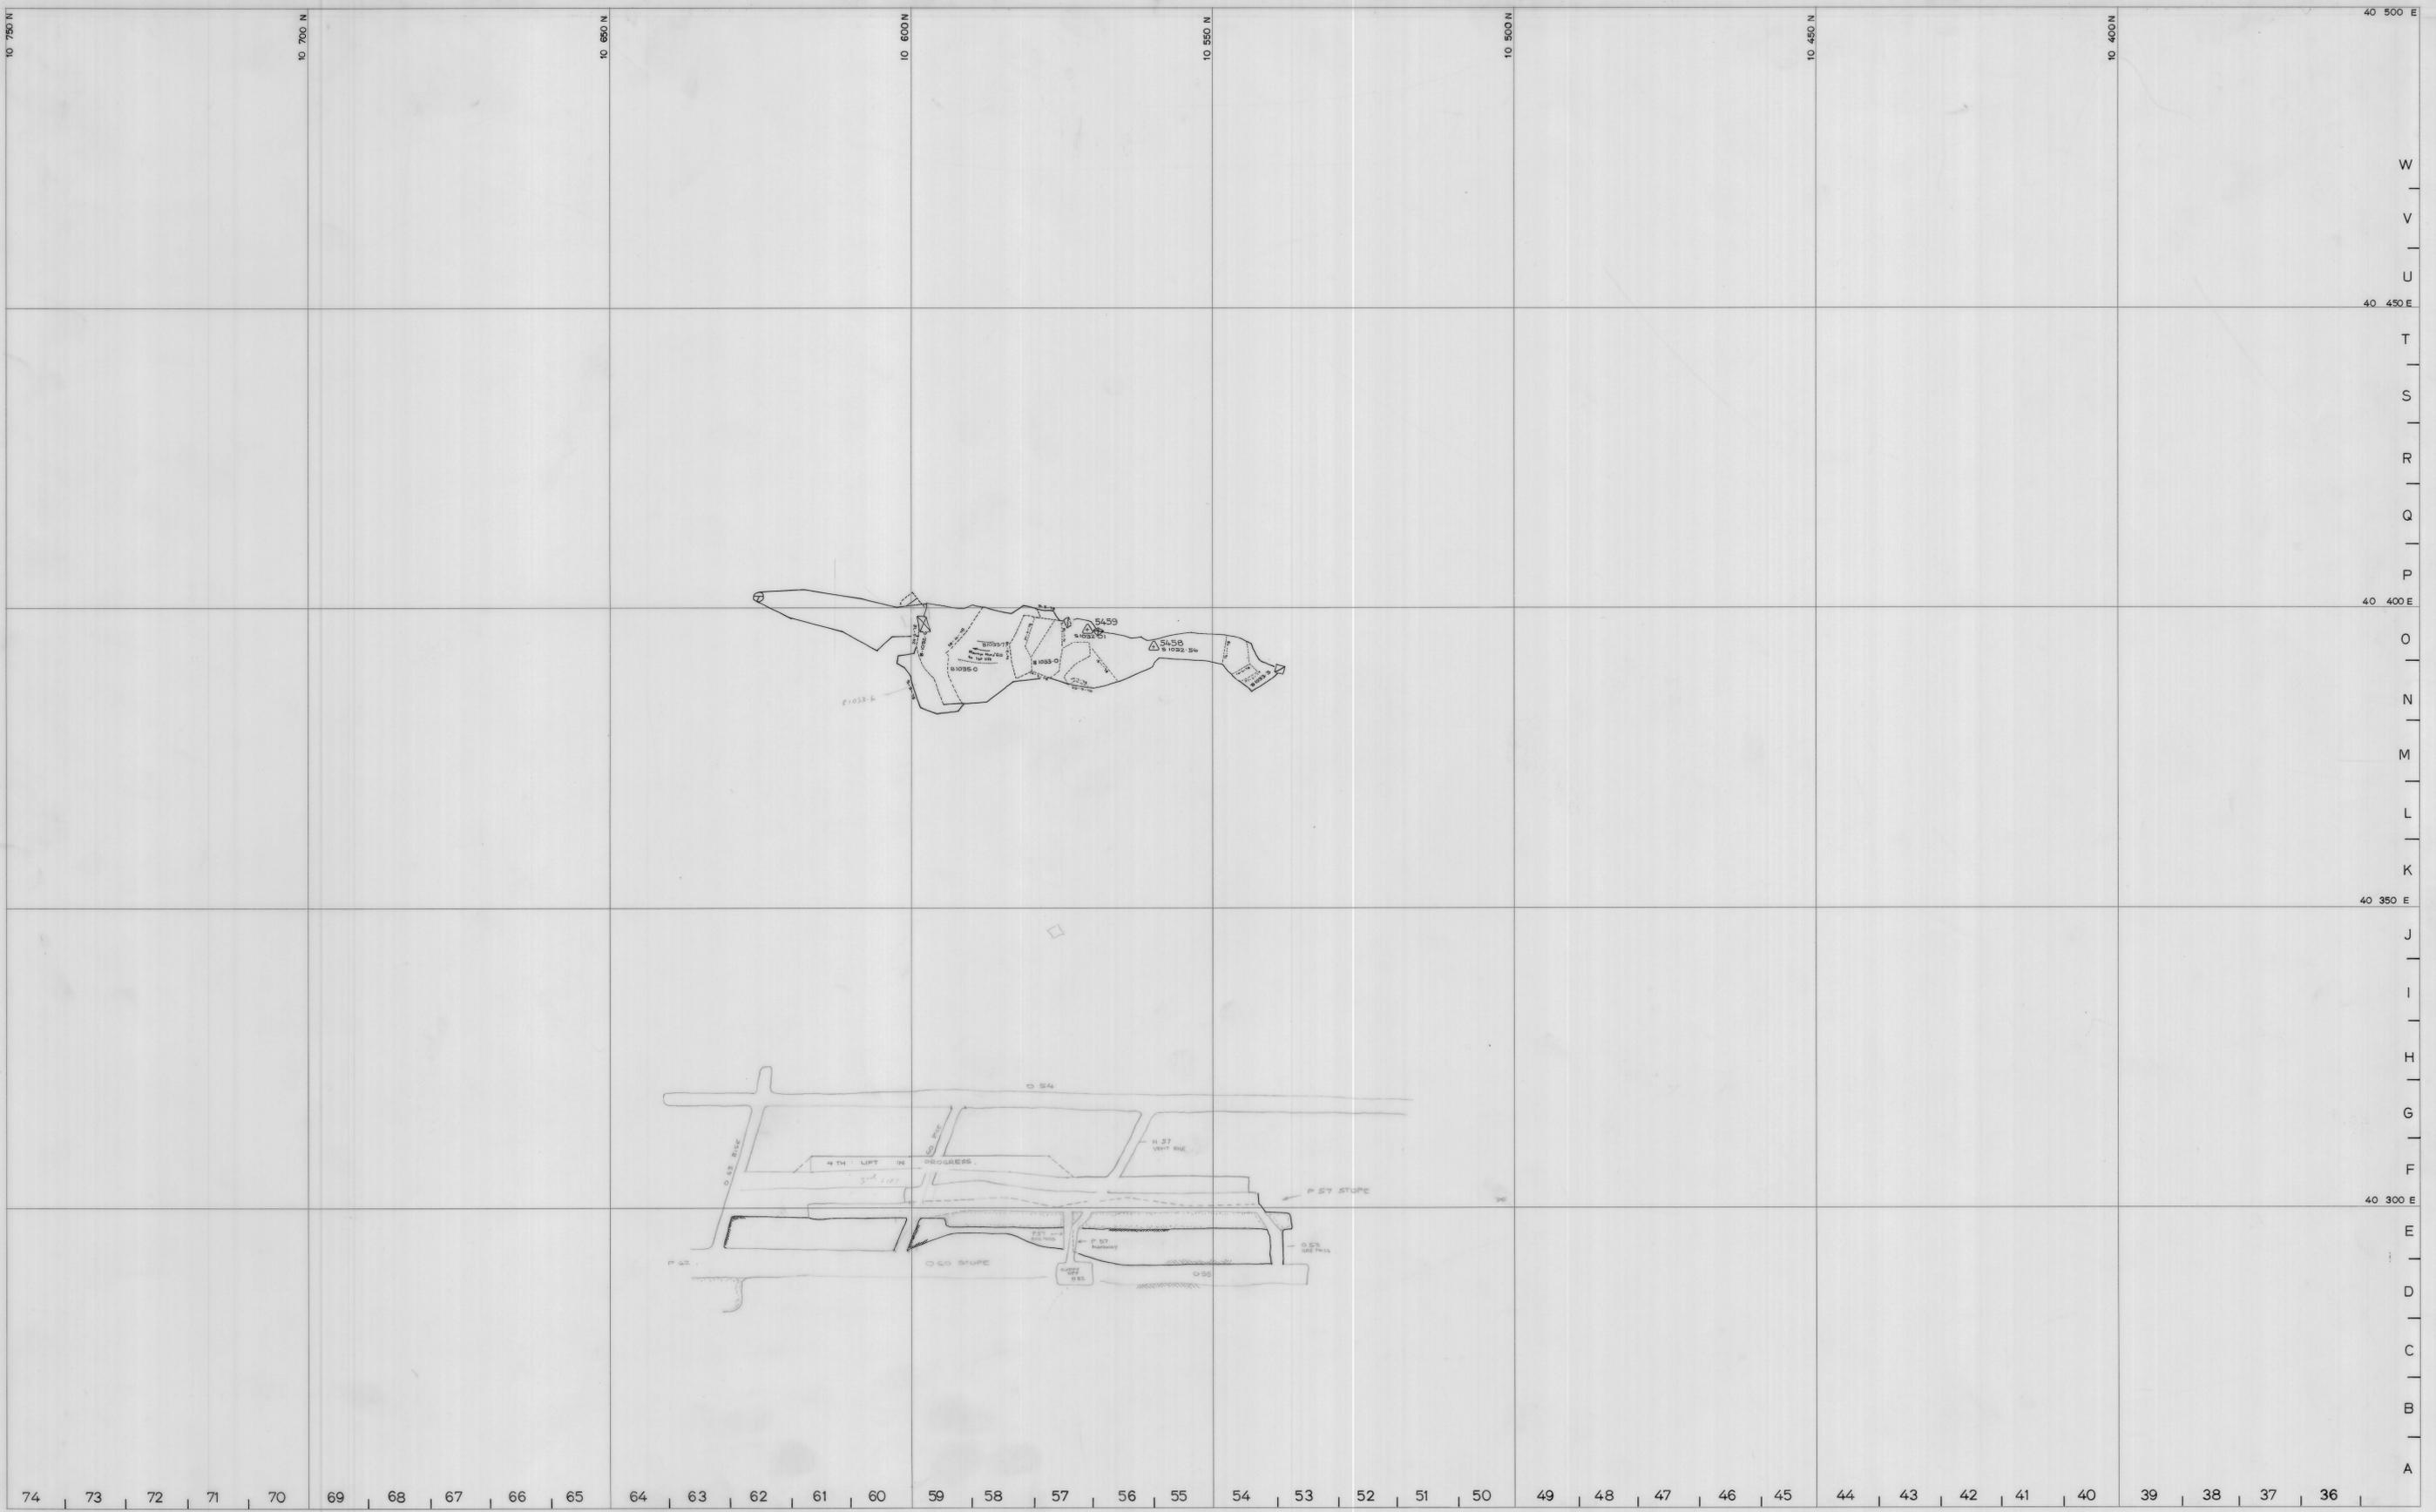

74 73 72 71 70 69 68 67 66 65 64 63 62 61 60 59 58 57 56 55 54 53 52 51 50 49 48 47 46 45 44 43 42 41 40 39 38 37 36

SCALE 1:500

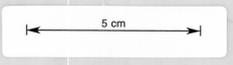

north

LOCATION BOLD HEAD MINE

SUBJECT P 57 STOPE  
[2nd Lift]

**KIS** KING ISLAND SCHEELITE  
A DIVISION OF WARMAN INTERNATIONAL

GRASSY KING ISLAND

PLAN NUMBER 04BH15-105-98