



0374-220

04BH15-106-89

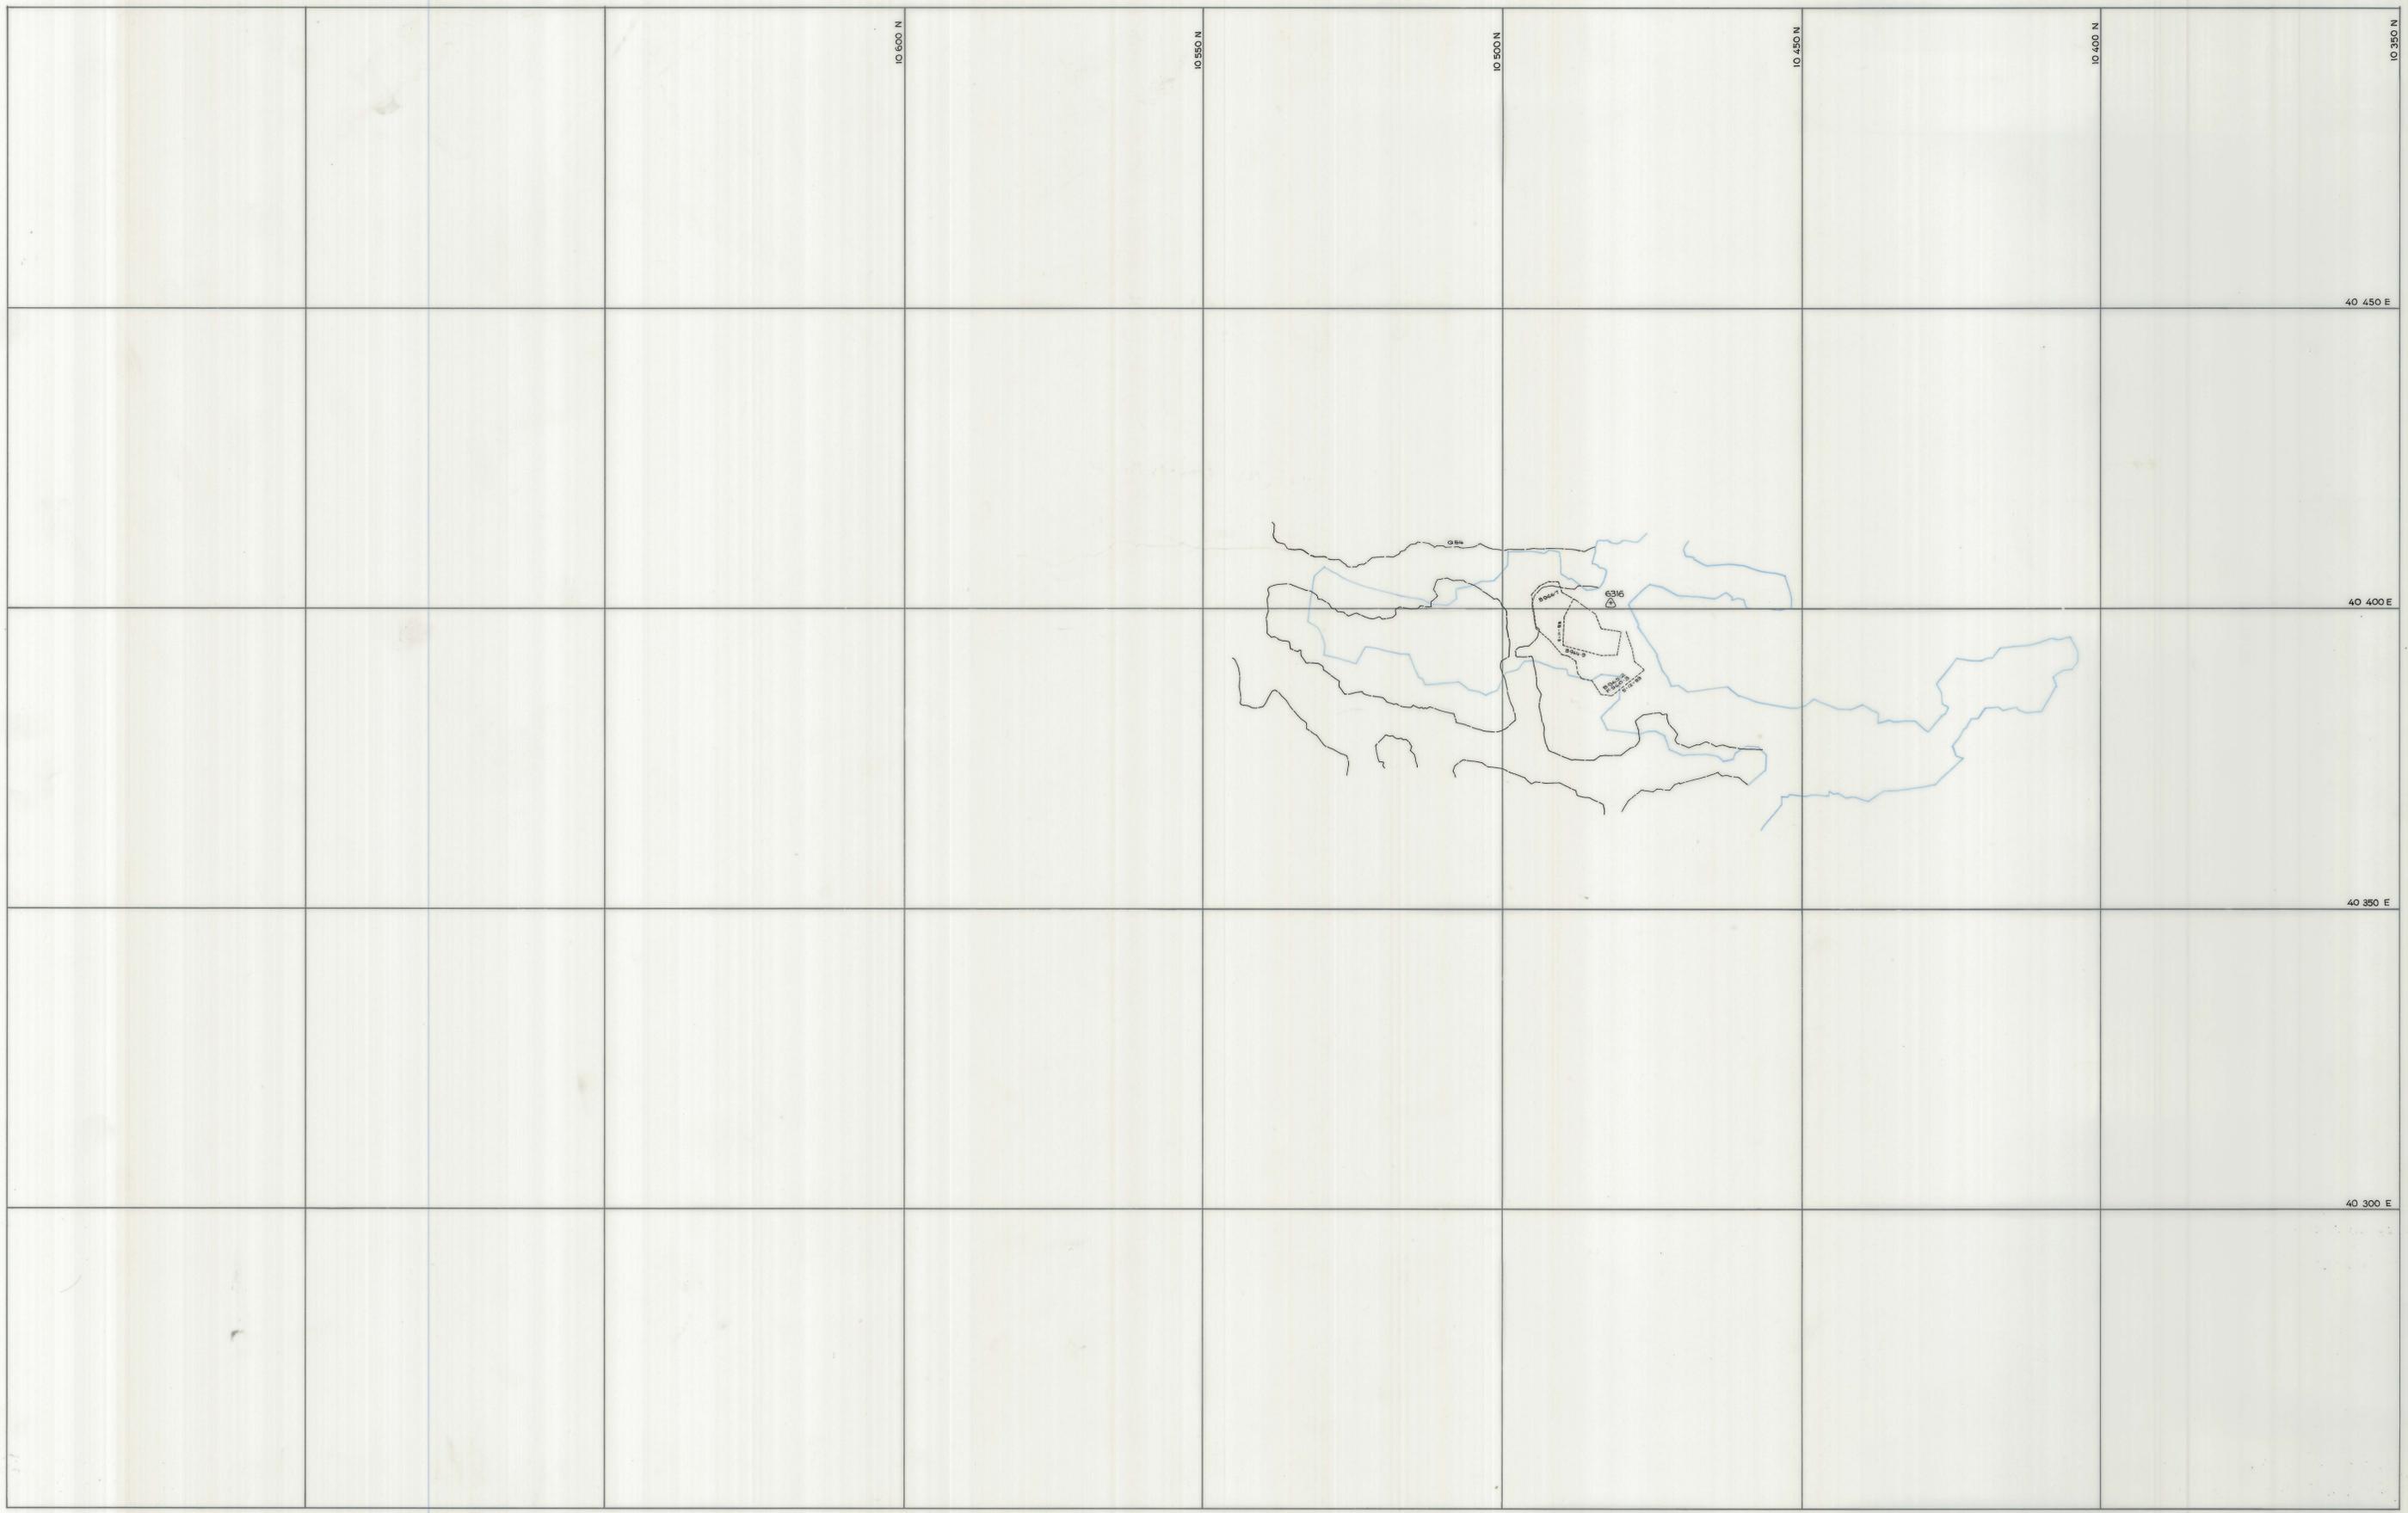

SCALE 1:500

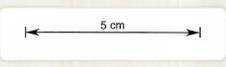

LOCATION BOLD HEAD MINE

SUBJECT Stope address 046-EL

046 STOPE
11th Lift

KING ISLAND SCHEELITE
A DIVISION OF WARMAN INTERNATIONAL

GRASSY KING ISLAND

PLAN NUMBER 04BH15 - 106 - 89