


0374-2205

-110 C WEDGE
PAY PLAN.

564225N

-110 C WEDGE
PAY PLAN.

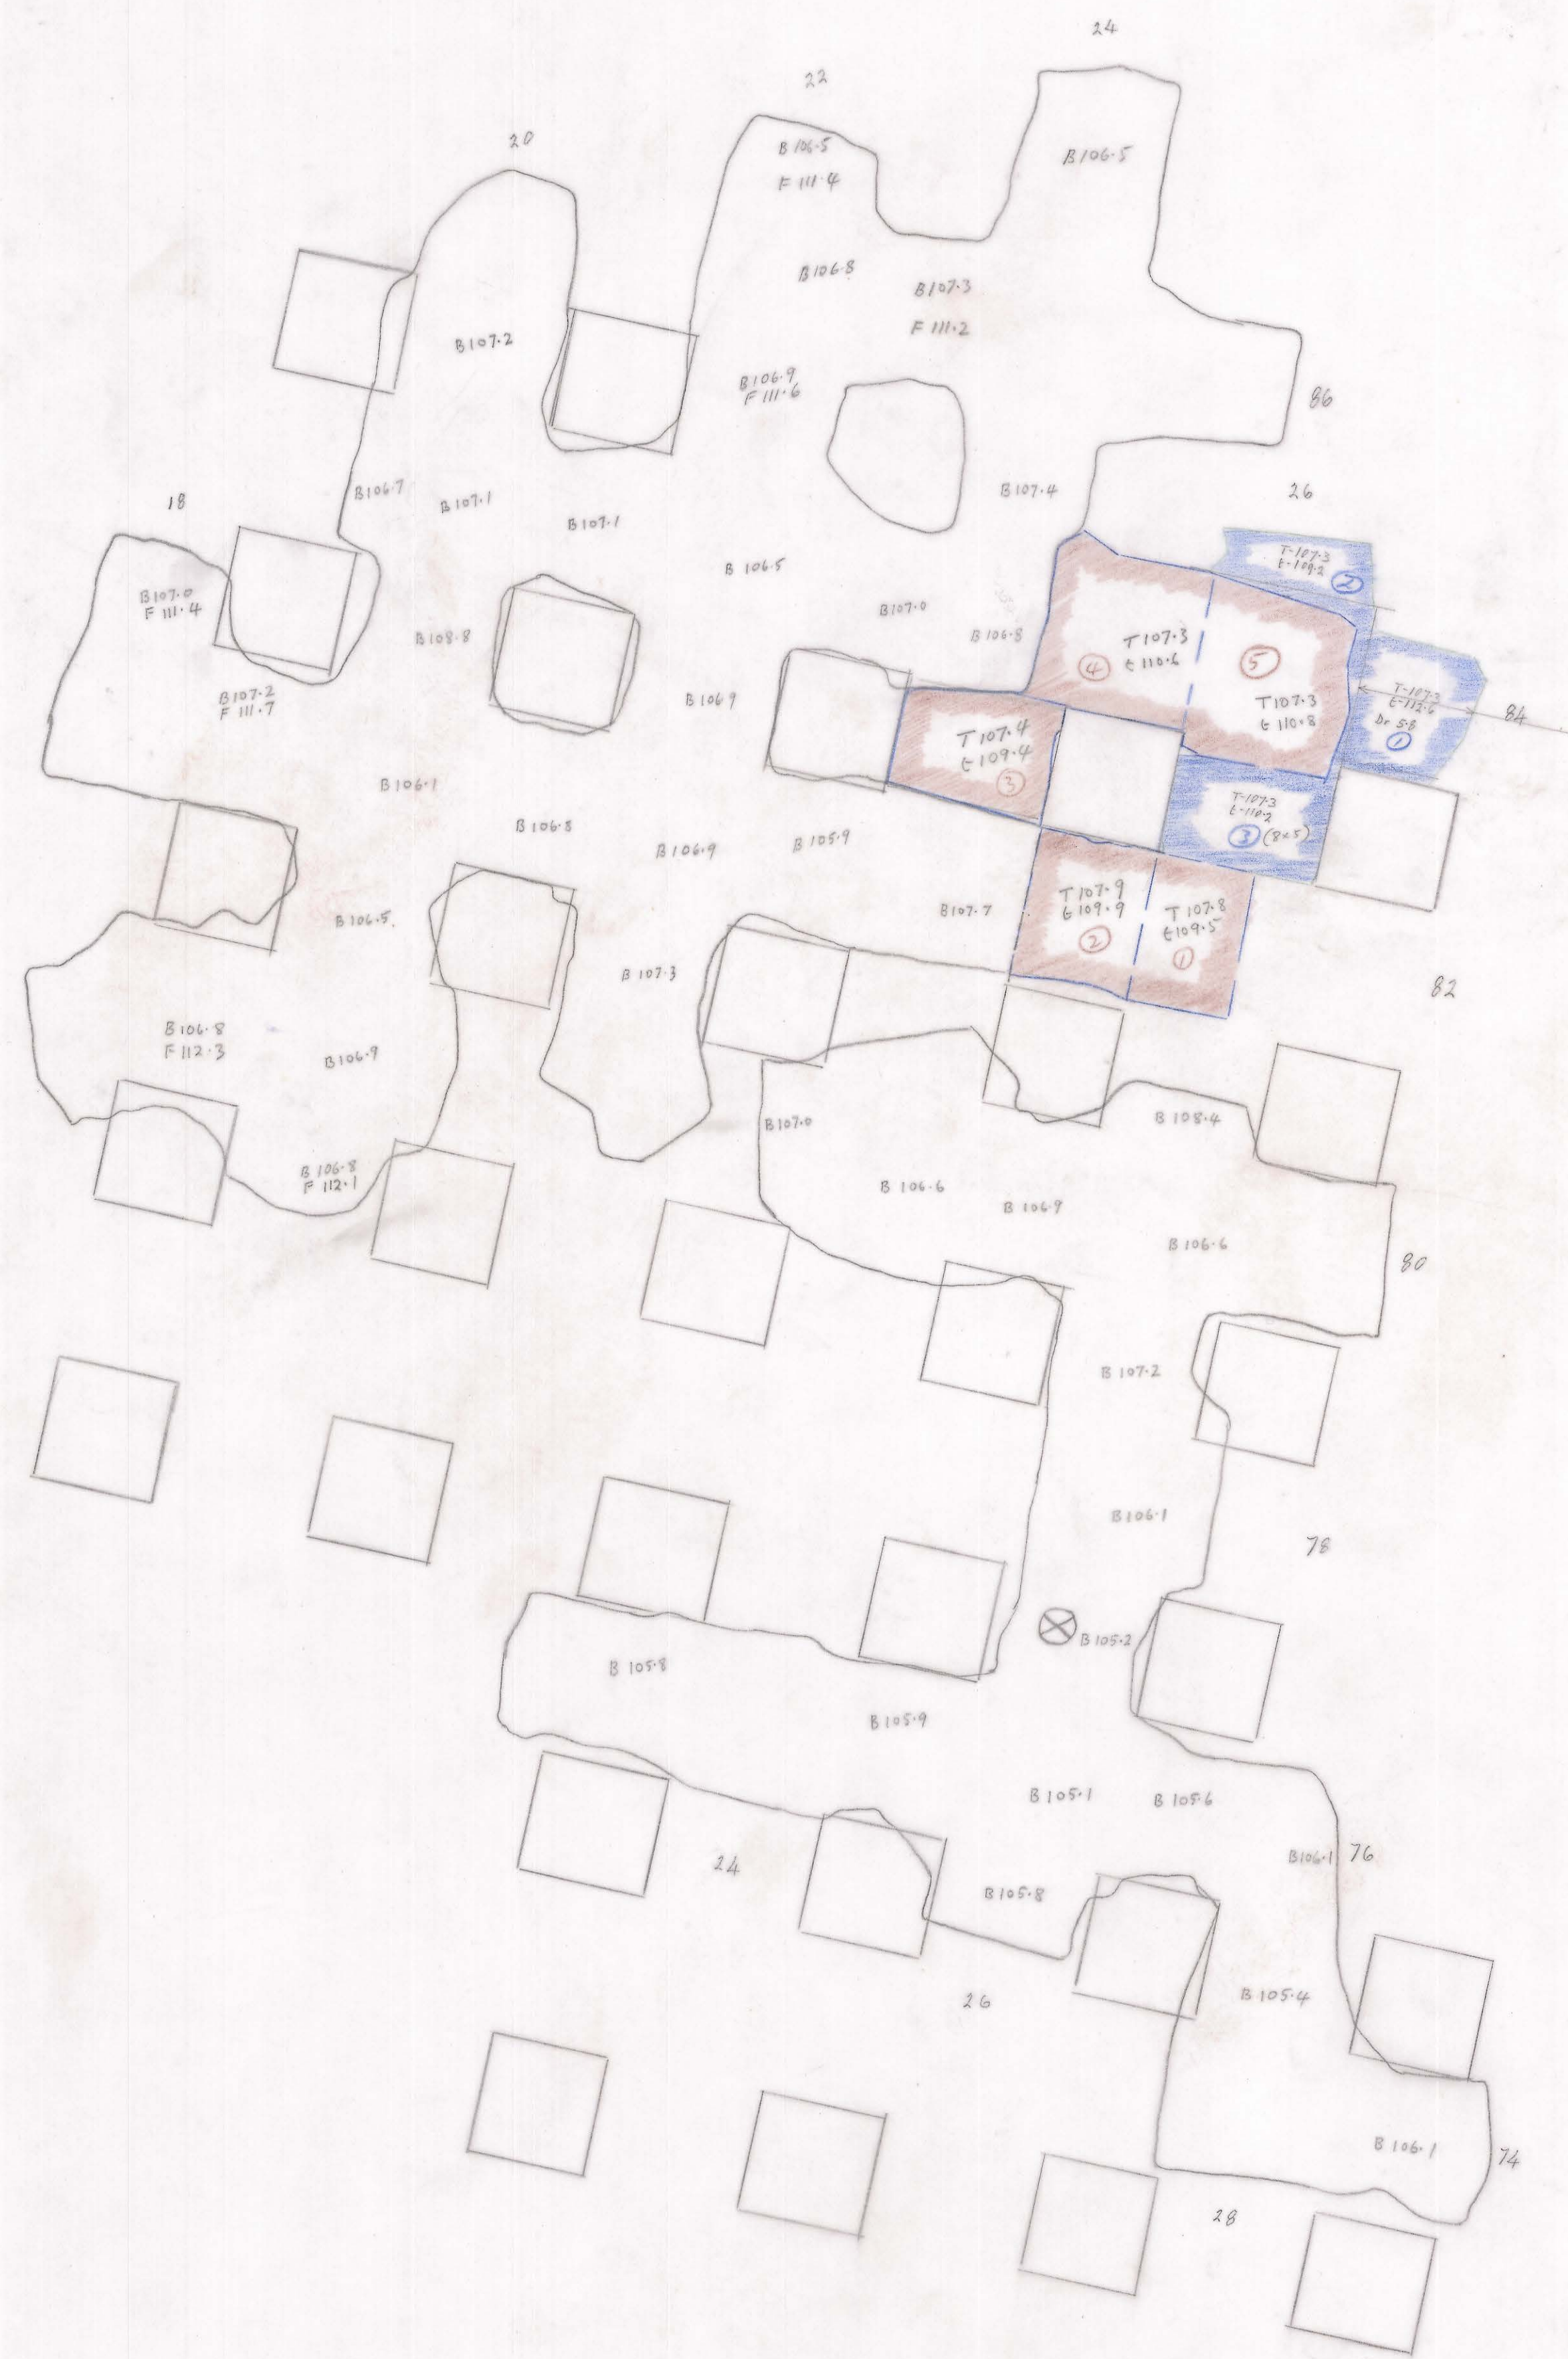

564100N

-110 C WEDGE
PAY PLAN.