




060/070
-155

04 DM 19-1991

0374_2241

DM
C. P. I.
-155-6
1-100
1976

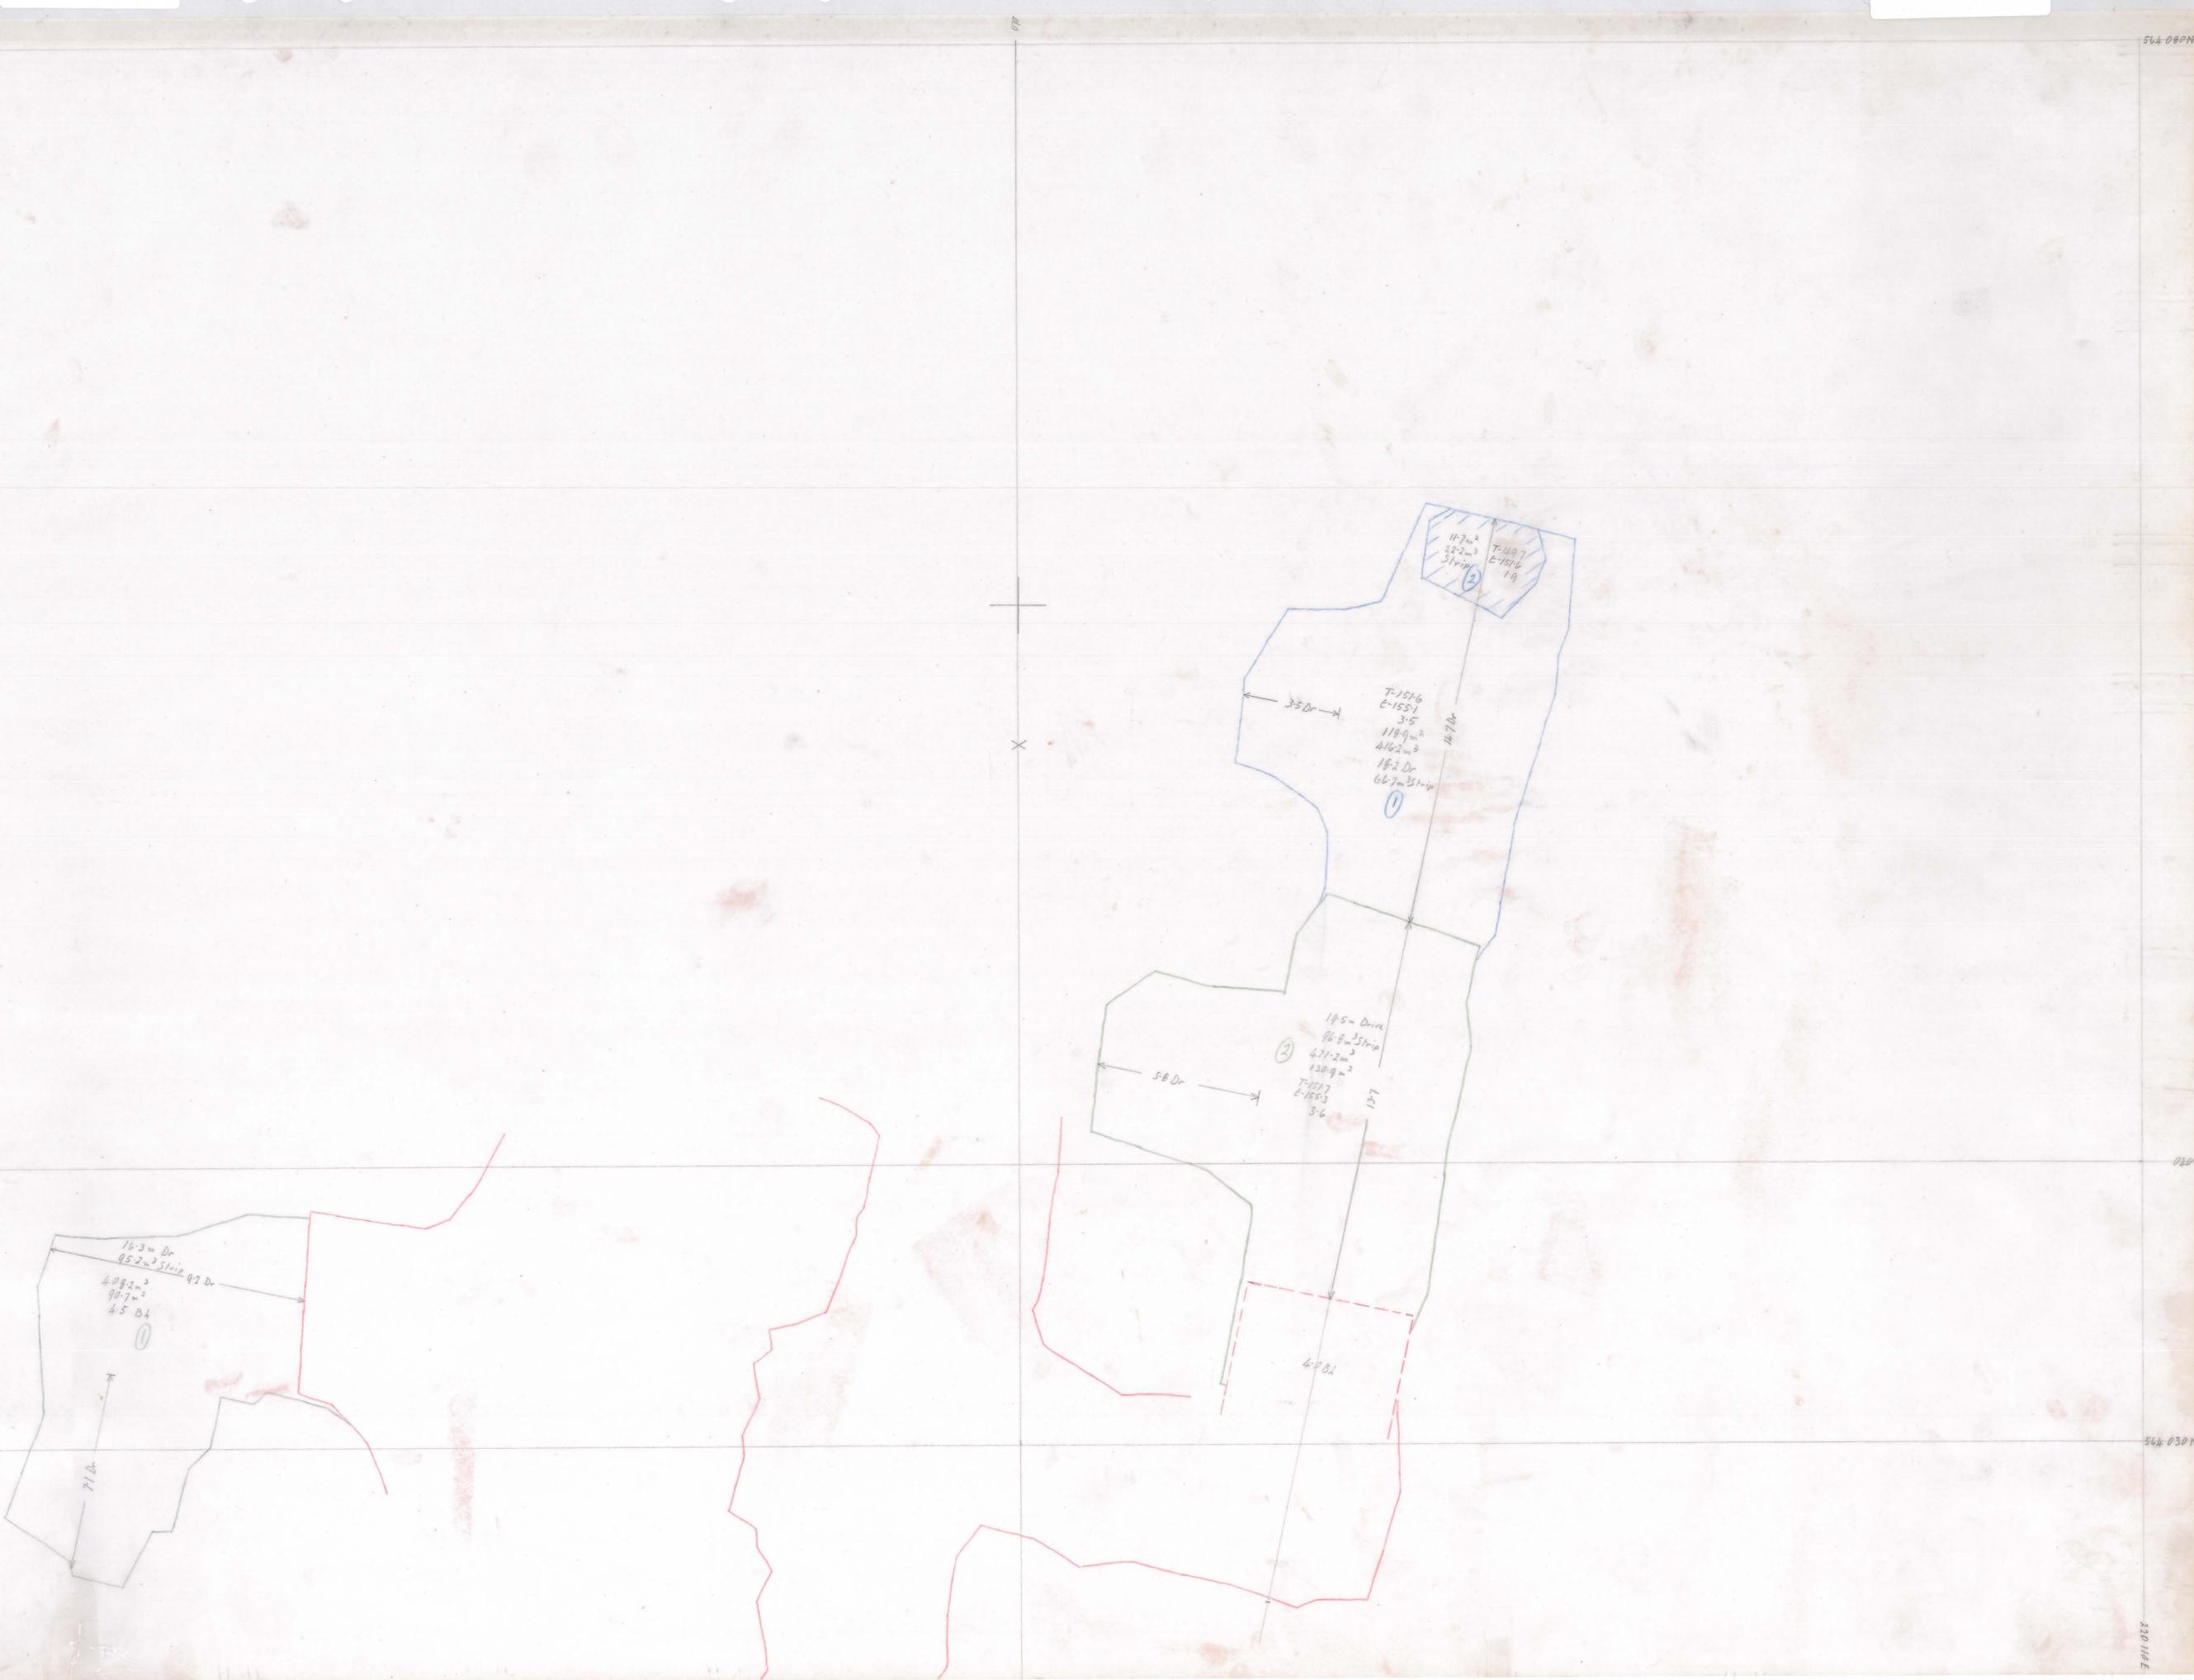

564 080N

564 030N

530 100E