
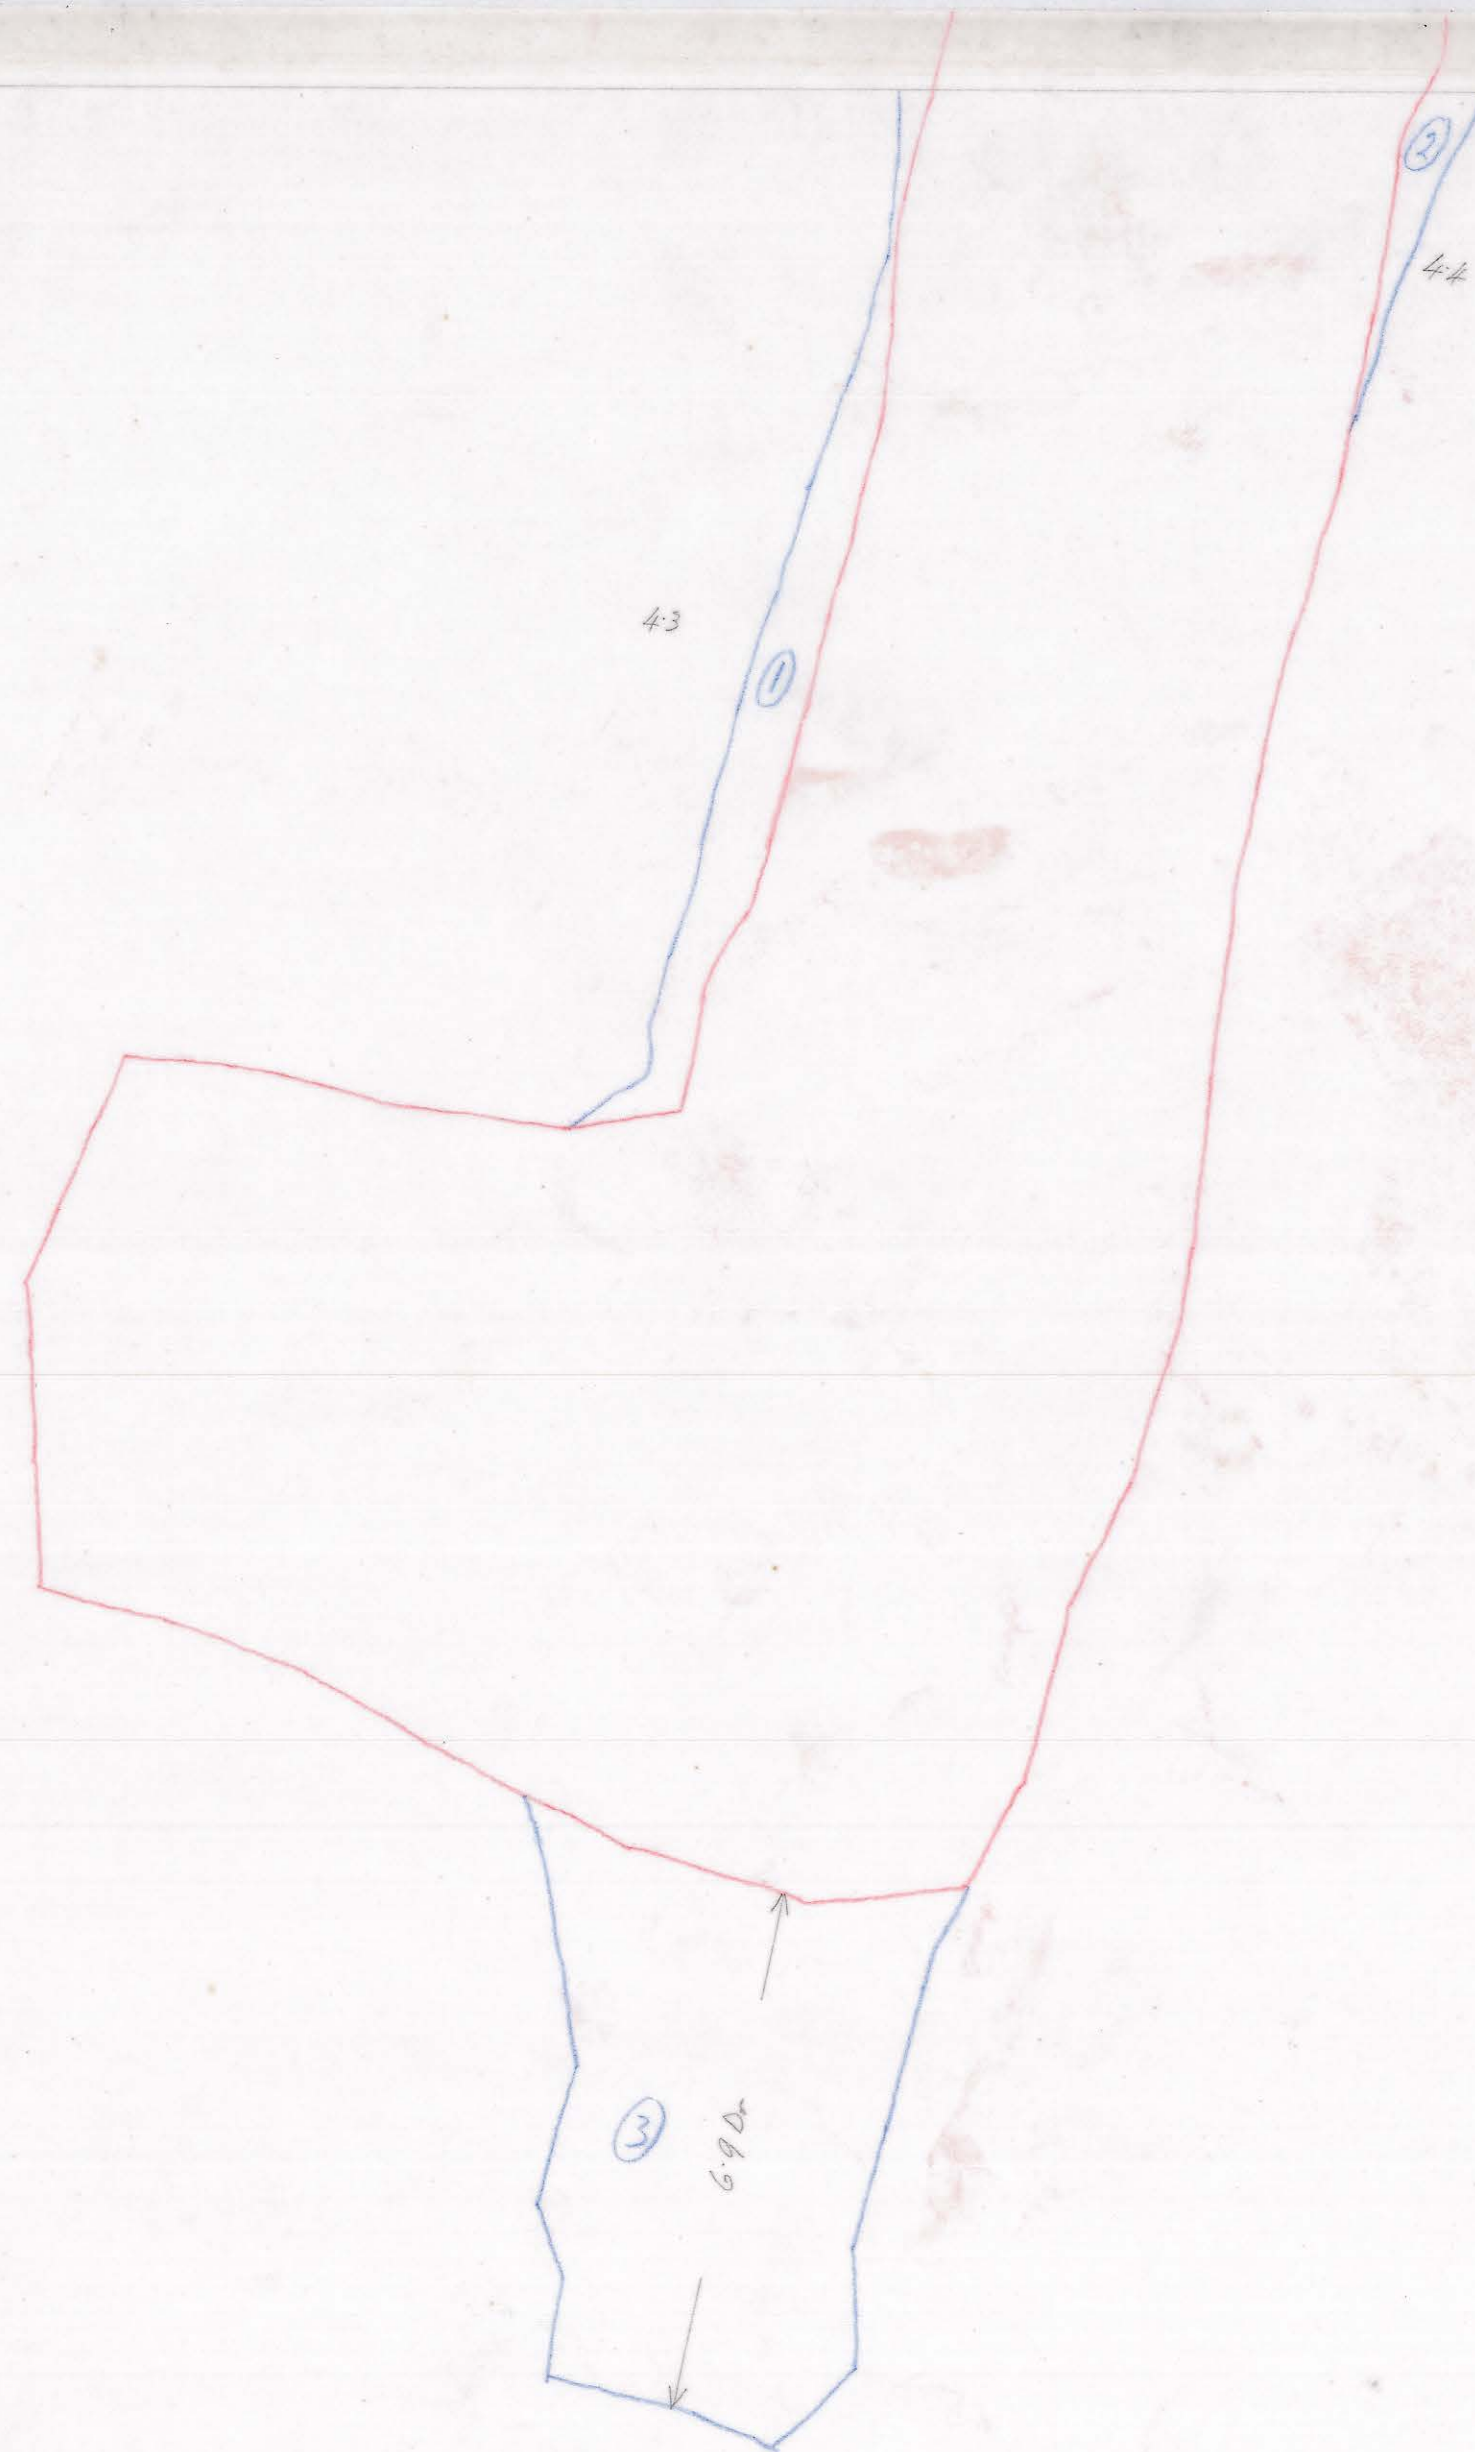
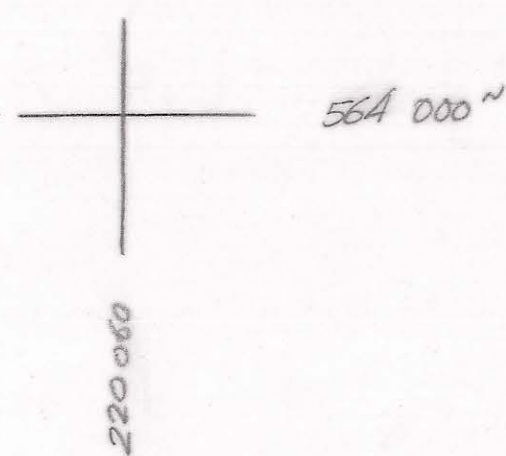


0374_2244

04 DM 19-1085

DM
C.P.T.
-150-2
1:100
1976
4

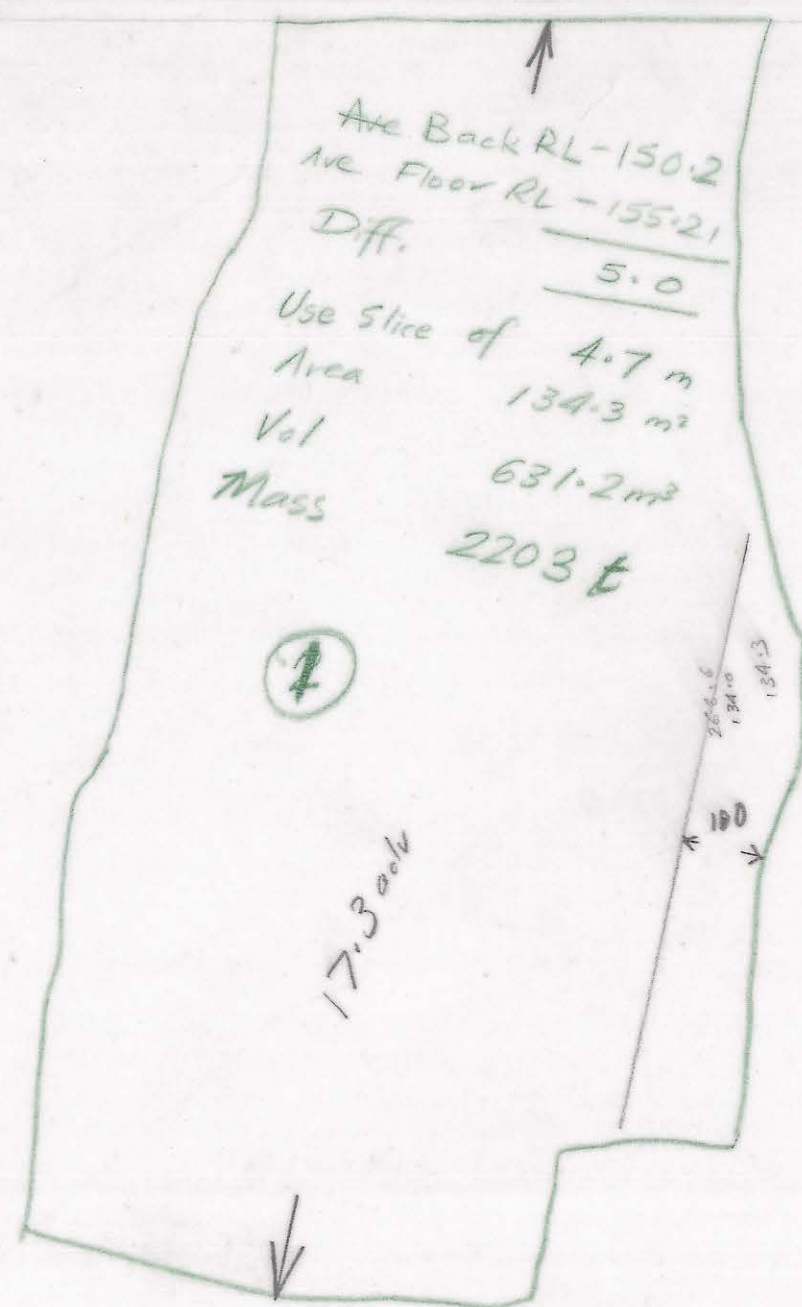

100
Refer to 04 DM 11-1127

-150/ CPT RAMP
Pay Calculations
4th Period ending 26 OCT 76

04 DM 19-1085