
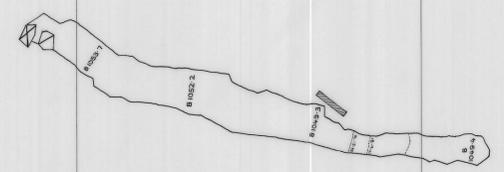
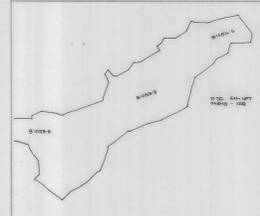


0374-225

04BH15-103-99

H50
1st
Lift

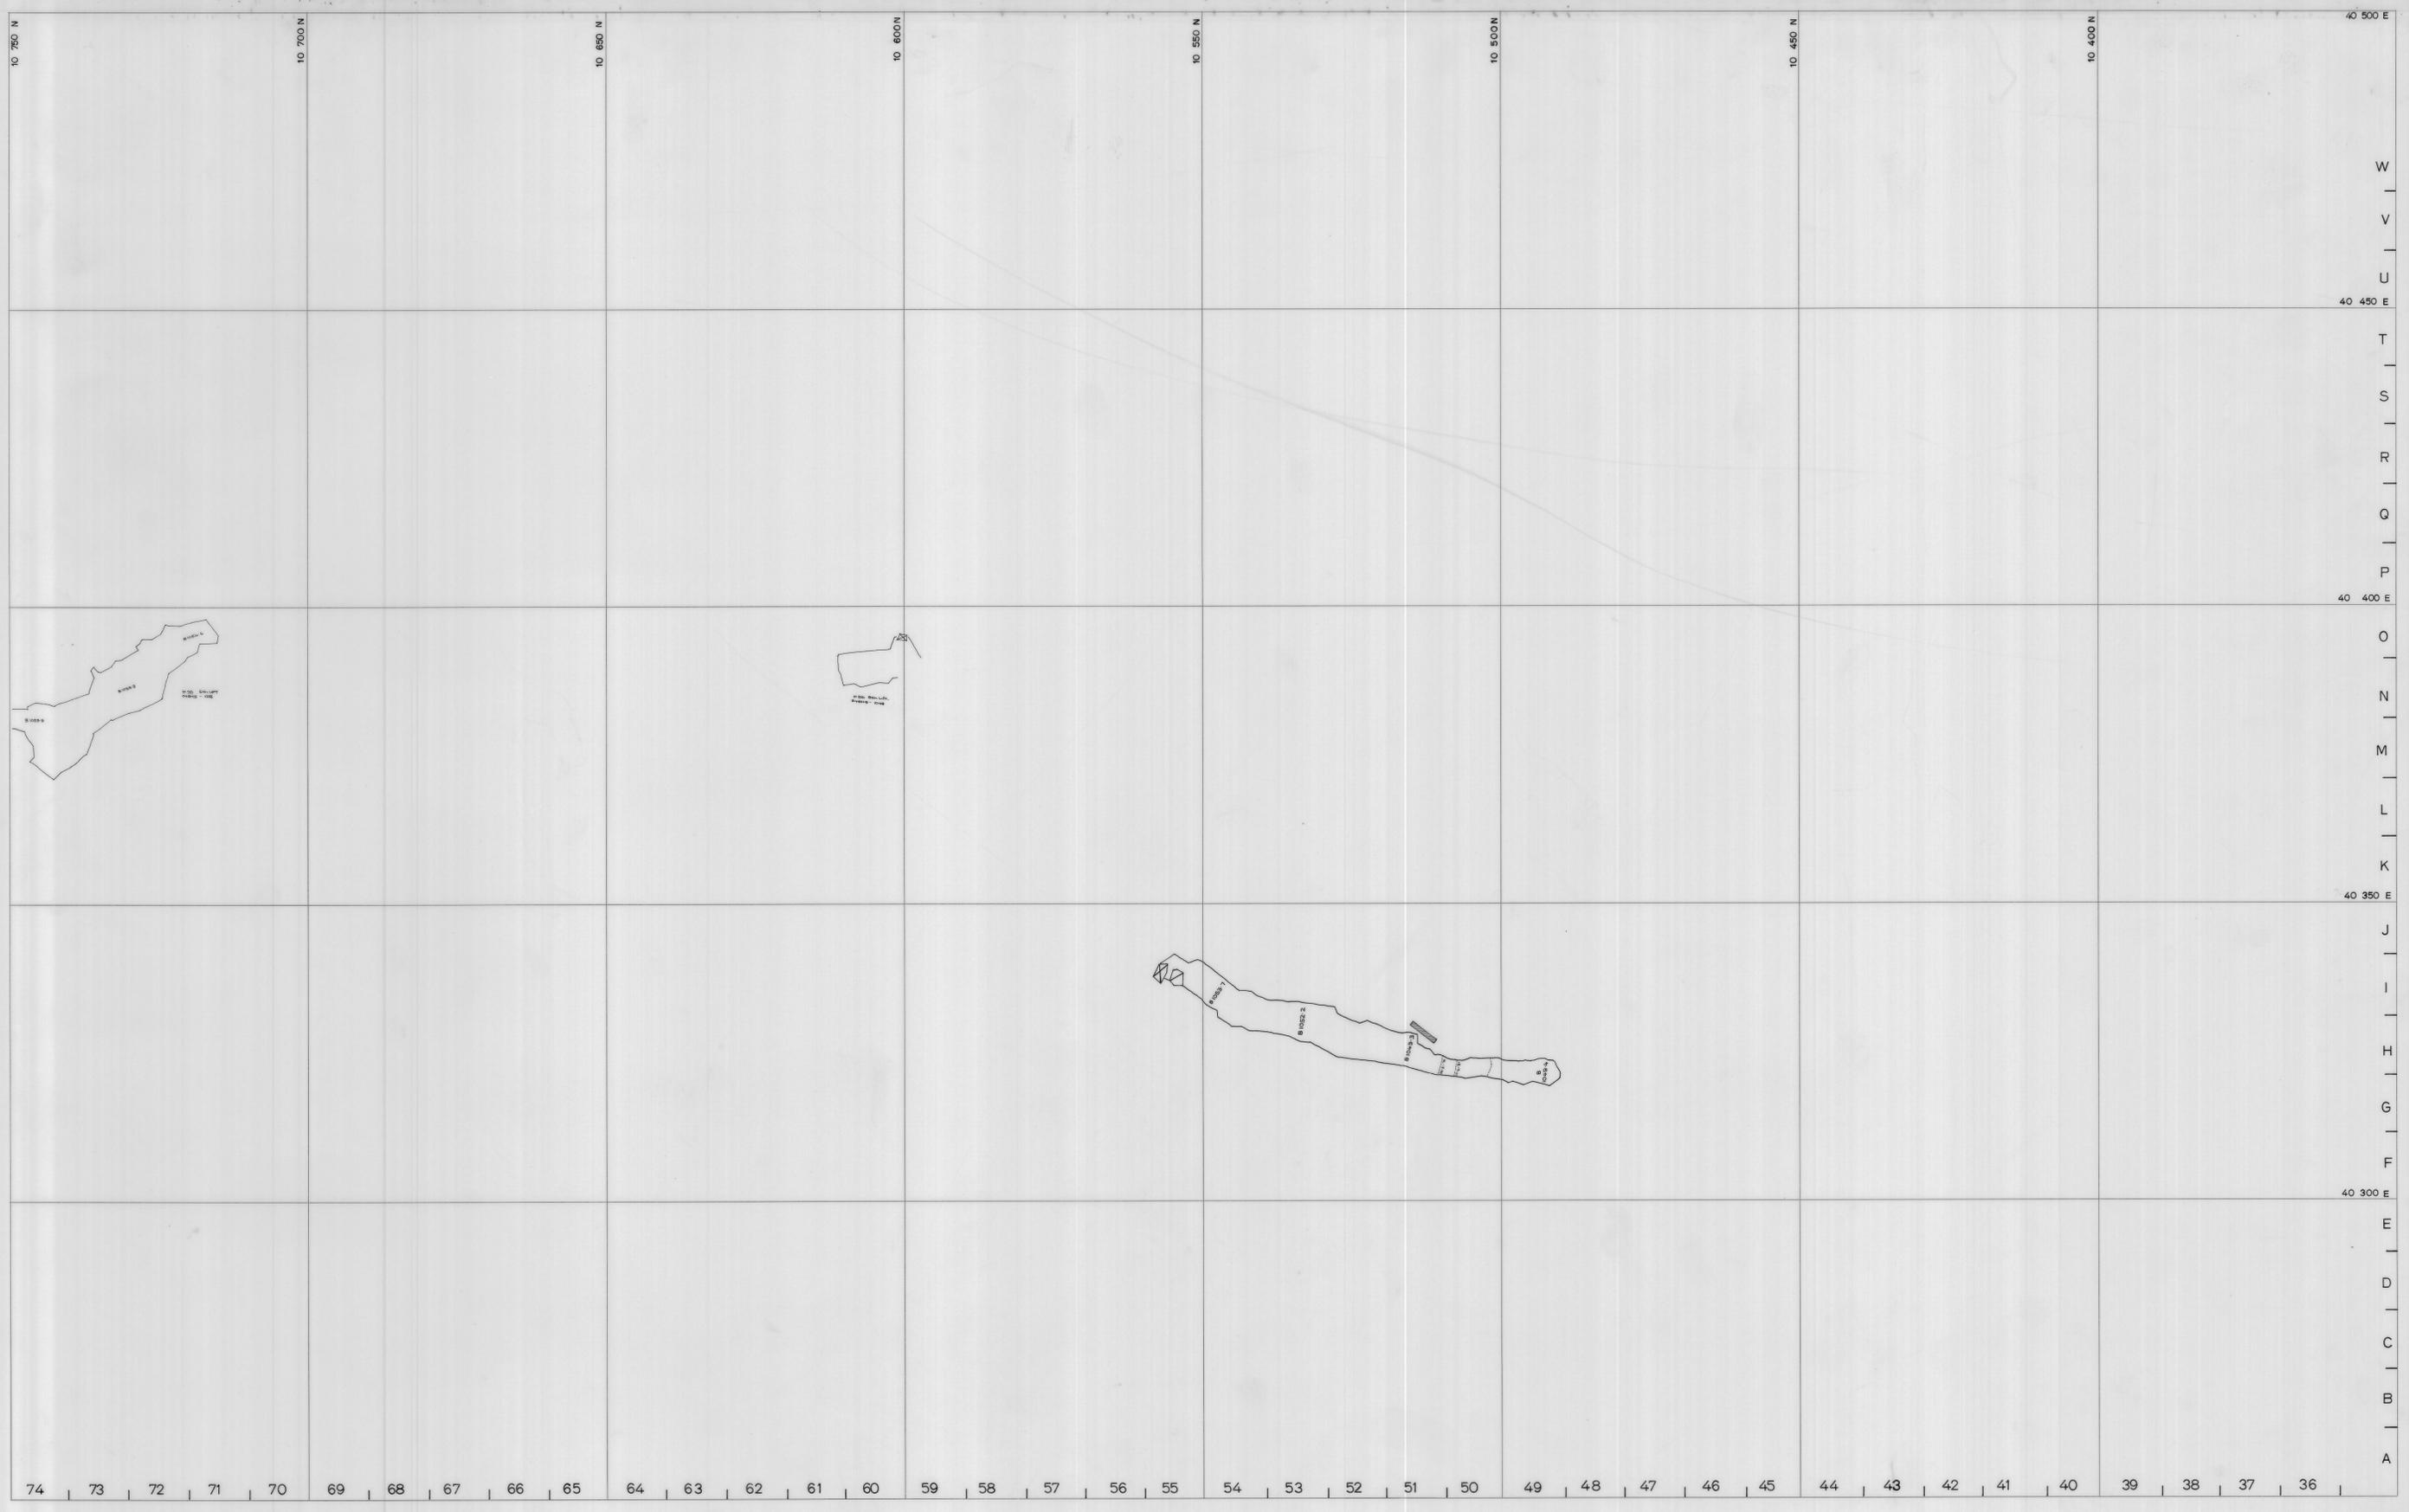

SCALE 1:500



north

LOCATION
BOLD HEAD MINE

SUBJECT
H 50
A LENS CAVO STOPE
[1st Lift]

KING ISLAND SCHEELITE
A DIVISION OF WARMAN INTERNATIONAL

GRASSY KING ISLAND

PLAN NUMBER
04BH15-103-99