




5 cm

0374_2253

DM
C. P. I.
1976

04DM19-10'66,
566 040N

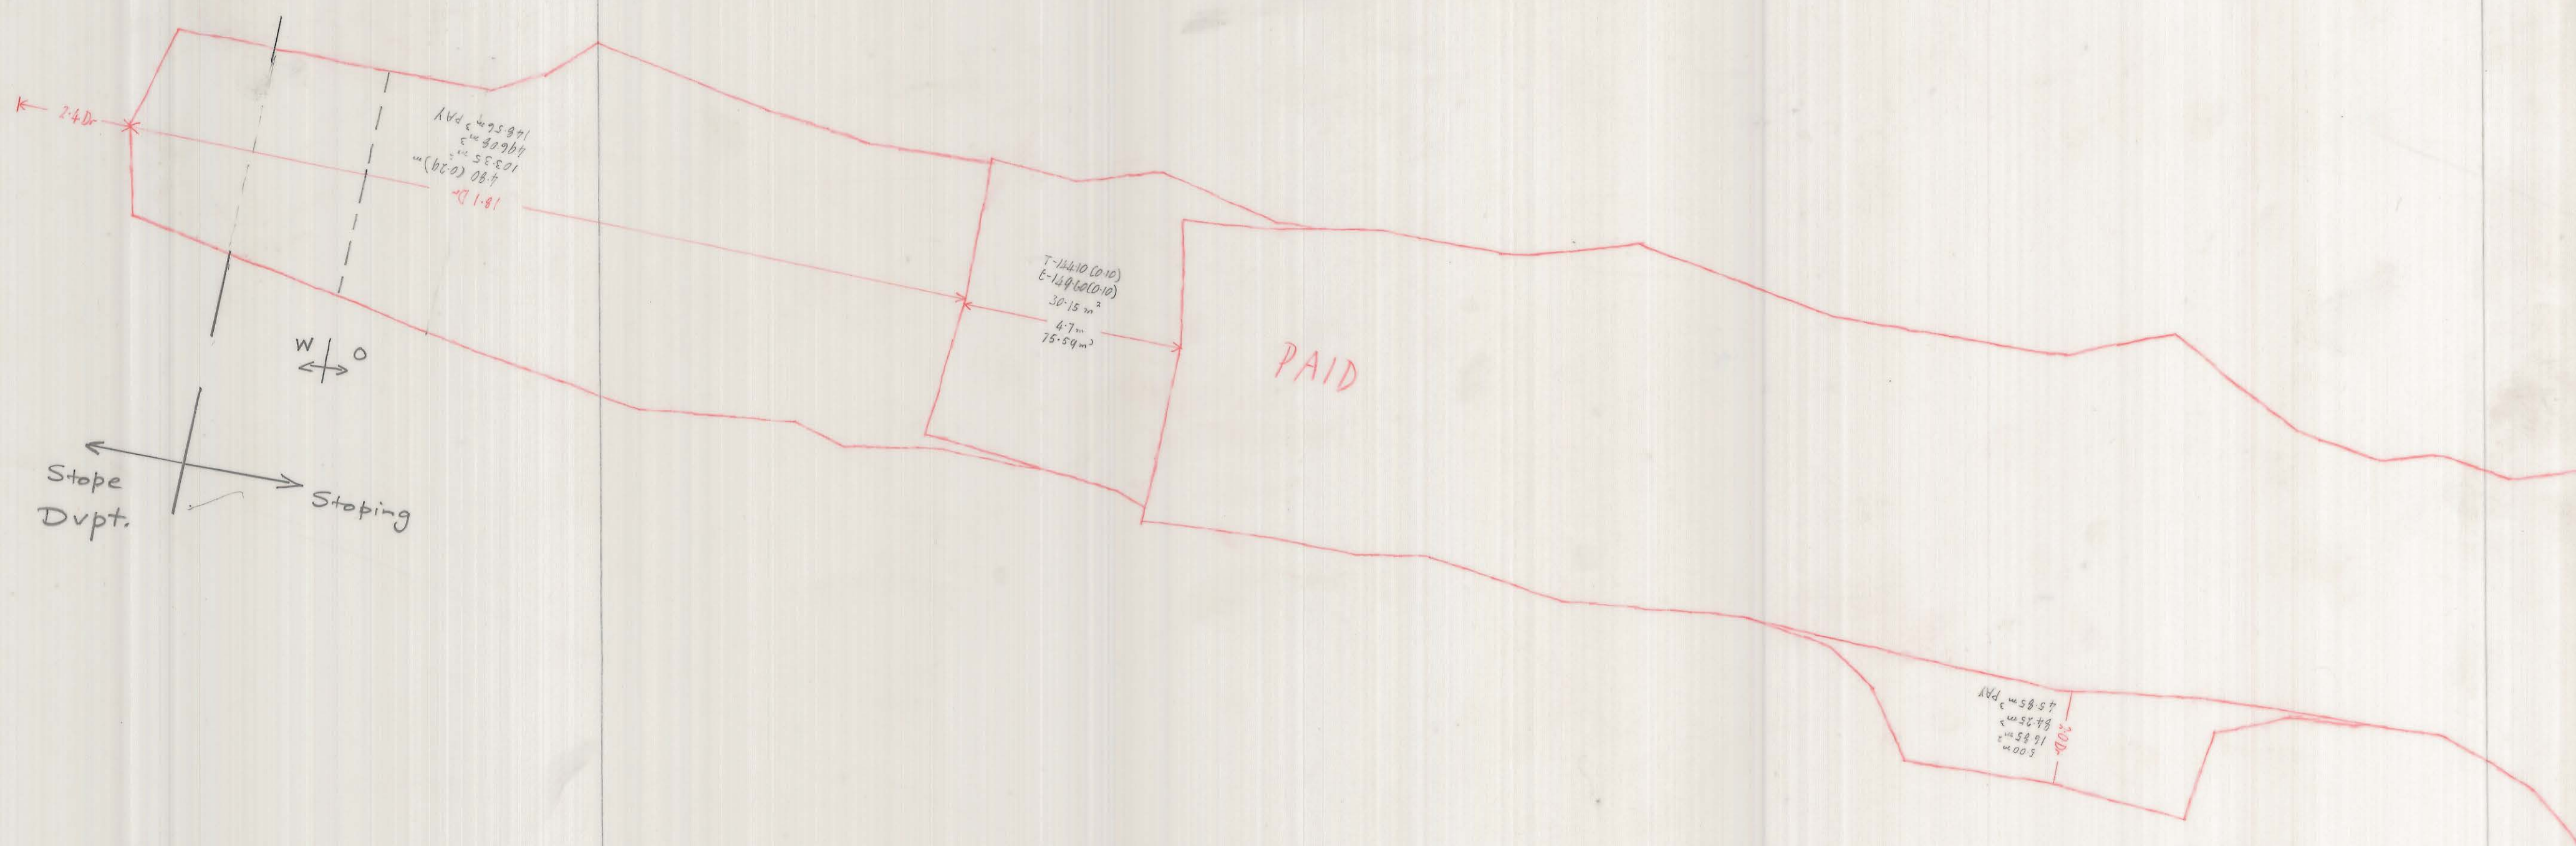

OS

566 040N

566 030N

566 030N