


0374_2254

040M19-1068

DM 130/173 11100 1976

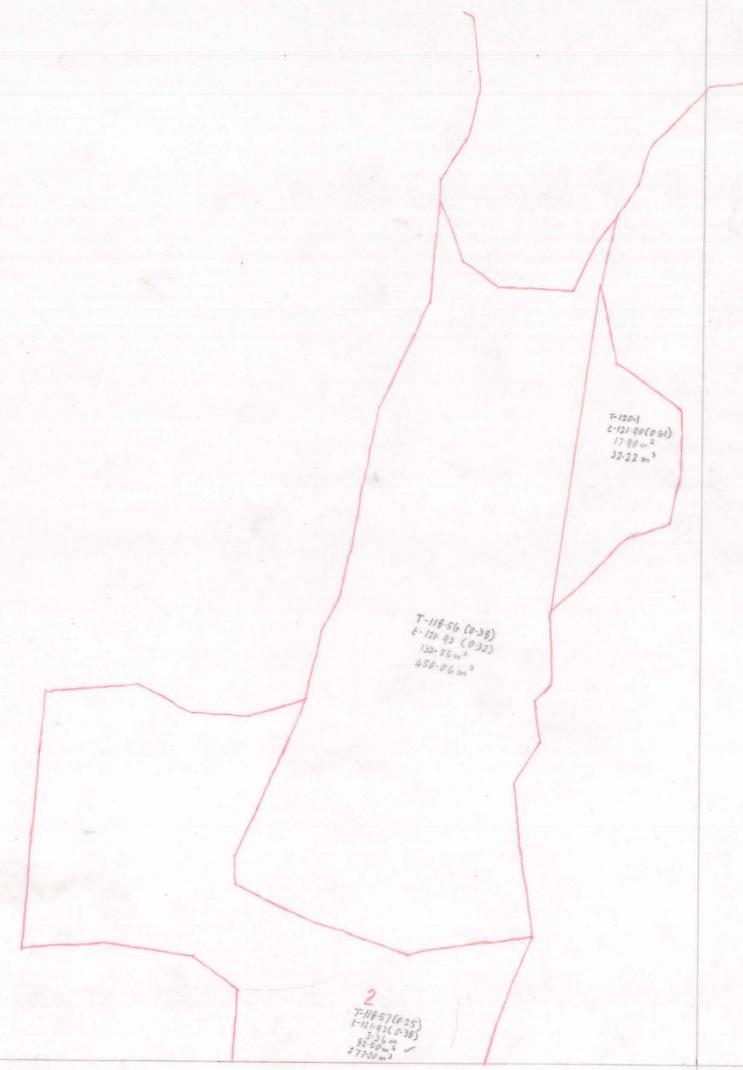

RUE Adrance