





0374_2256

DM
-1:100
C.P.T. 1070
-150m L U/C

040M19-1071 562.000N

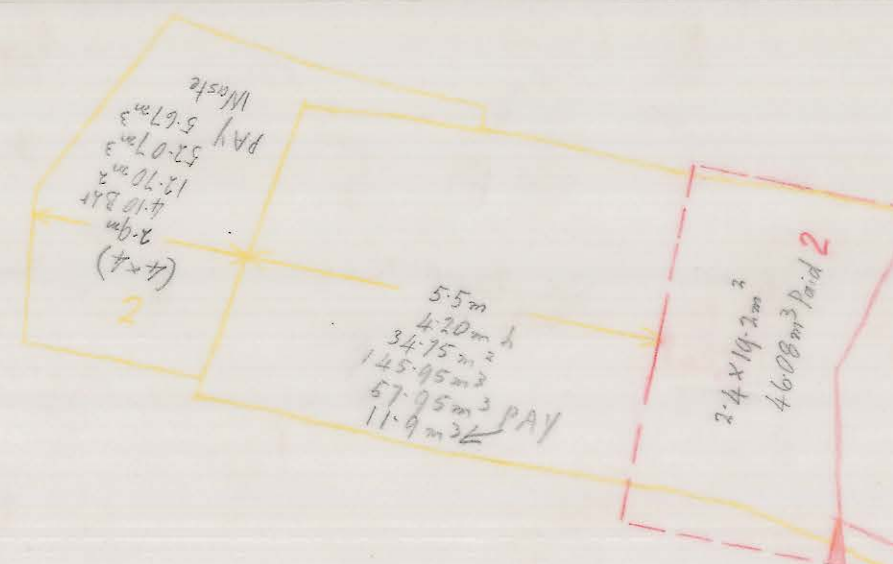

2nd PAY 04 DM 11-1125
CP 64 C Pit
(4x4) 23.90 Dr
2.9 Dr 232.92m² Strip
27.09m² Strip

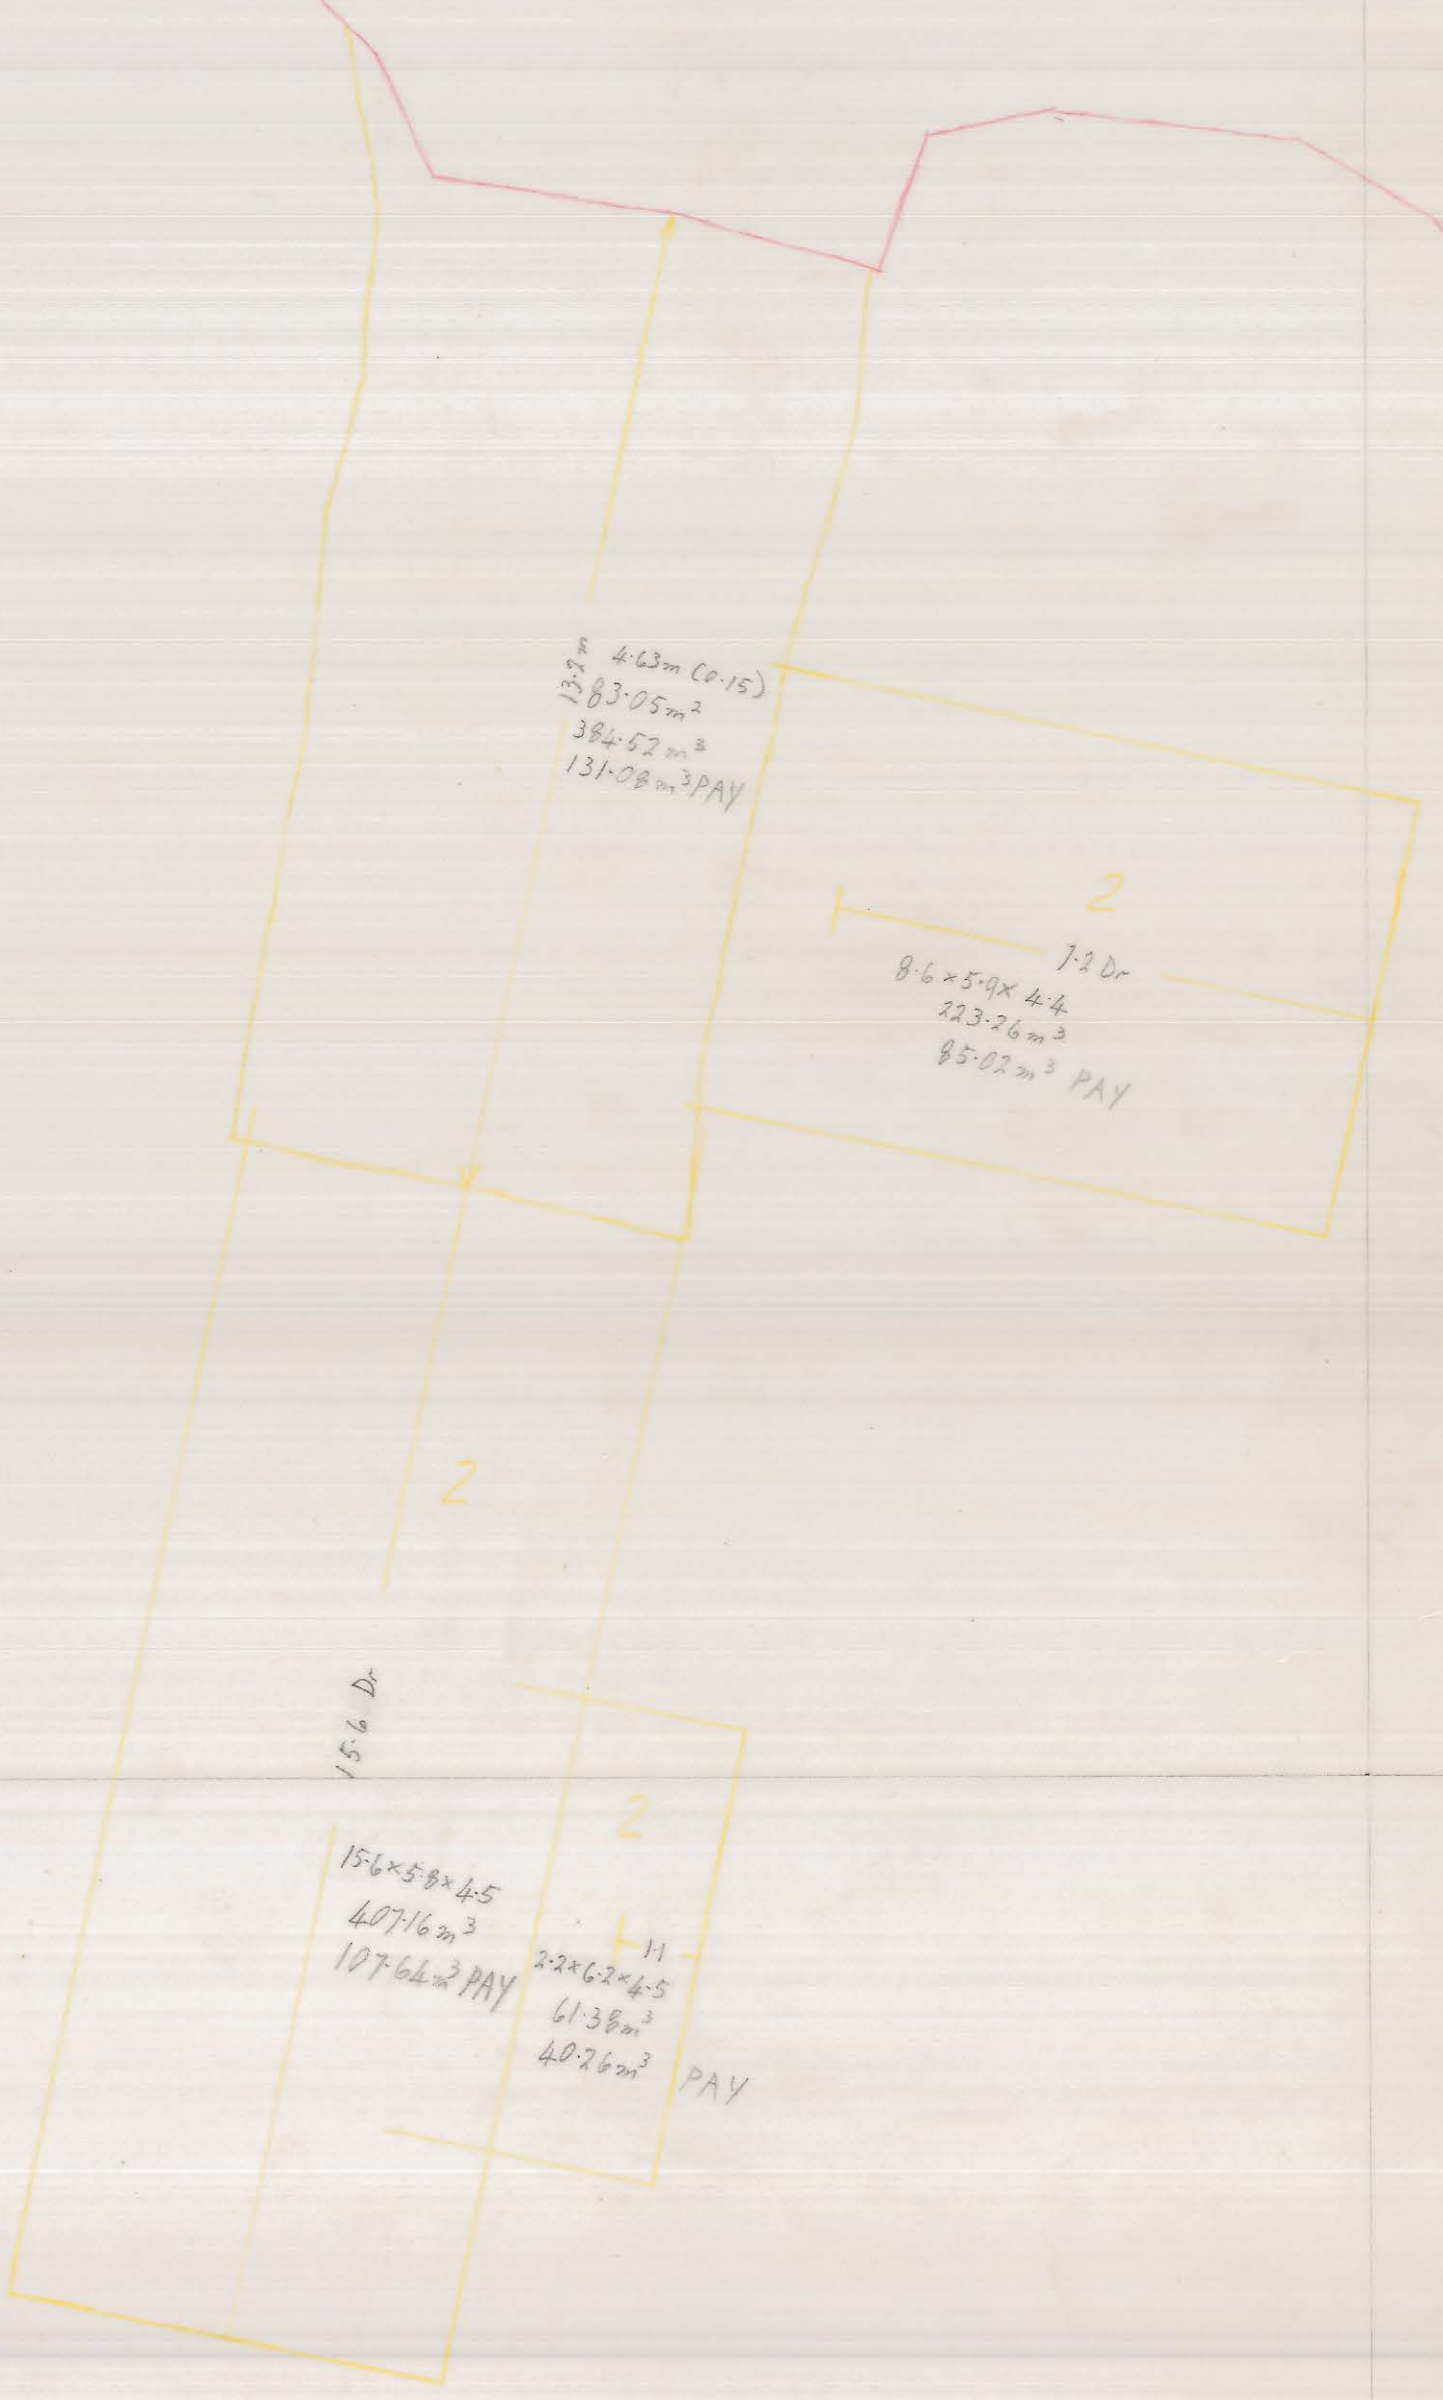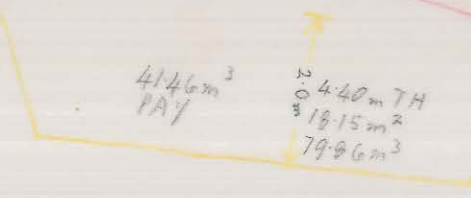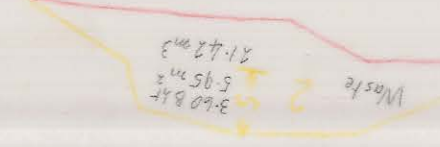

712

042N

564.030N

270.030E

270.030E