

0374_2298

04 DM 11-1005

DOLPHIN
100 Scale
MAIN DECLINE
1-22-25


04 DM 11-1005

Adjoins 1-22-21

14

1-22-30 Adjoins

13

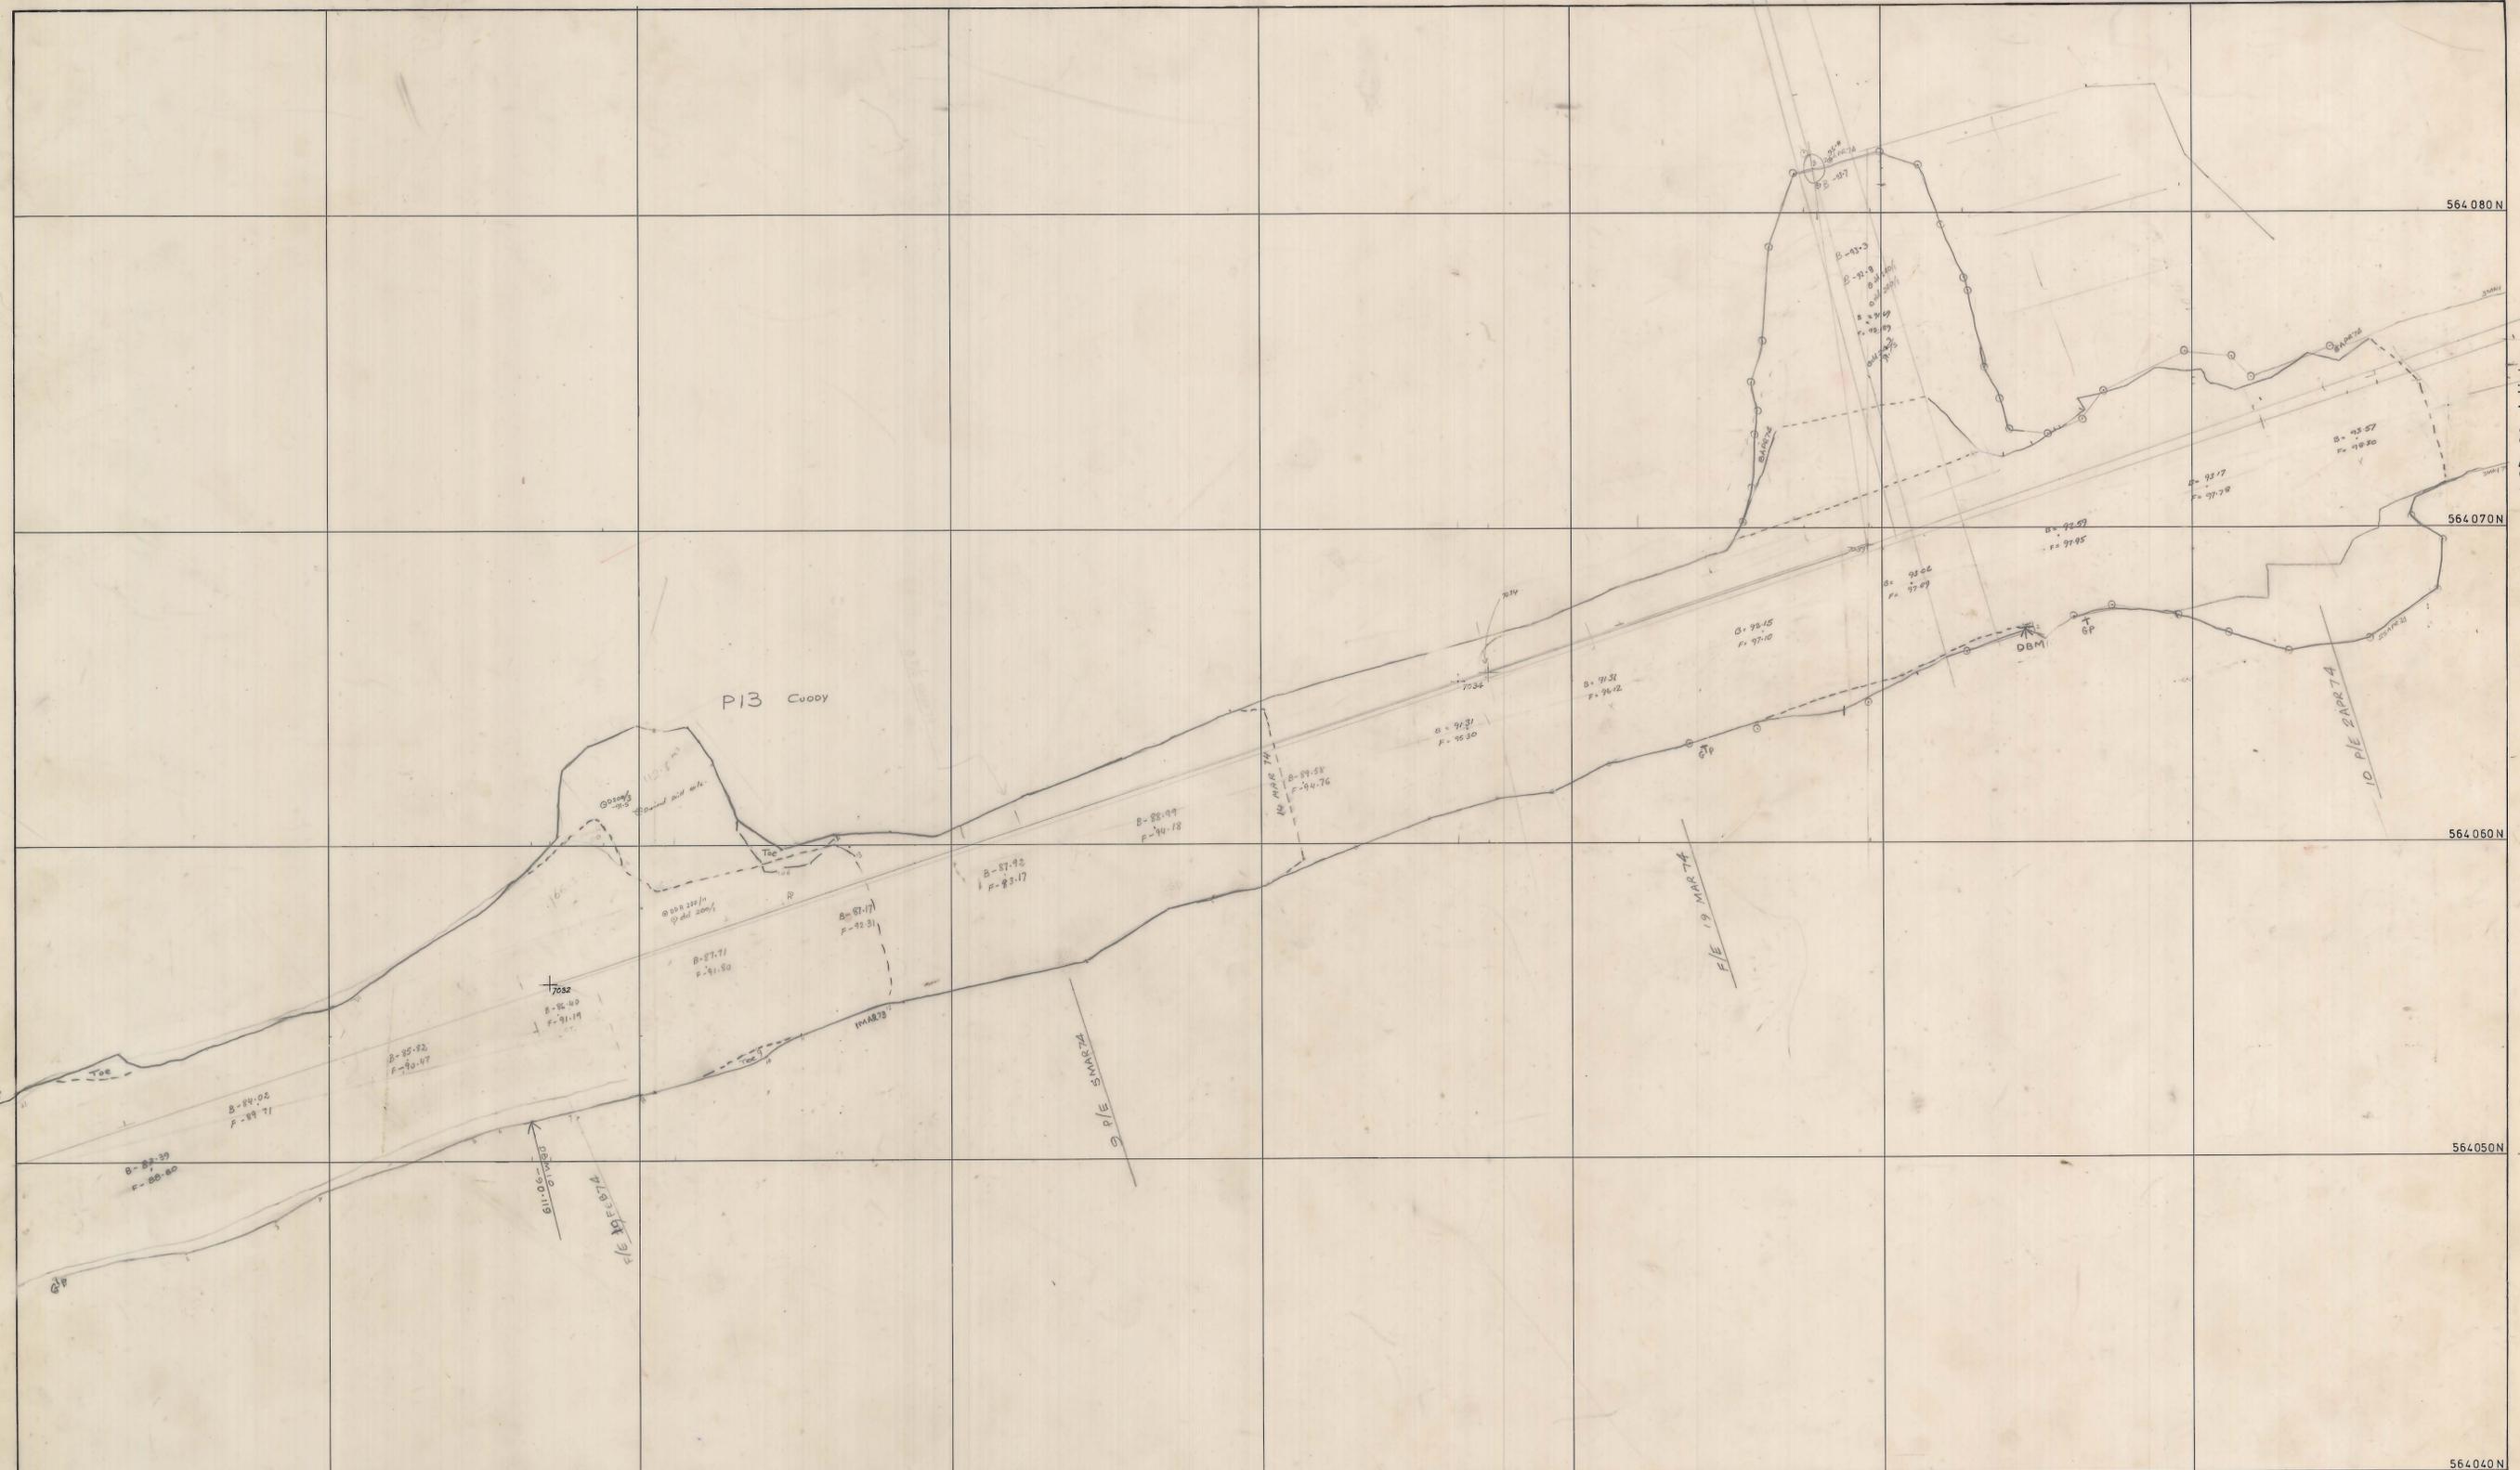

| | | | | |
|-----------|-------------|--------|-------------|-------------|
| 7028/7032 | 72° 00' 56" | 22.112 | 564 055.603 | 220 197.123 |
| 7032/7034 | 71° 53' 56" | 31.760 | 564 065.469 | 220 227.305 |

220 190 E

220 200 E

220 210 E

220 220 E

220 230 E

220 240 E

220 250 E

564 040 N

564 050 N

564 060 N

564 070 N

564 080 N

KING ISLAND SCHEELITE LTD.

Scale 1:100

A1

04 DM 11-1005

DOLPHIN MINE

Working plan
MAIN DECLINE

DATE AS SHOWN
SURVEYED M.G.M.
DRAWN M.G.M.
TRACED
CHECKED M.G.M.