


0374_2299

04DM01-1005

DOLPHIN MINE
- 150m AL. ZONE
CHECK SURVEY

04DM14 - 1005

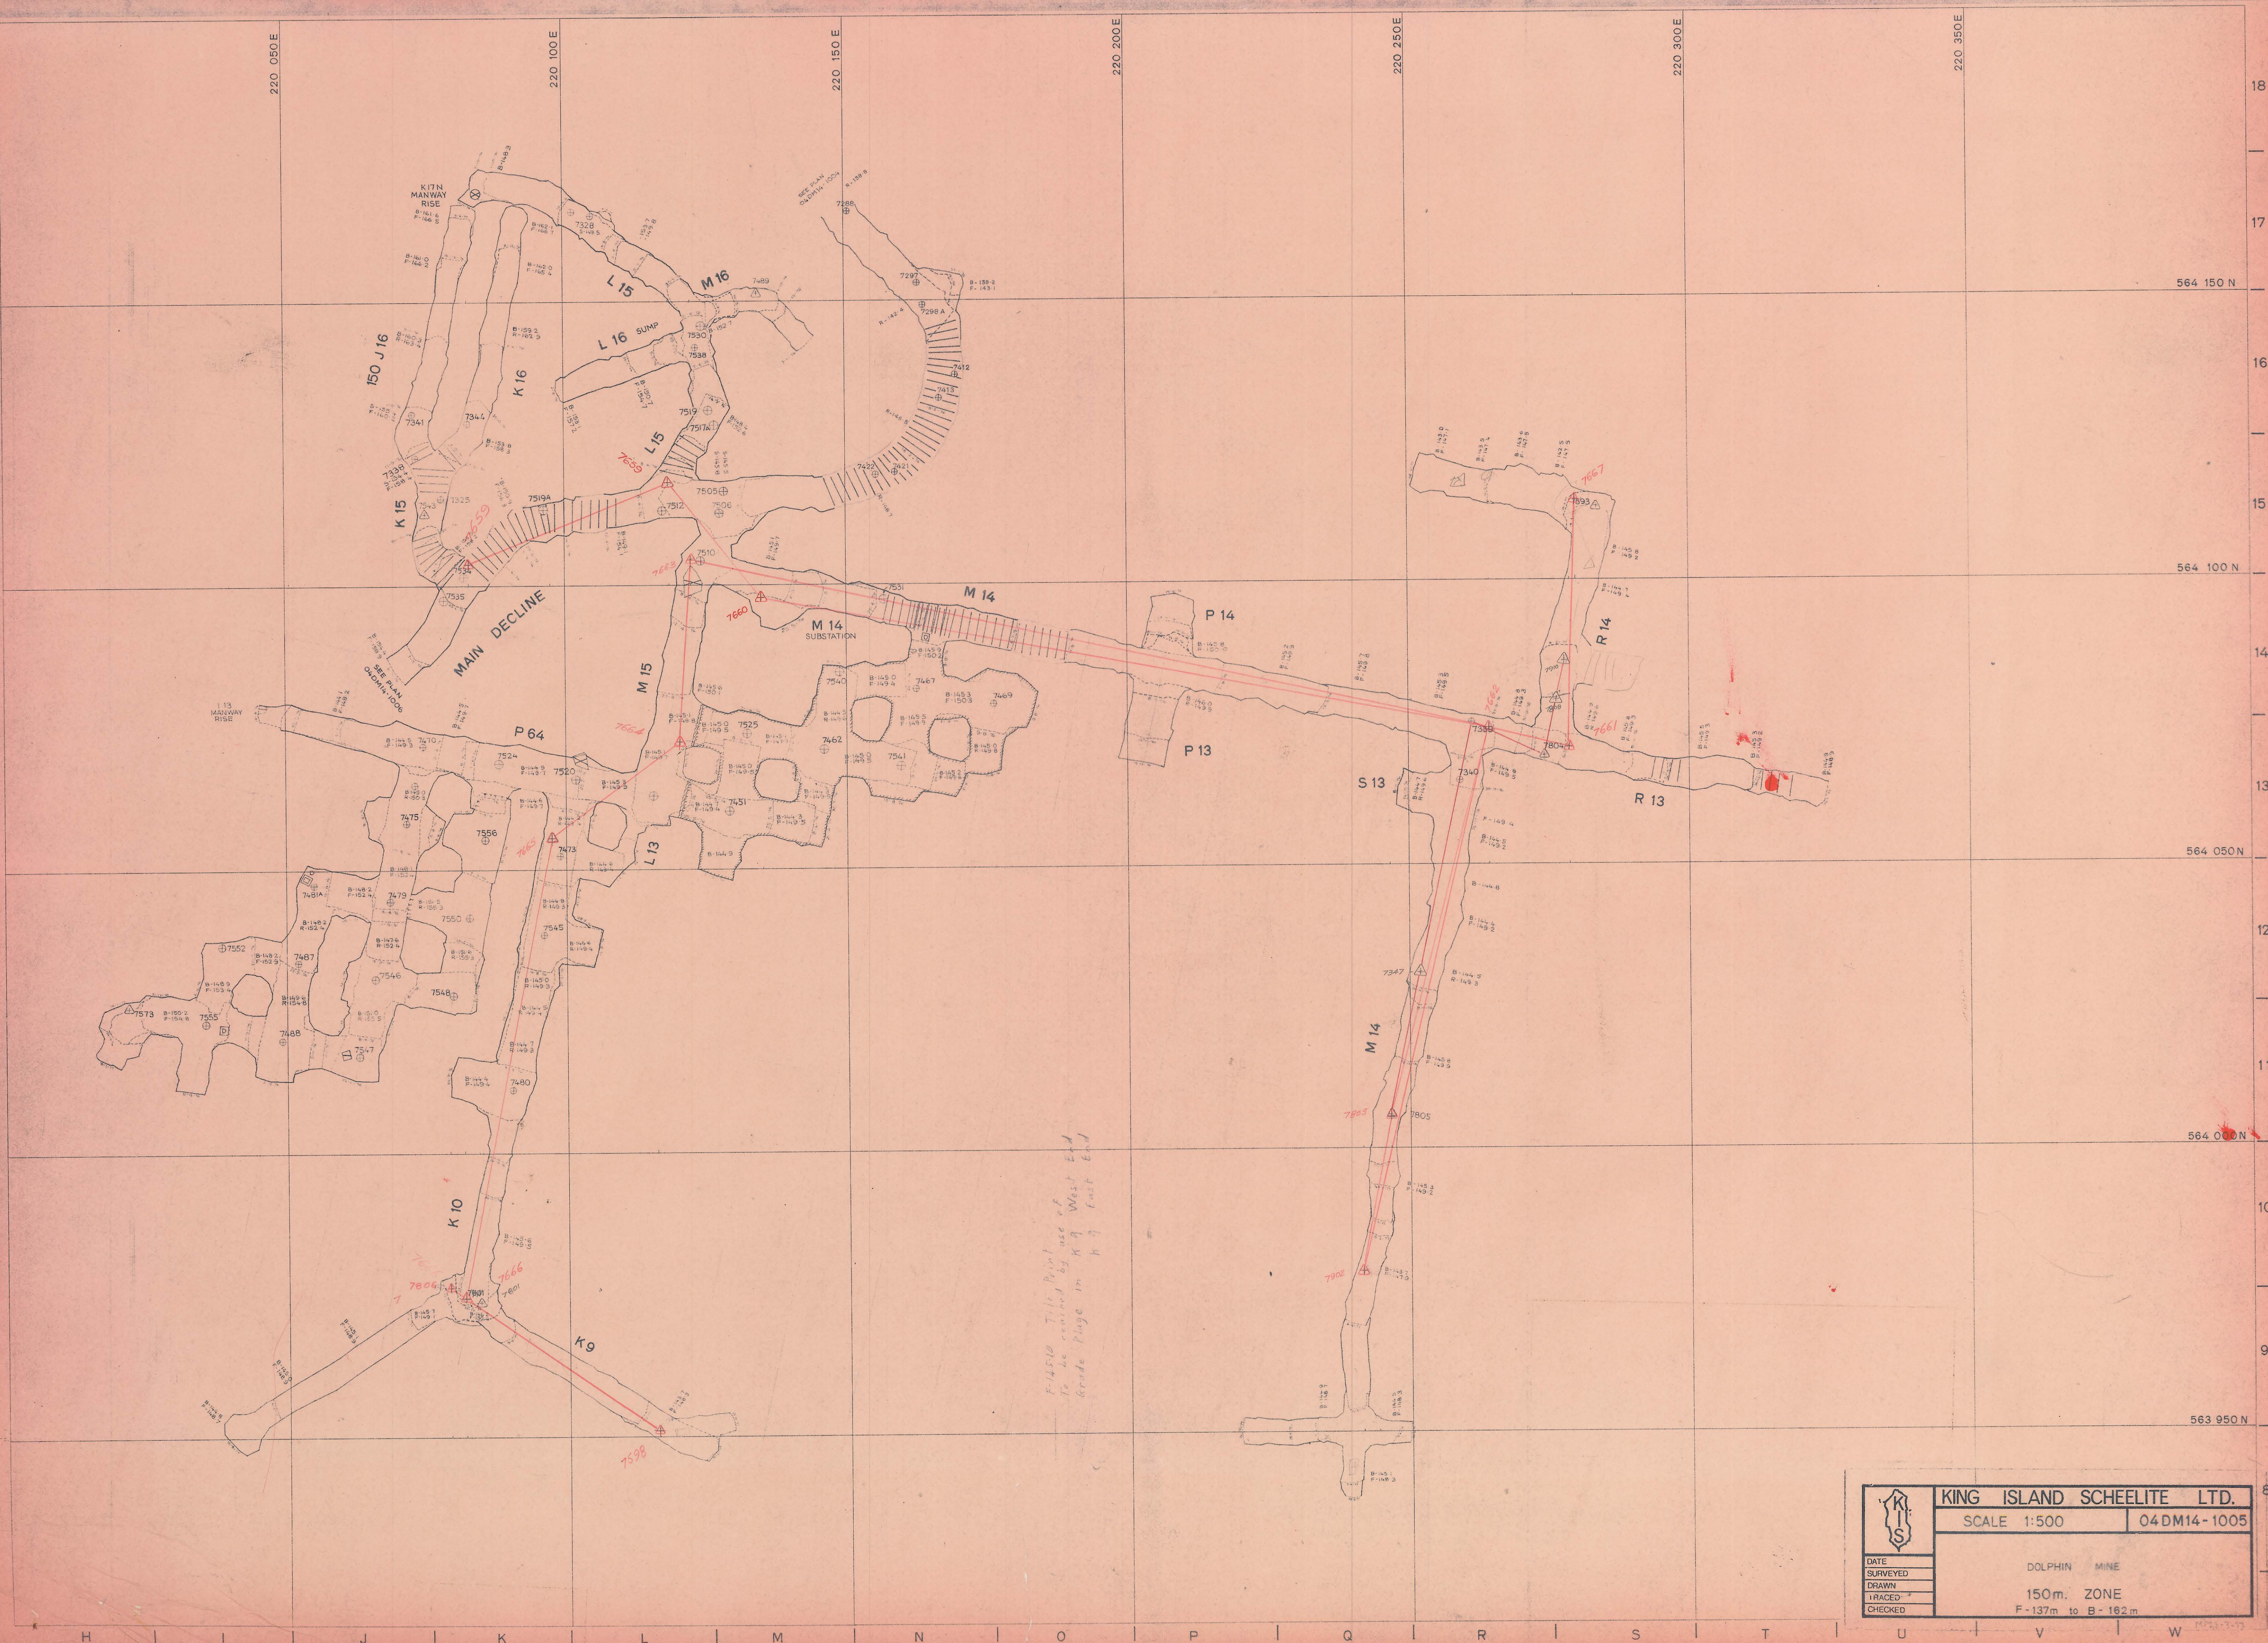

*F-14510 Till Point
To be revised by K 9 West End
Grade Page in K 9 East End*

	KING ISLAND SCHEELITE LTD.	
	SCALE 1:500	04DM14-1005
	DOLPHIN MINE	
	150m. ZONE	
	F-137m to B-162m	

DATE	
SURVEYED	
DRAWN	
TRACKED	
CHECKED	