


27 JUN 1981

0374-220

04BH14-1004

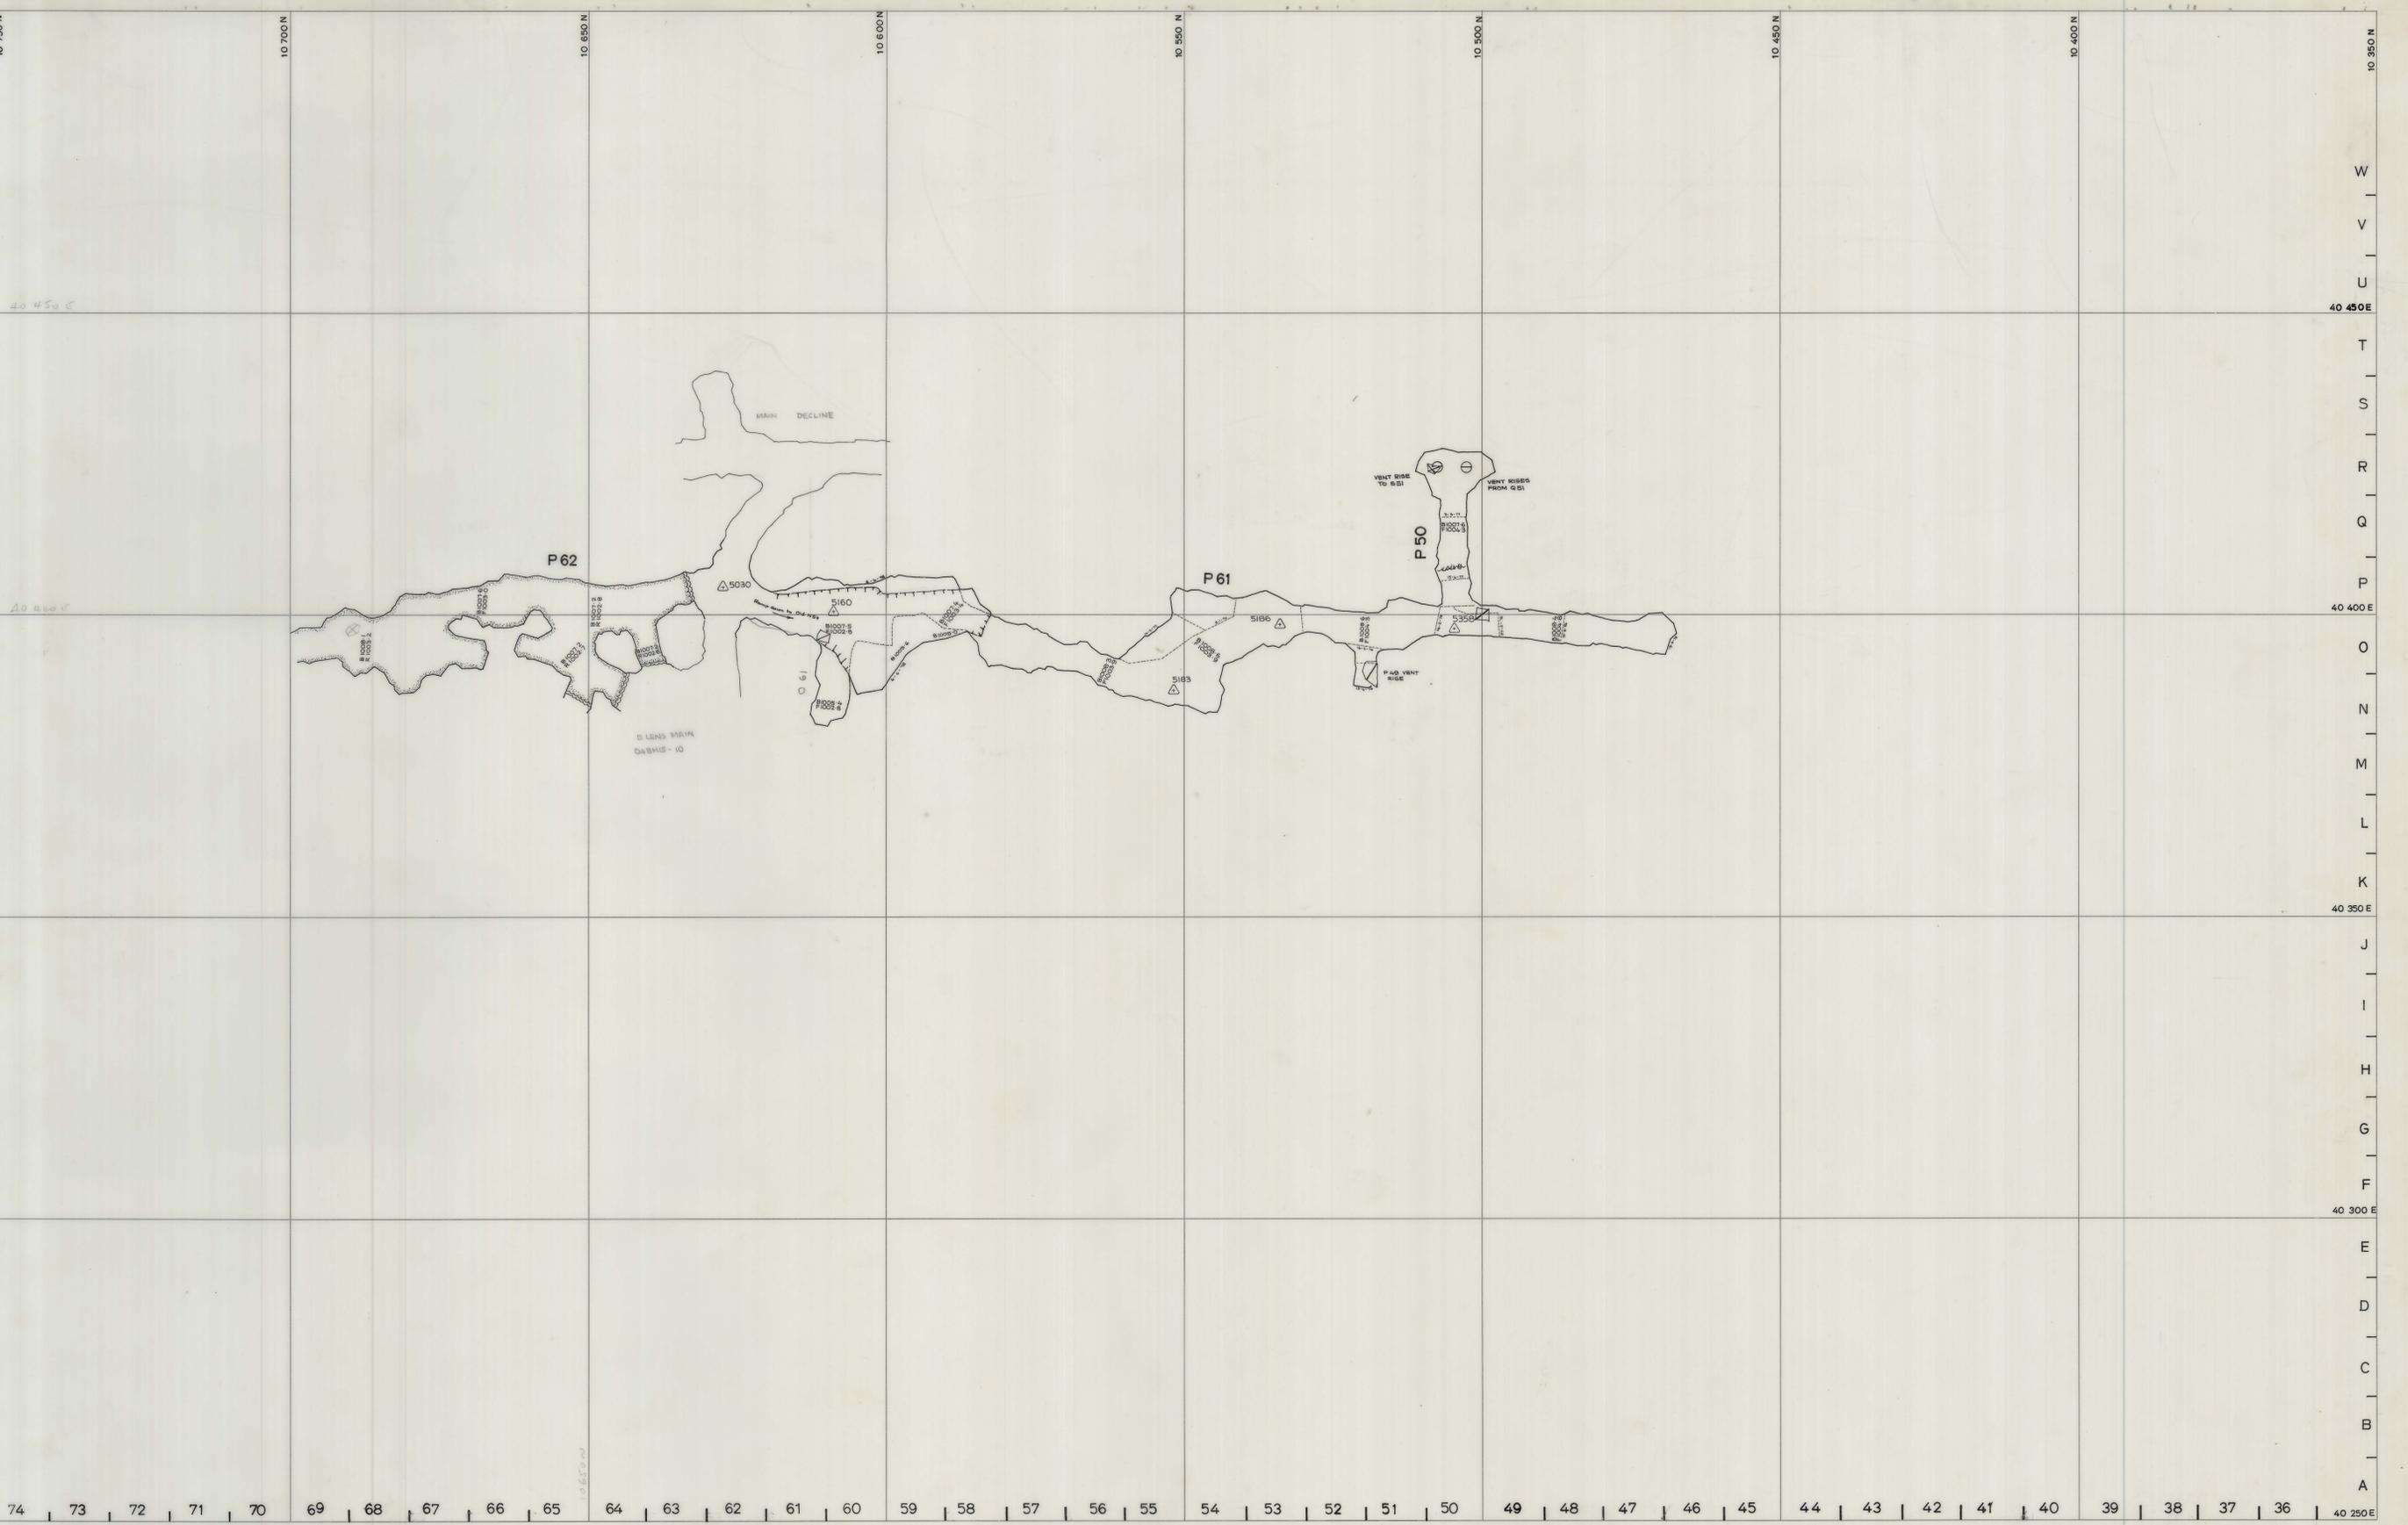


SCALE 1:500

LOCATION BOLD HEAD MINE

SUBJECT B. LENS FAULT BLOCK

north

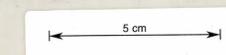

KIS KING ISLAND SCHEELITE
 A DIVISION OF WARMAN INTERNATIONAL
 GRASSY KING ISLAND
 PLAN NUMBER 04BH14 - 1004