




0374_2300

04DM12-1003

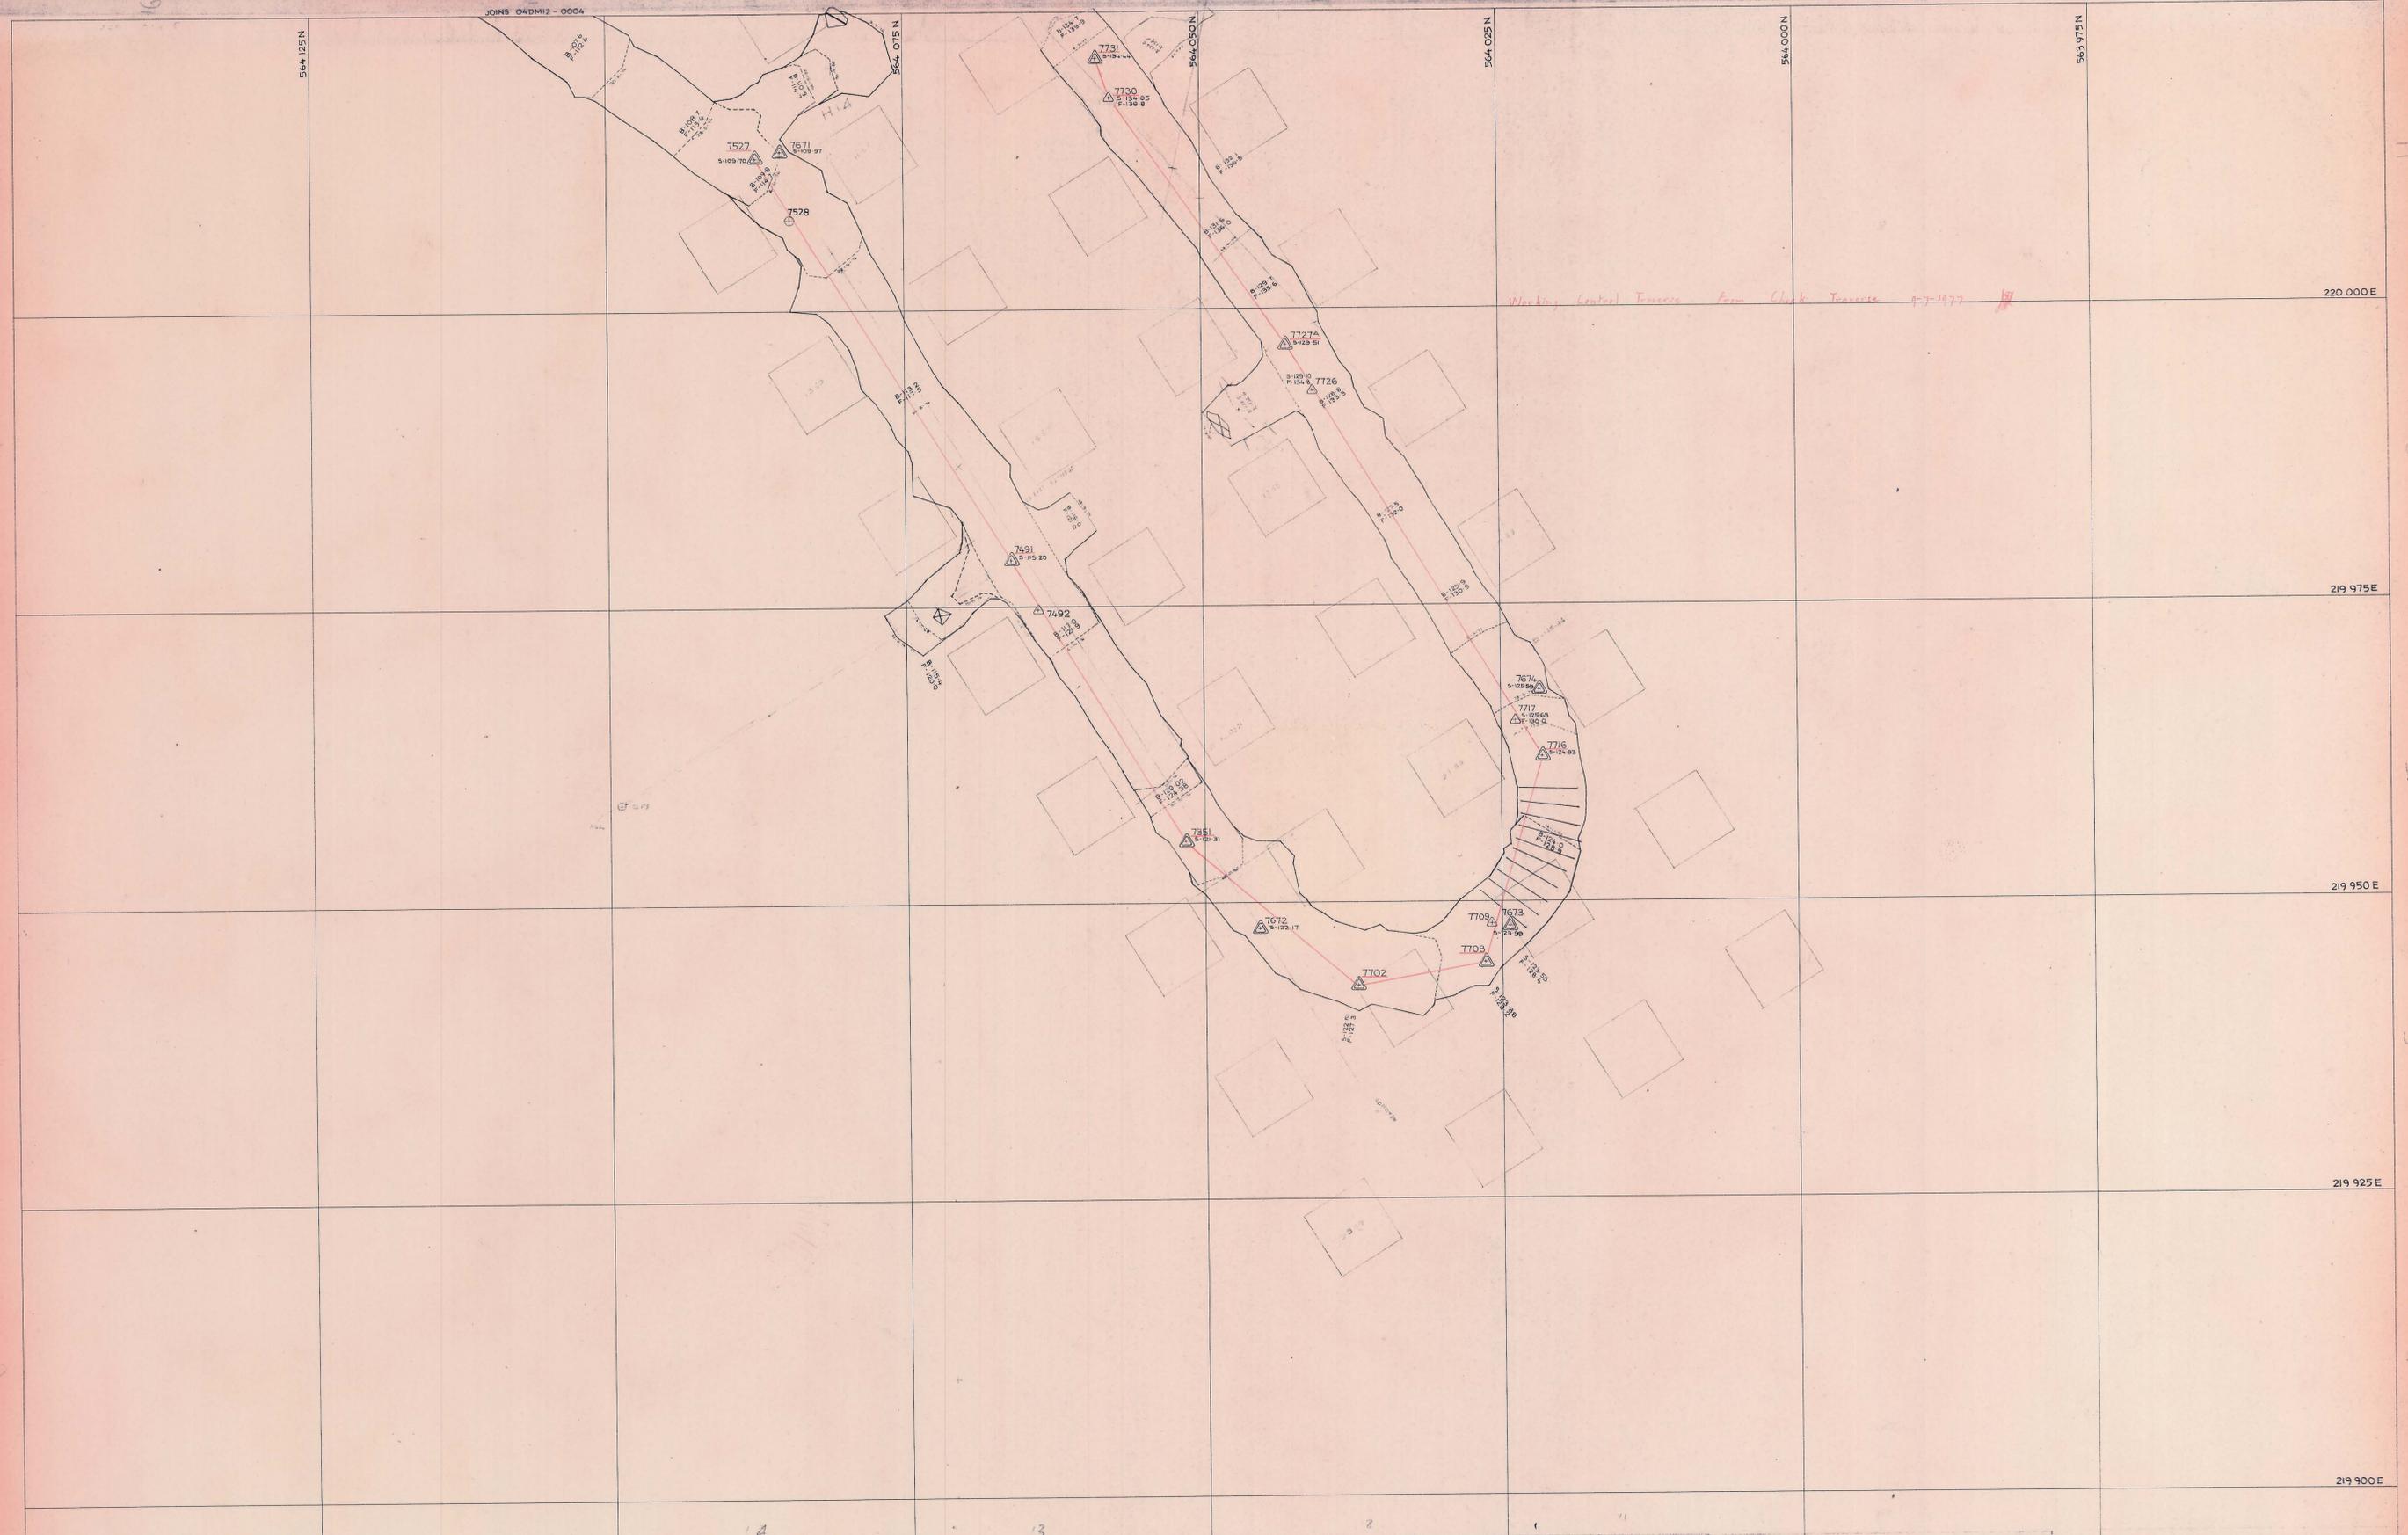

SCALE 1:250	 north	LOCATION DOLPHIN MINE	 A DIVISION OF WARMIN INTERNATIONAL GRASSY KING ISLAND
		SUBJECT - 125m ZONE	