



27 JUN 1981

5 cm

04 DM 29 - 2001

0374\_2314

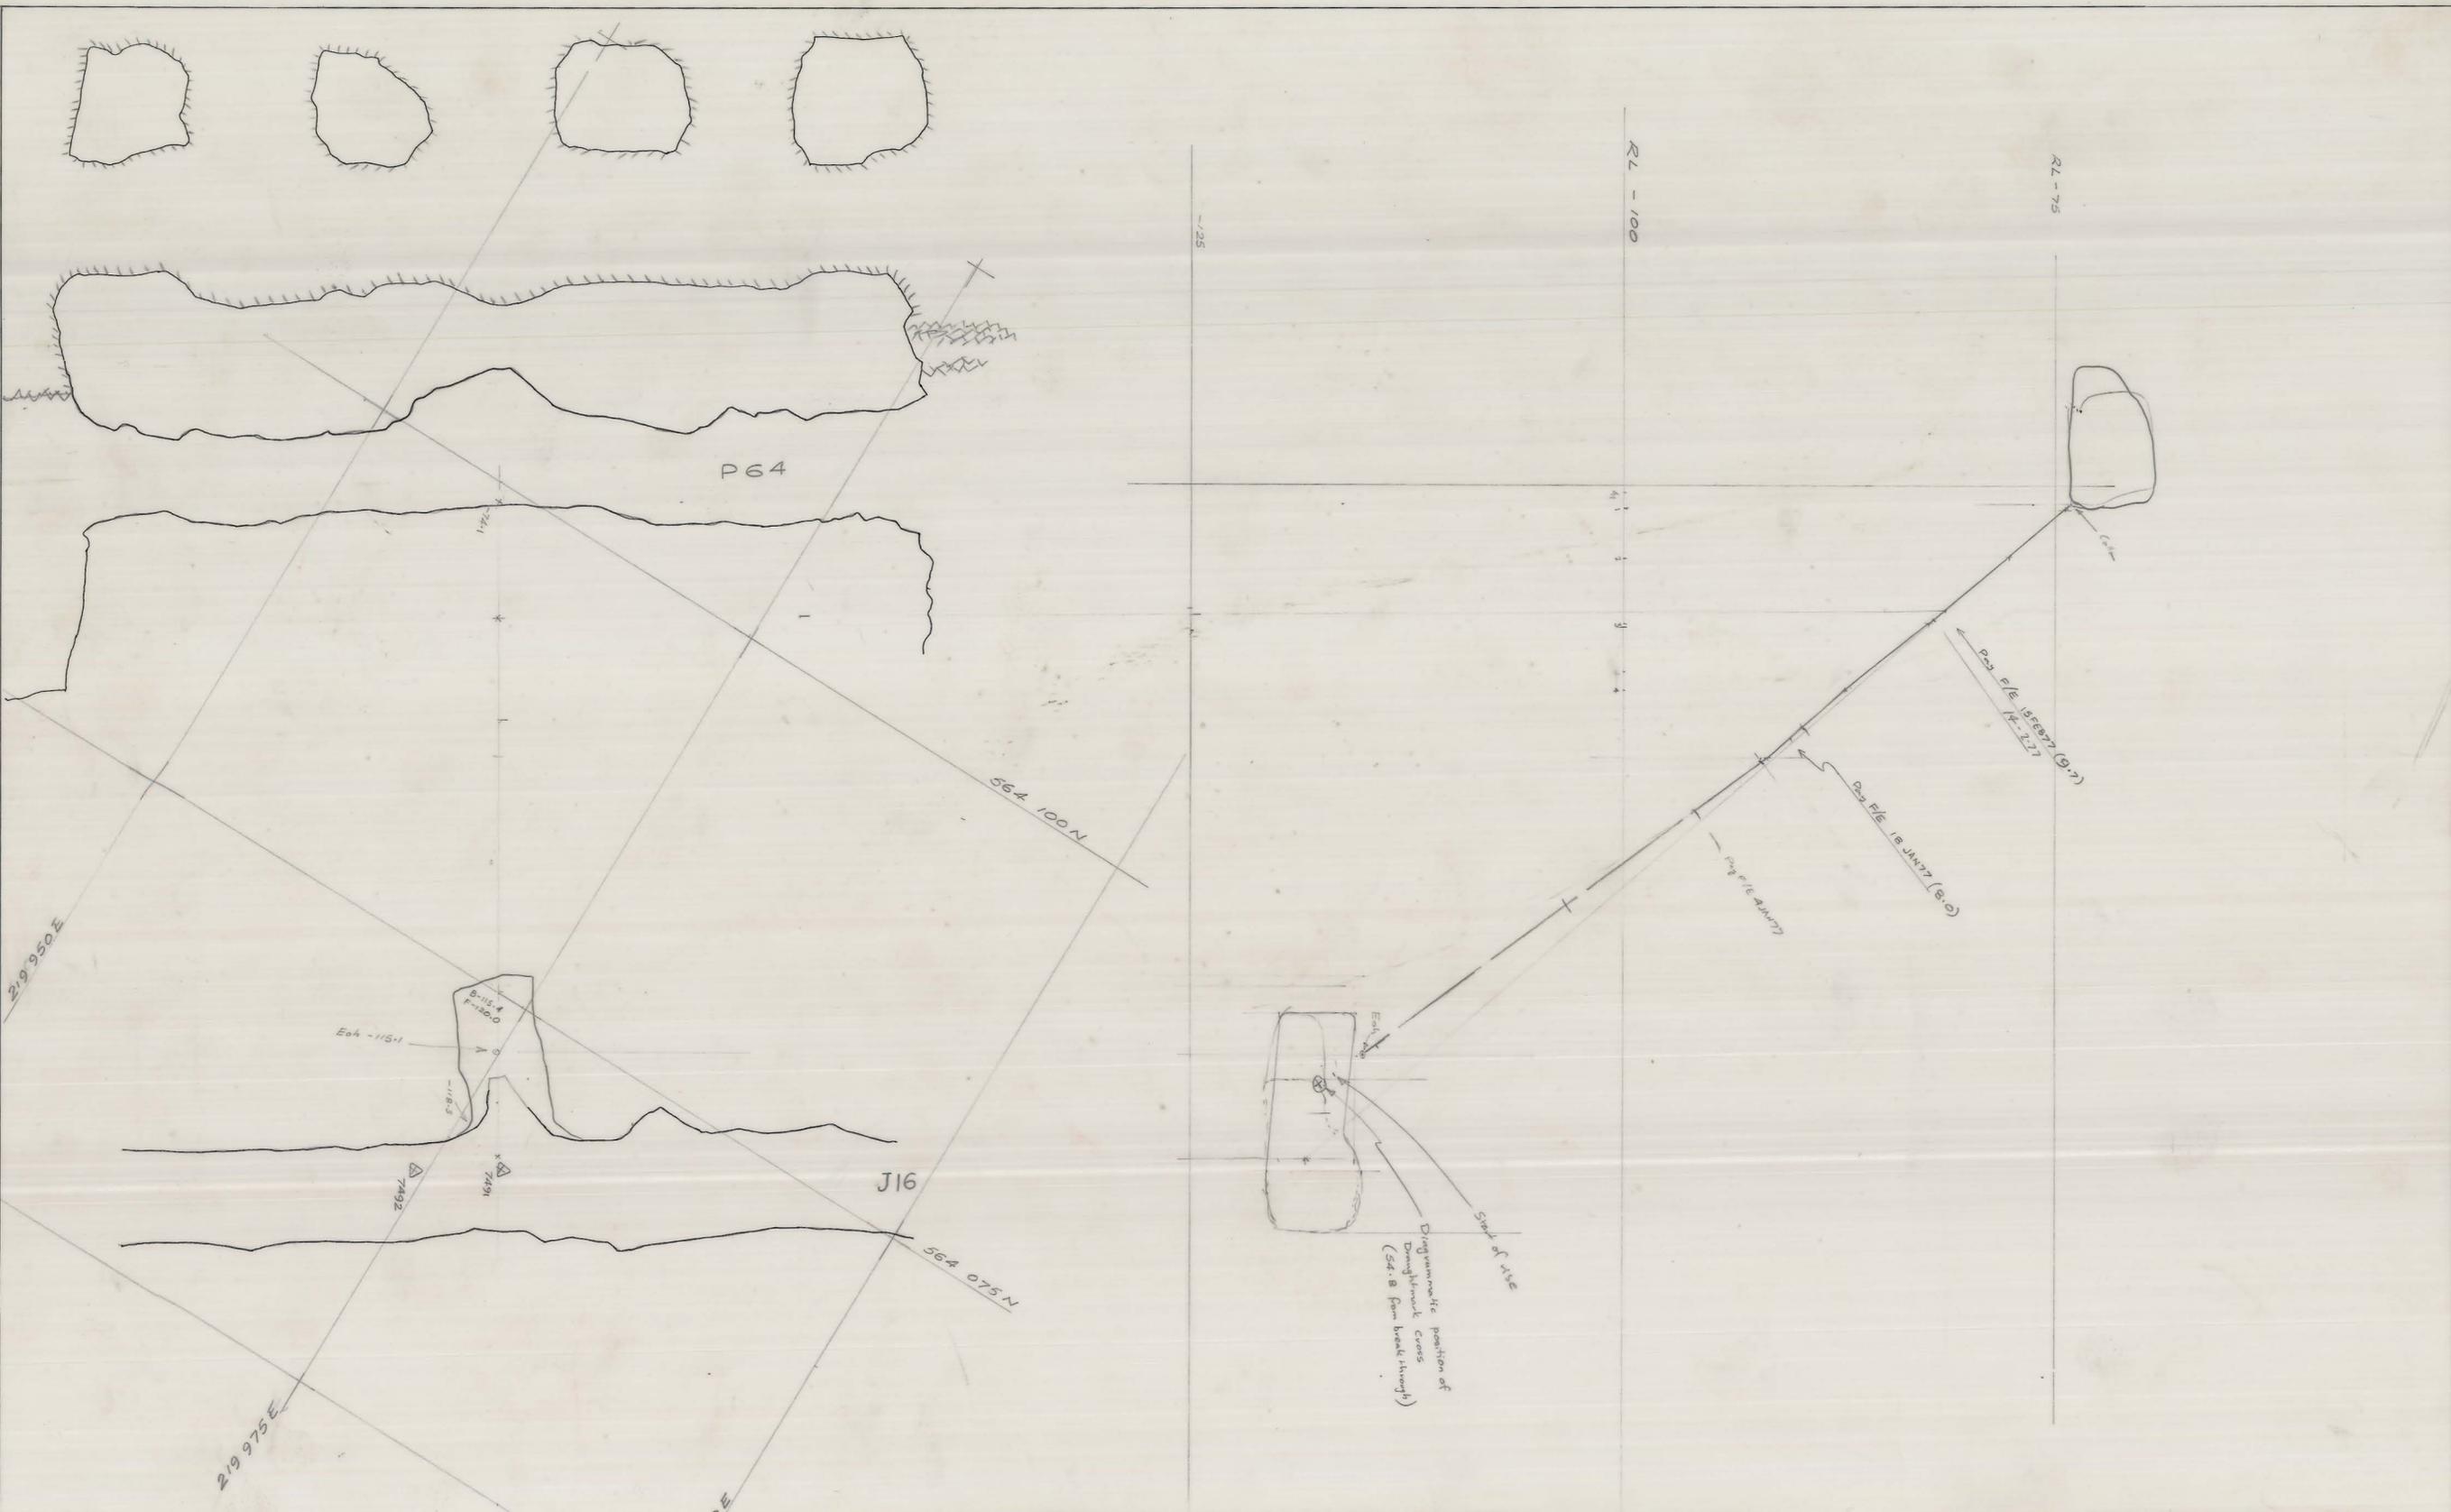

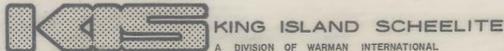SCALE 1: 250	LOCATION DOLPHIN MINE	 GRASSY KING ISLAND PLAN NUMBER 04 DM 29 - 2001
	SUBJECT G13 RISE C LENS PIT VENTILATION / MANWAY	