


27 JUN 1981

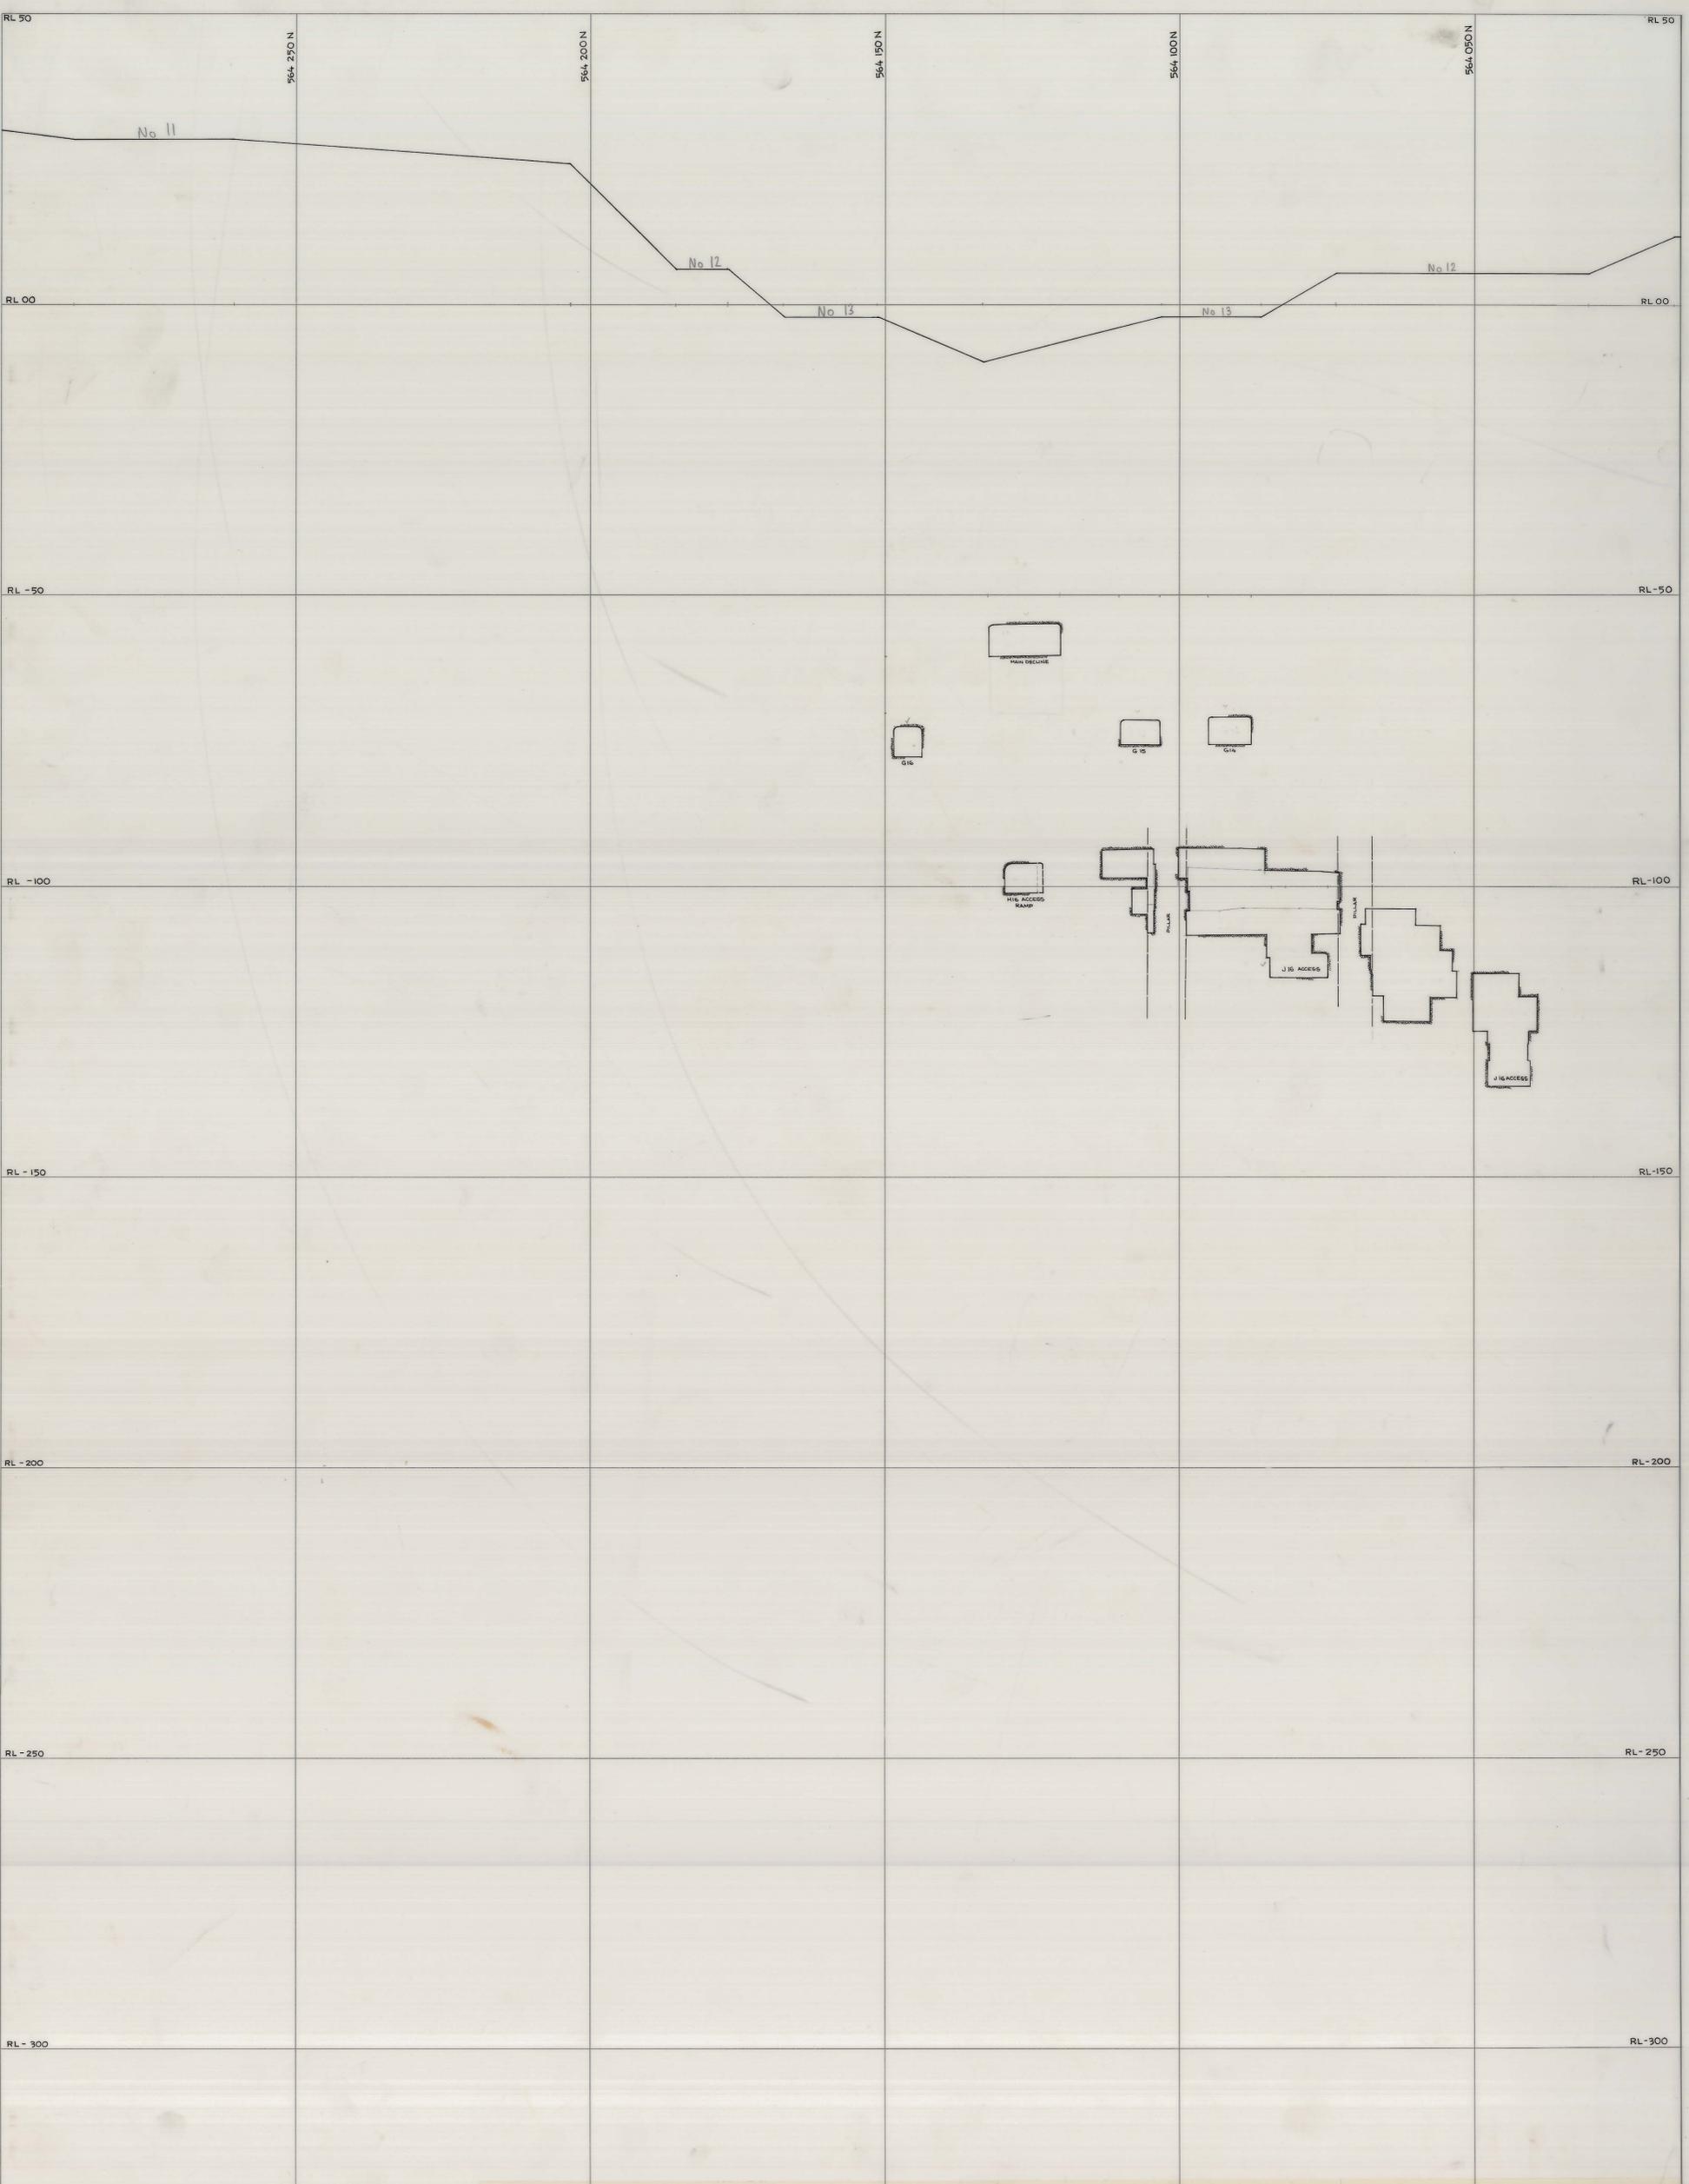

0374\_2324

04DM22-1015

SCALE 1:500

looking east

LOCATION DOLPHIN MINE

SUBJECT  
CROSSSECTION  
220 000 E

**KIS** KING ISLAND SCHEELITE  
A DIVISION OF WARMAN INTERNATIONAL

GRASSY KING ISLAND

PLAN NUMBER  
04DM22 - 1015

PA-27-3-77