


27 JUN 1981

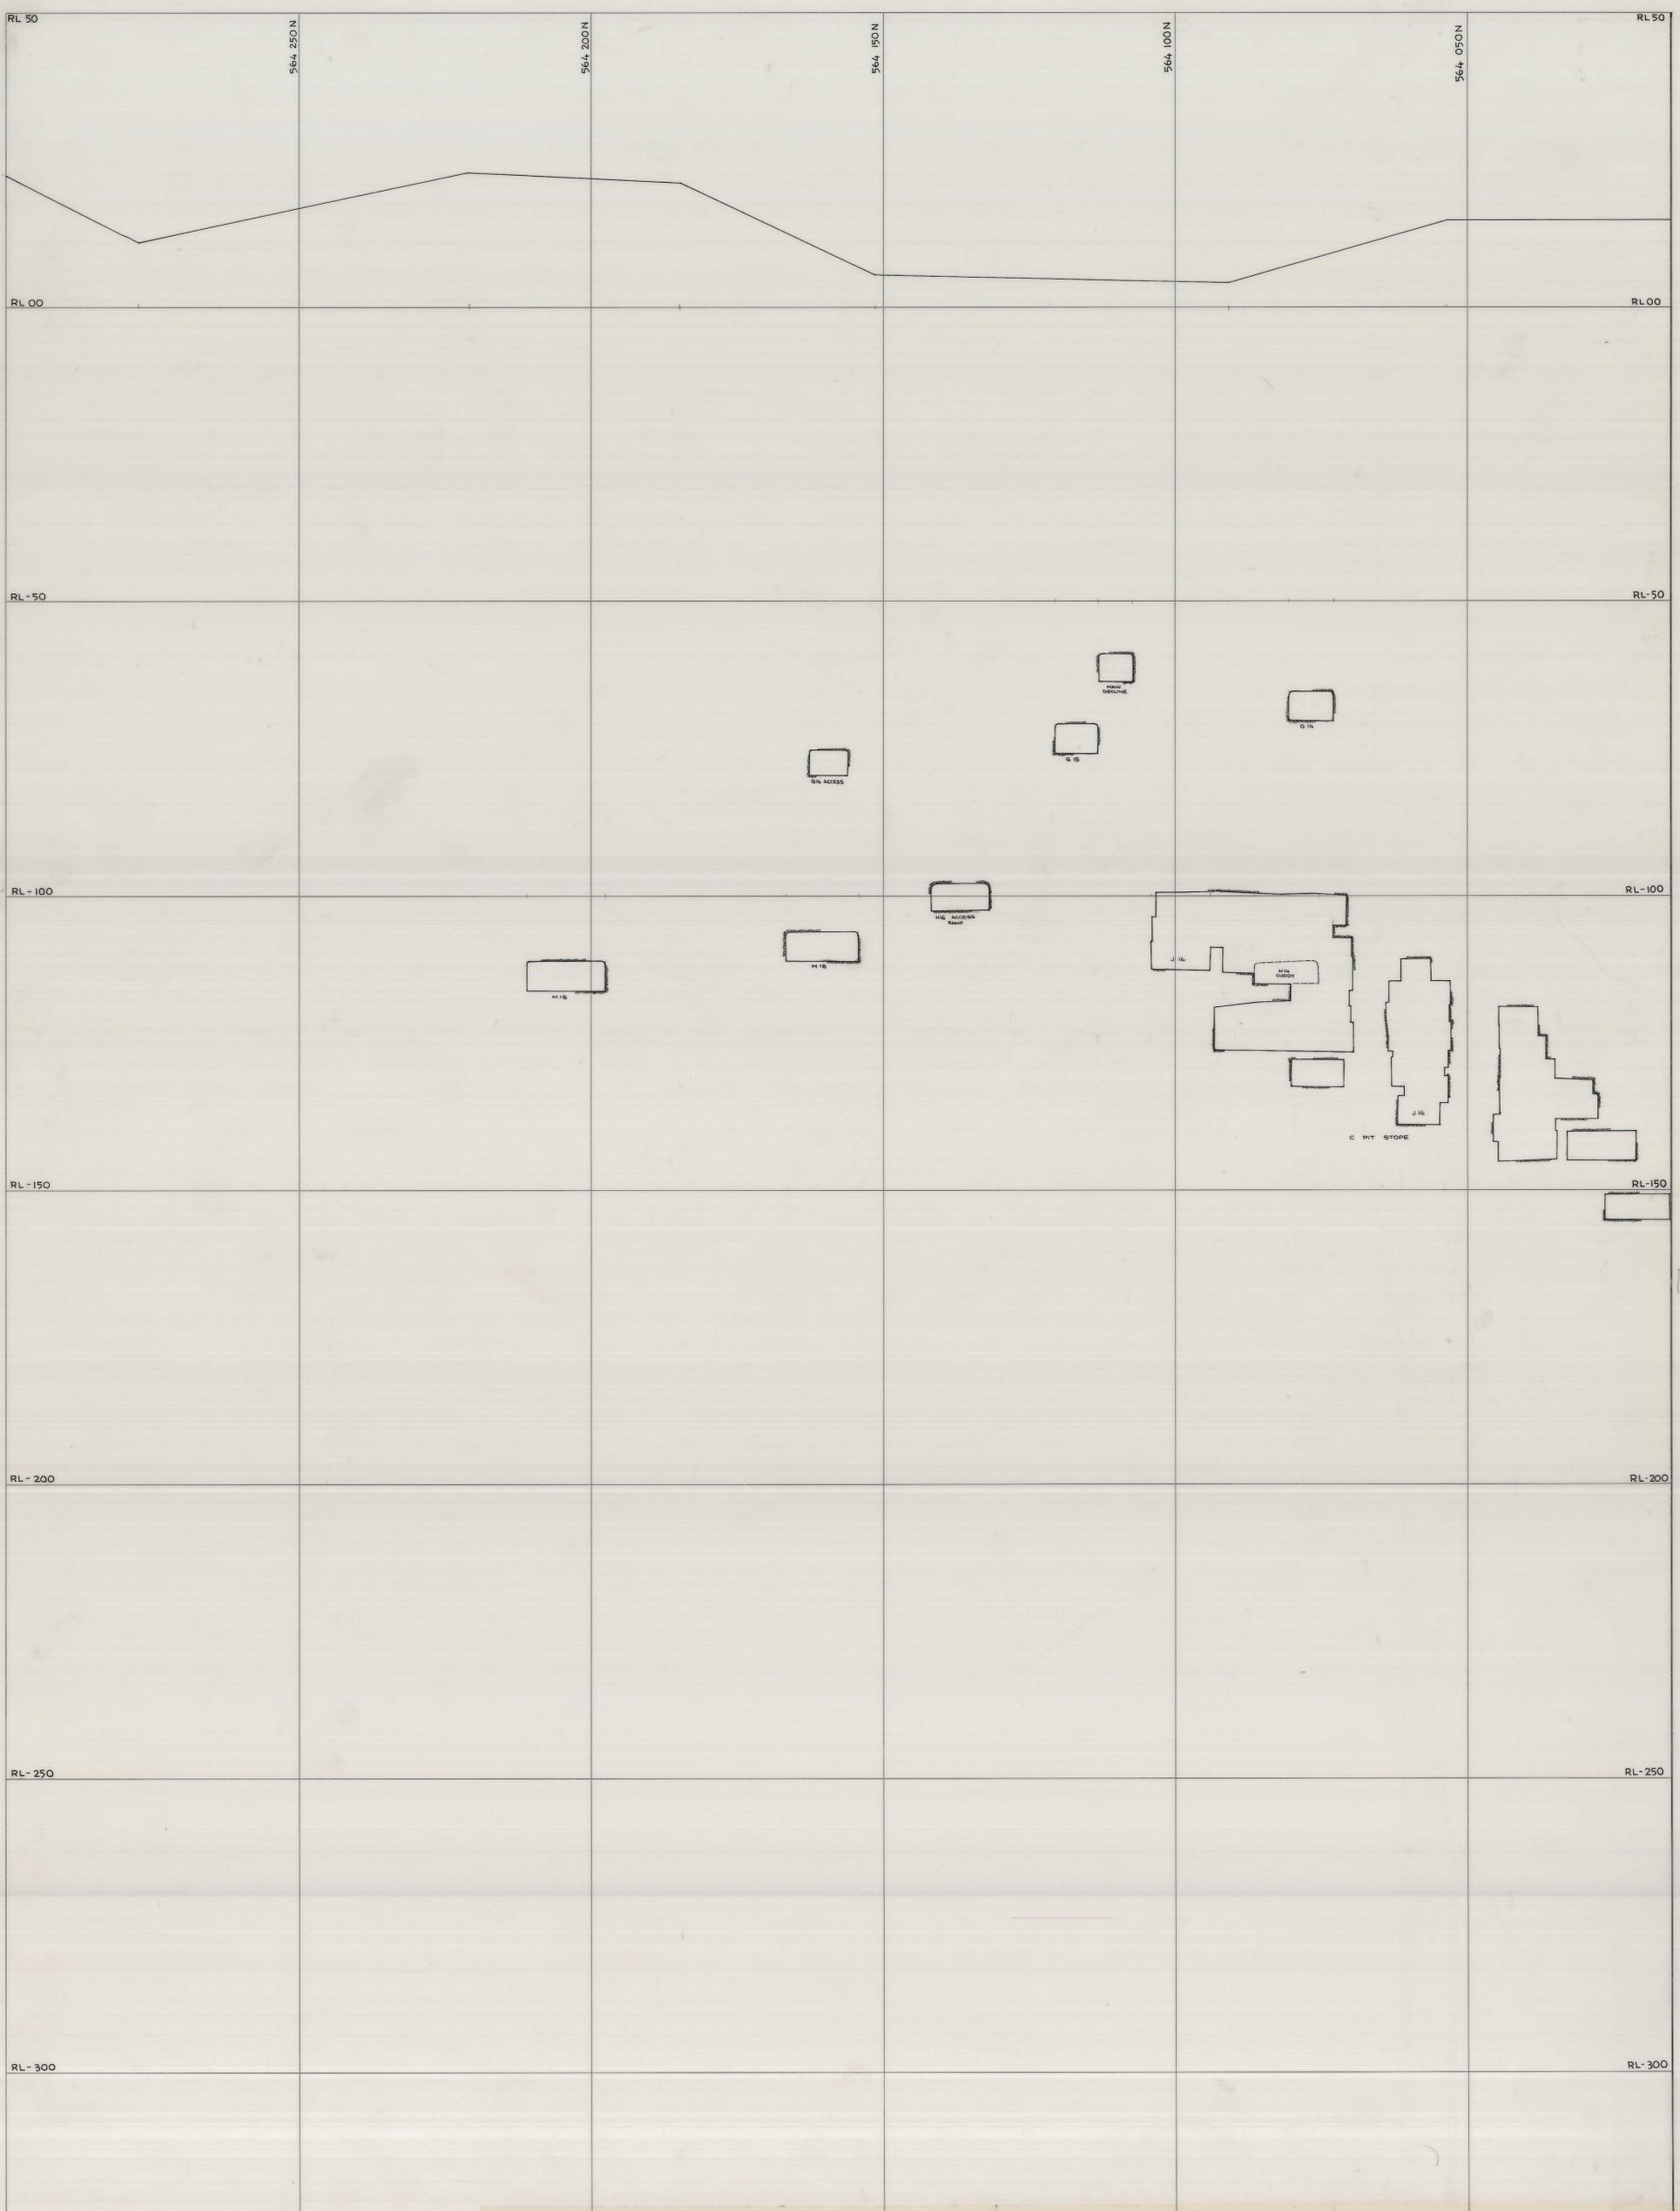

0374_2325

04DM22-1016

SCALE 1:500	LOCATION DOLPHIN MINE	
looking east	SUBJECT CROSSECTION 220 020 E	
north	PLAN NUMBER 04DM22 - 1016	GRASSY KING ISLAND

4-73-5077