


5 cm

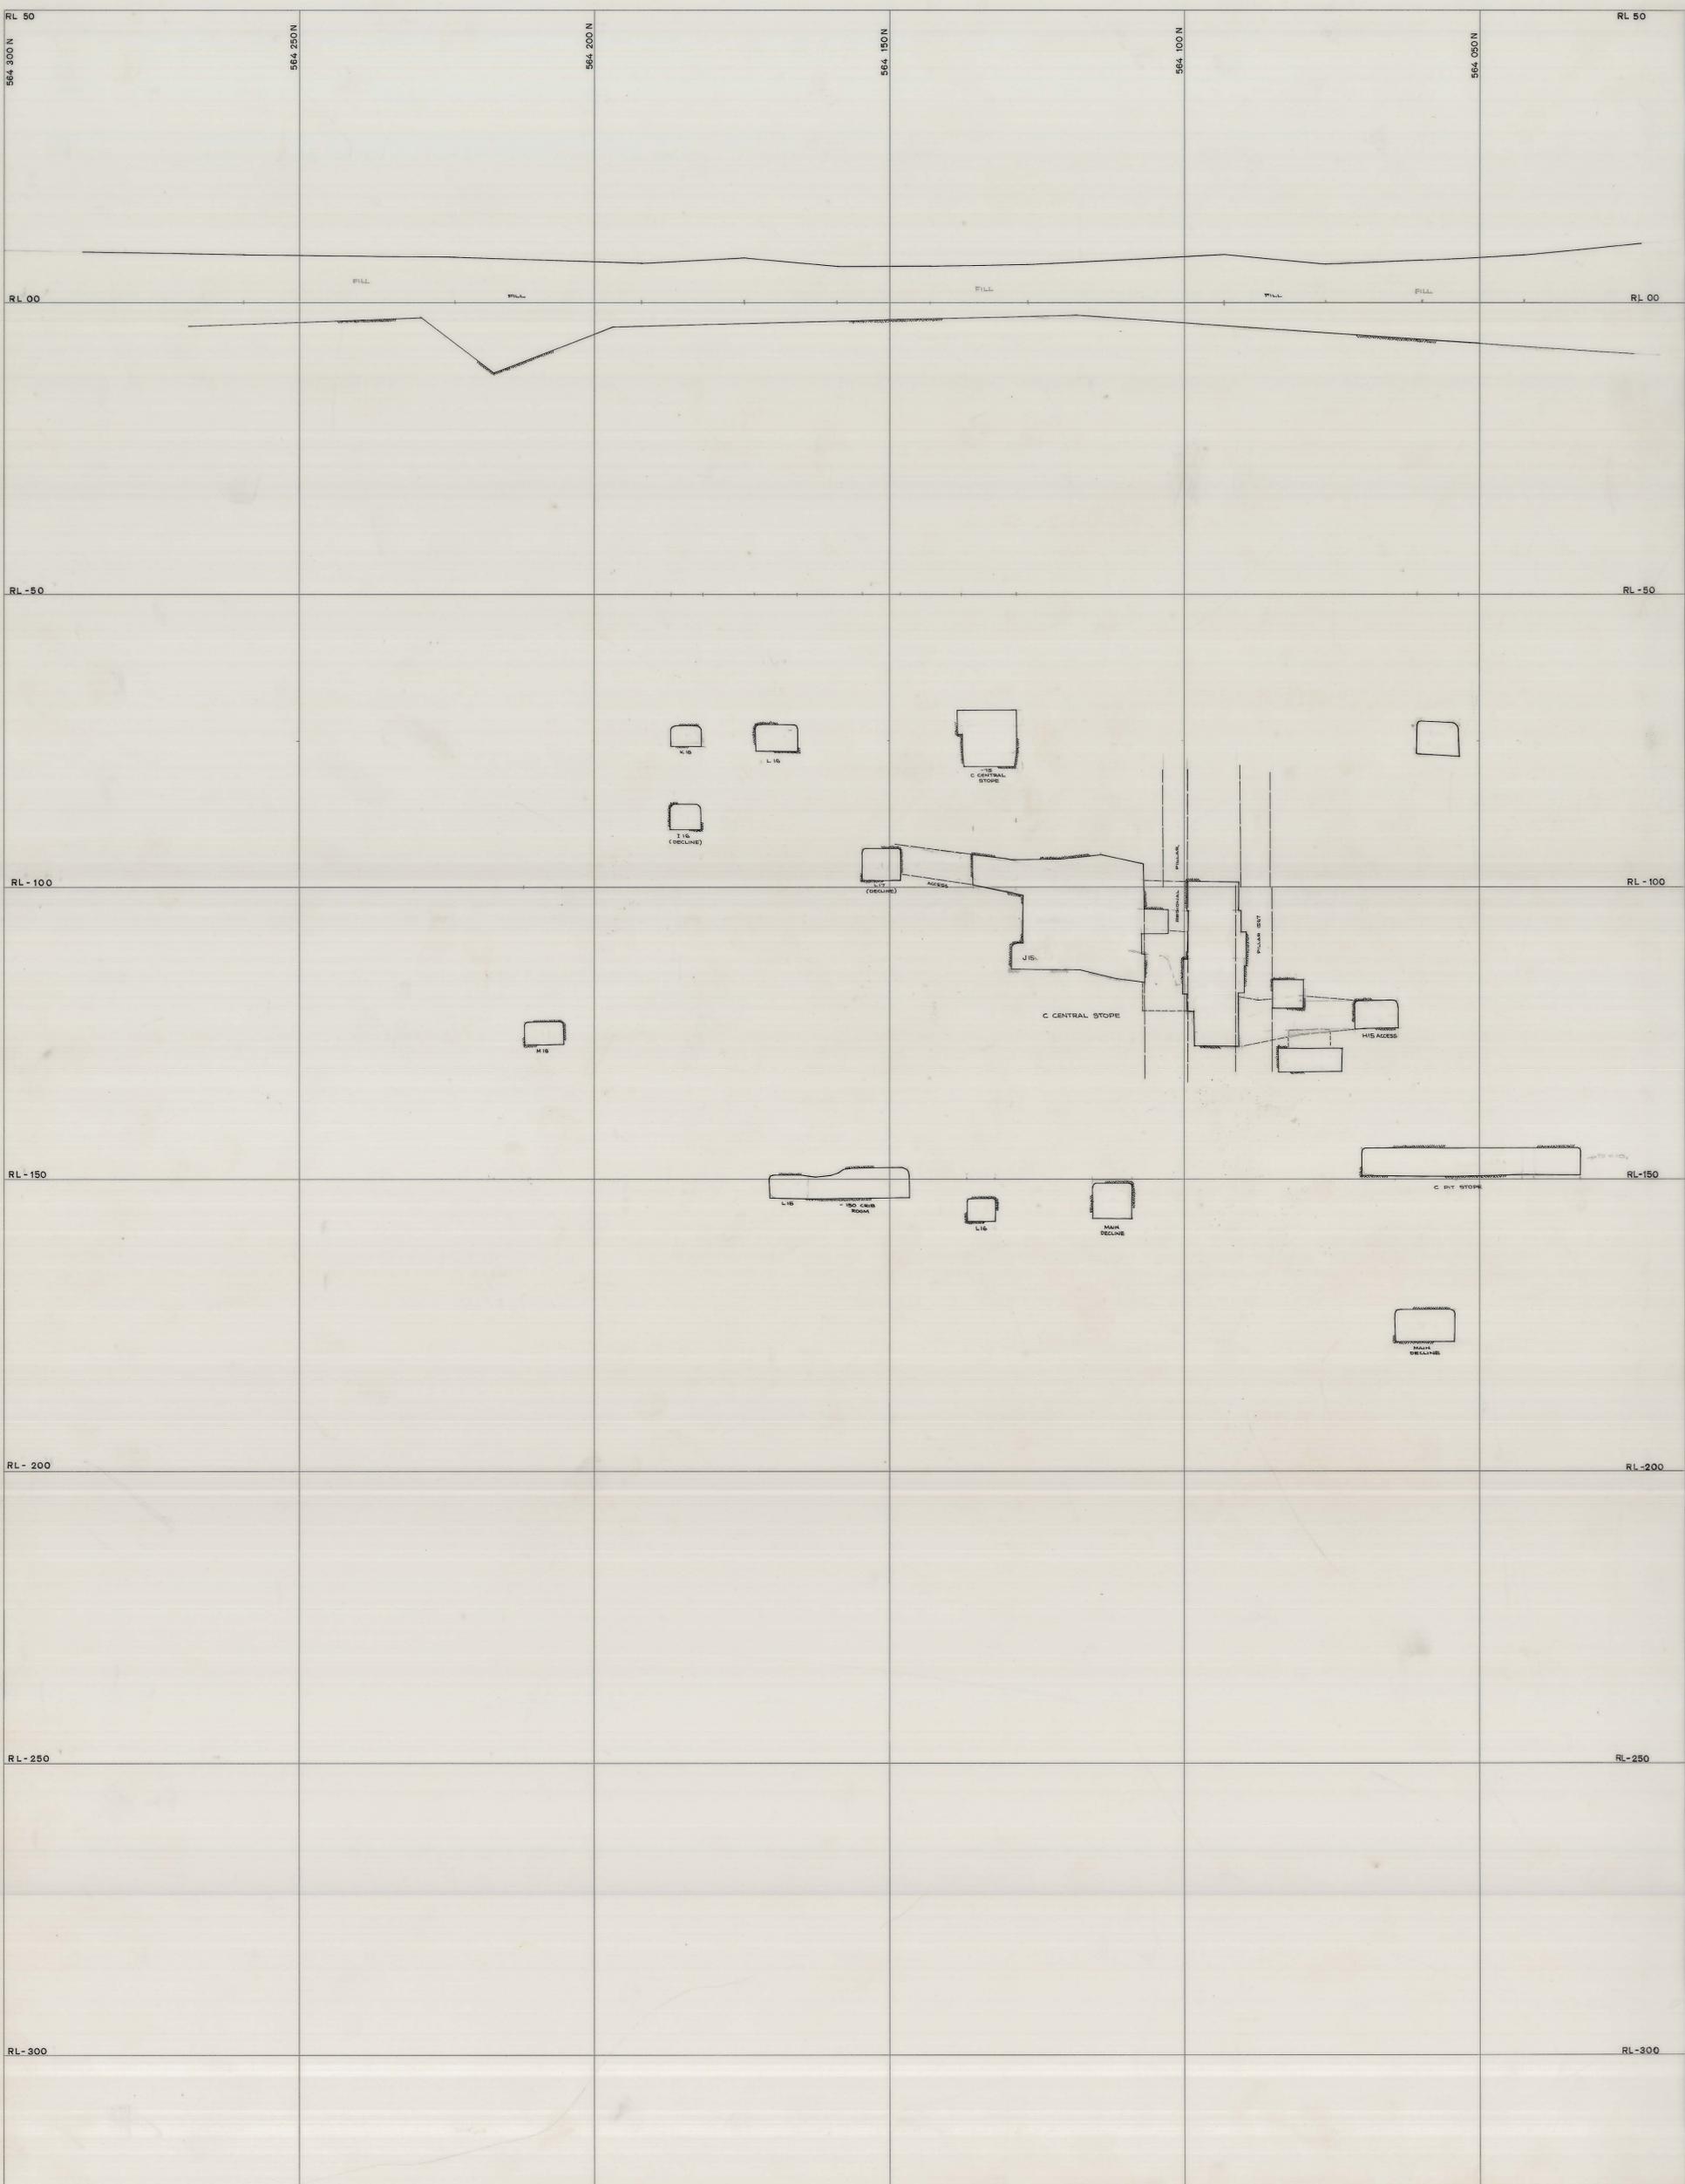

0374_2329

04DM22-1020

SCALE 1:500	LOCATION DOLPHIN MINE	
looking east north	SUBJECT CROSSECTION 220 100 E	
		GRASSY KING ISLAND PLAN NUMBER 04DM22 - 1020