


27 JUN 1981

5m

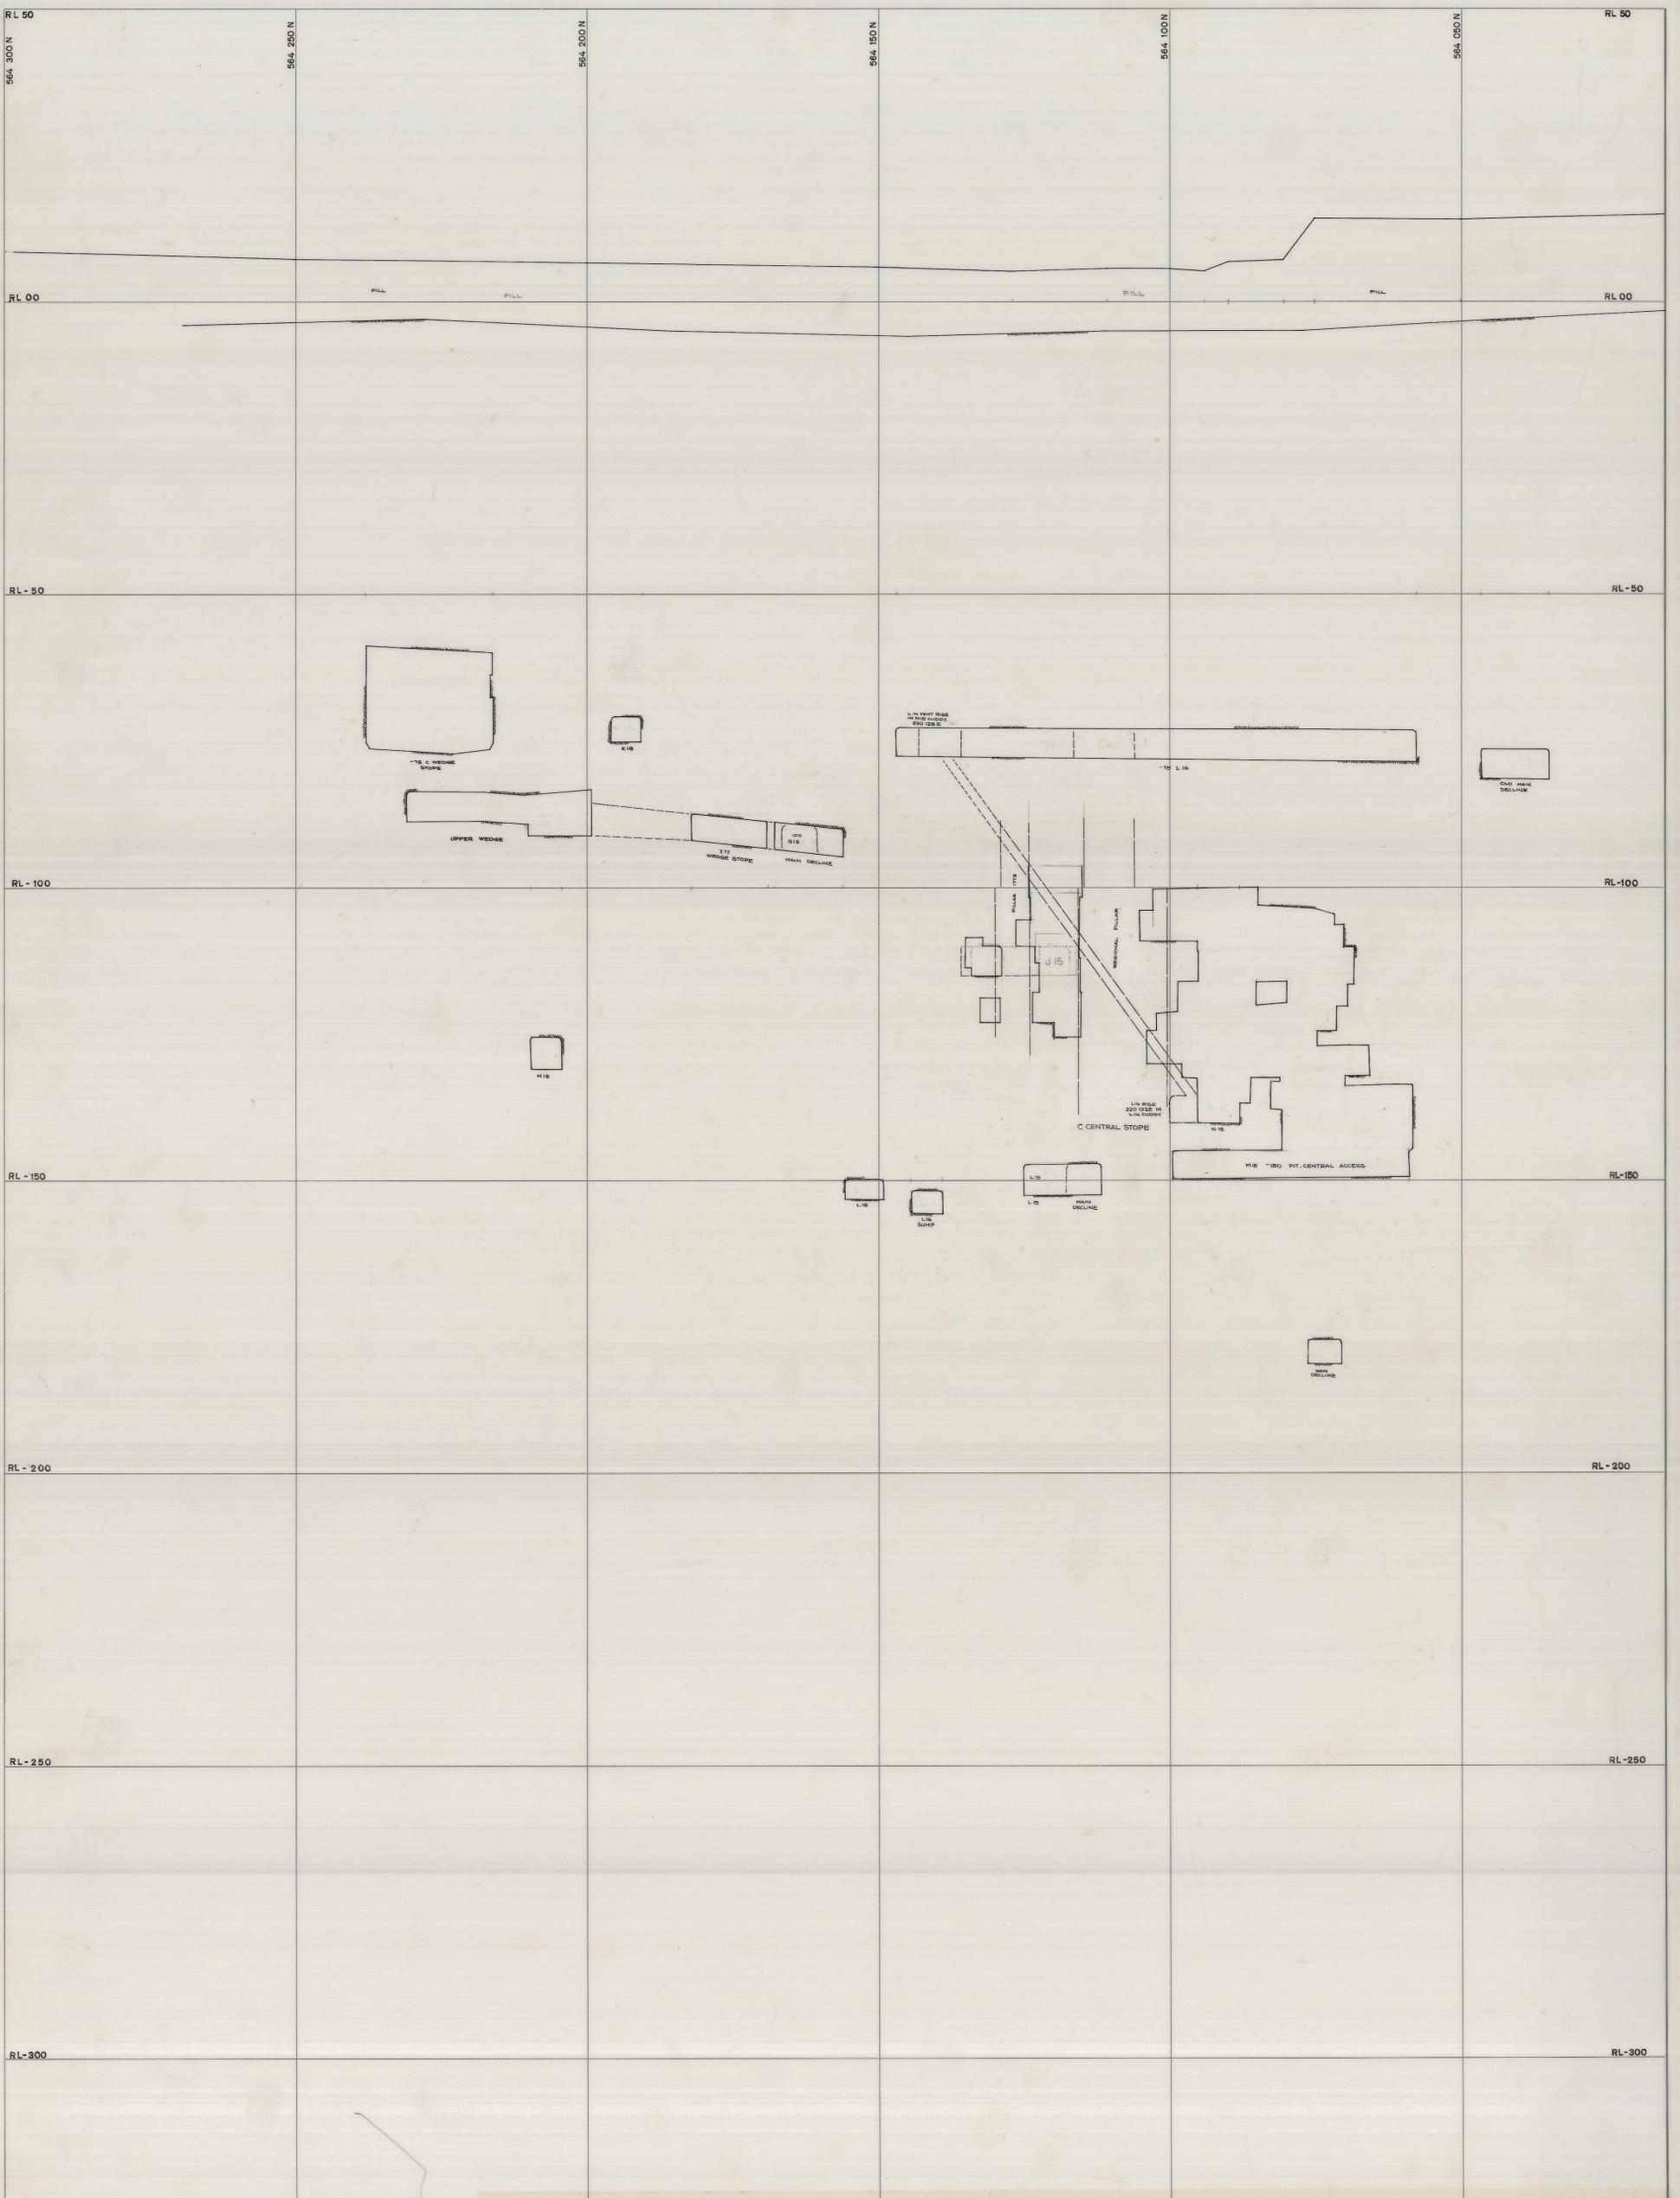

SCALE 1:500

looking east

LOCATION DOLPHIN MINE

SUBJECT

CROSSSECTION 220 120 E

KIS KING ISLAND SCHEELITE
A DIVISION OF WAGMAN INTERNATIONAL

GRASSY KING ISLAND

PLAN NUMBER

04DM22 - 1021

0374_2330

04DM22-1021

M-23-3-77