


220/190
F-108-5



0374_2334

06 DM 11-175 106

DM
Lens Wedge
-110
1:100

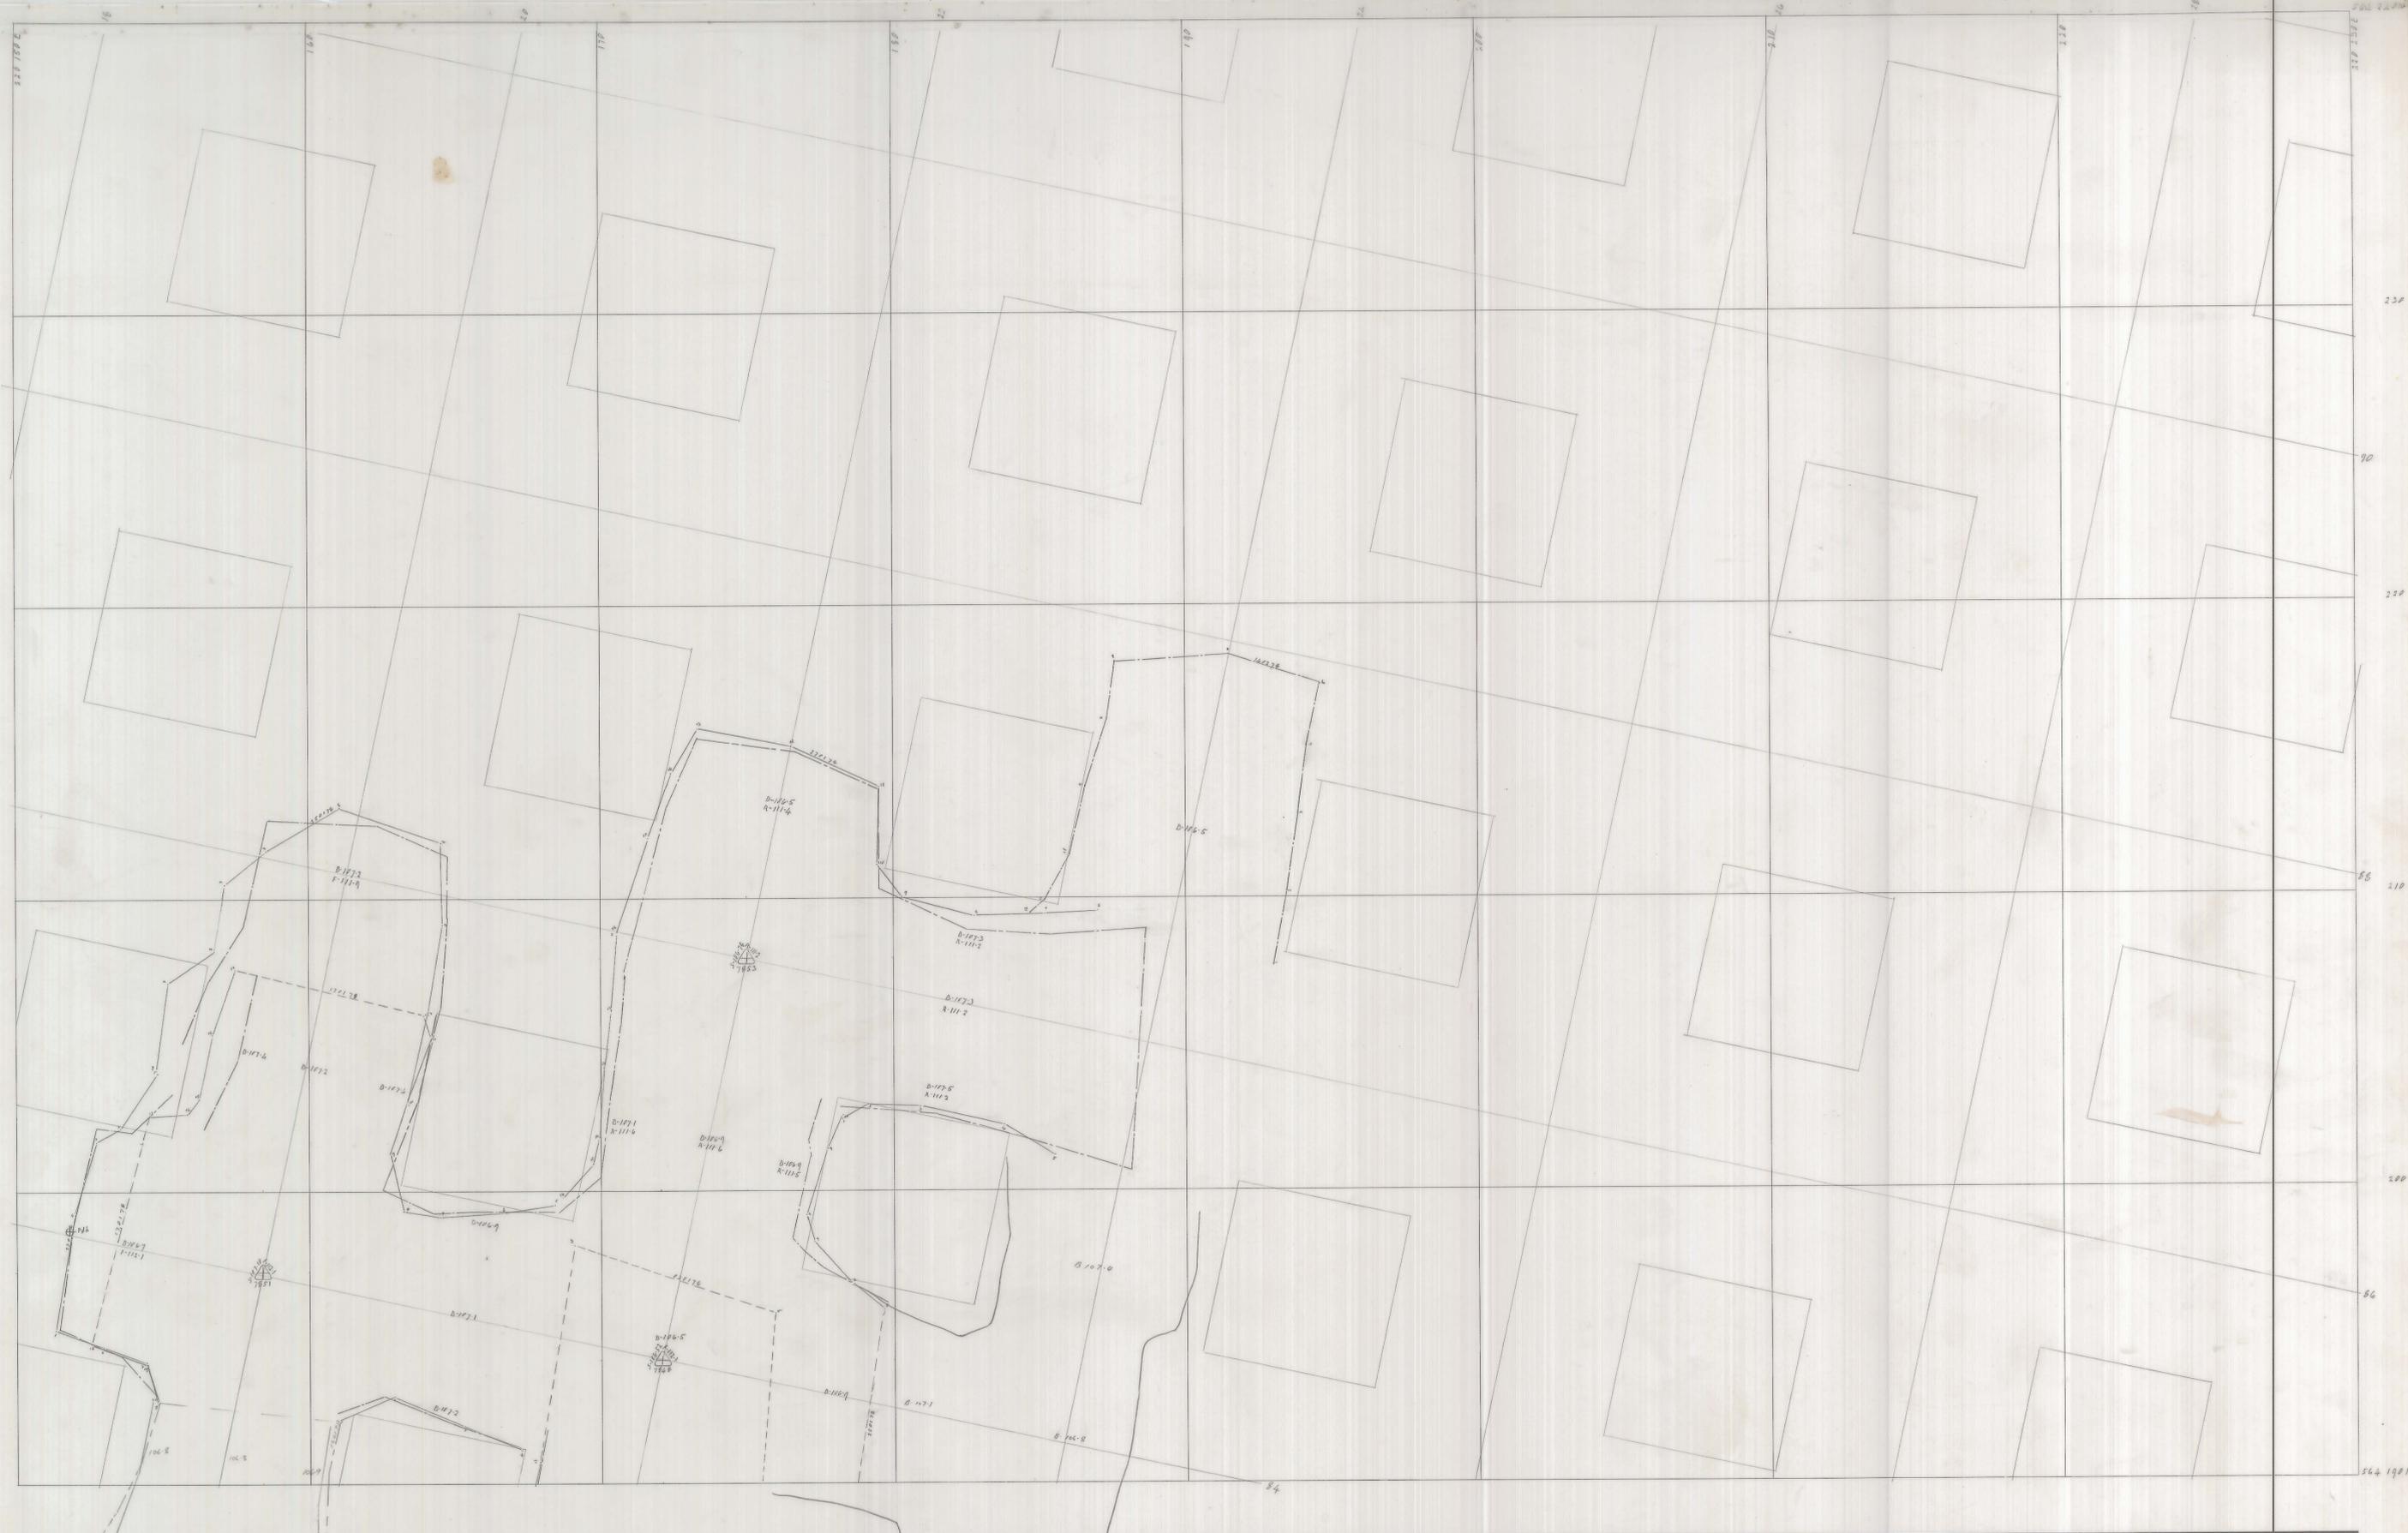

	SCALE 1	LOCATION SUBJECT	 <p>KING ISLAND SCHEELITE A DIVISION OF WARMAN INTERNATIONAL</p> <p>GRASSY KING ISLAND</p> <p>PLAN NUMBER</p>
north			