


0374_2372

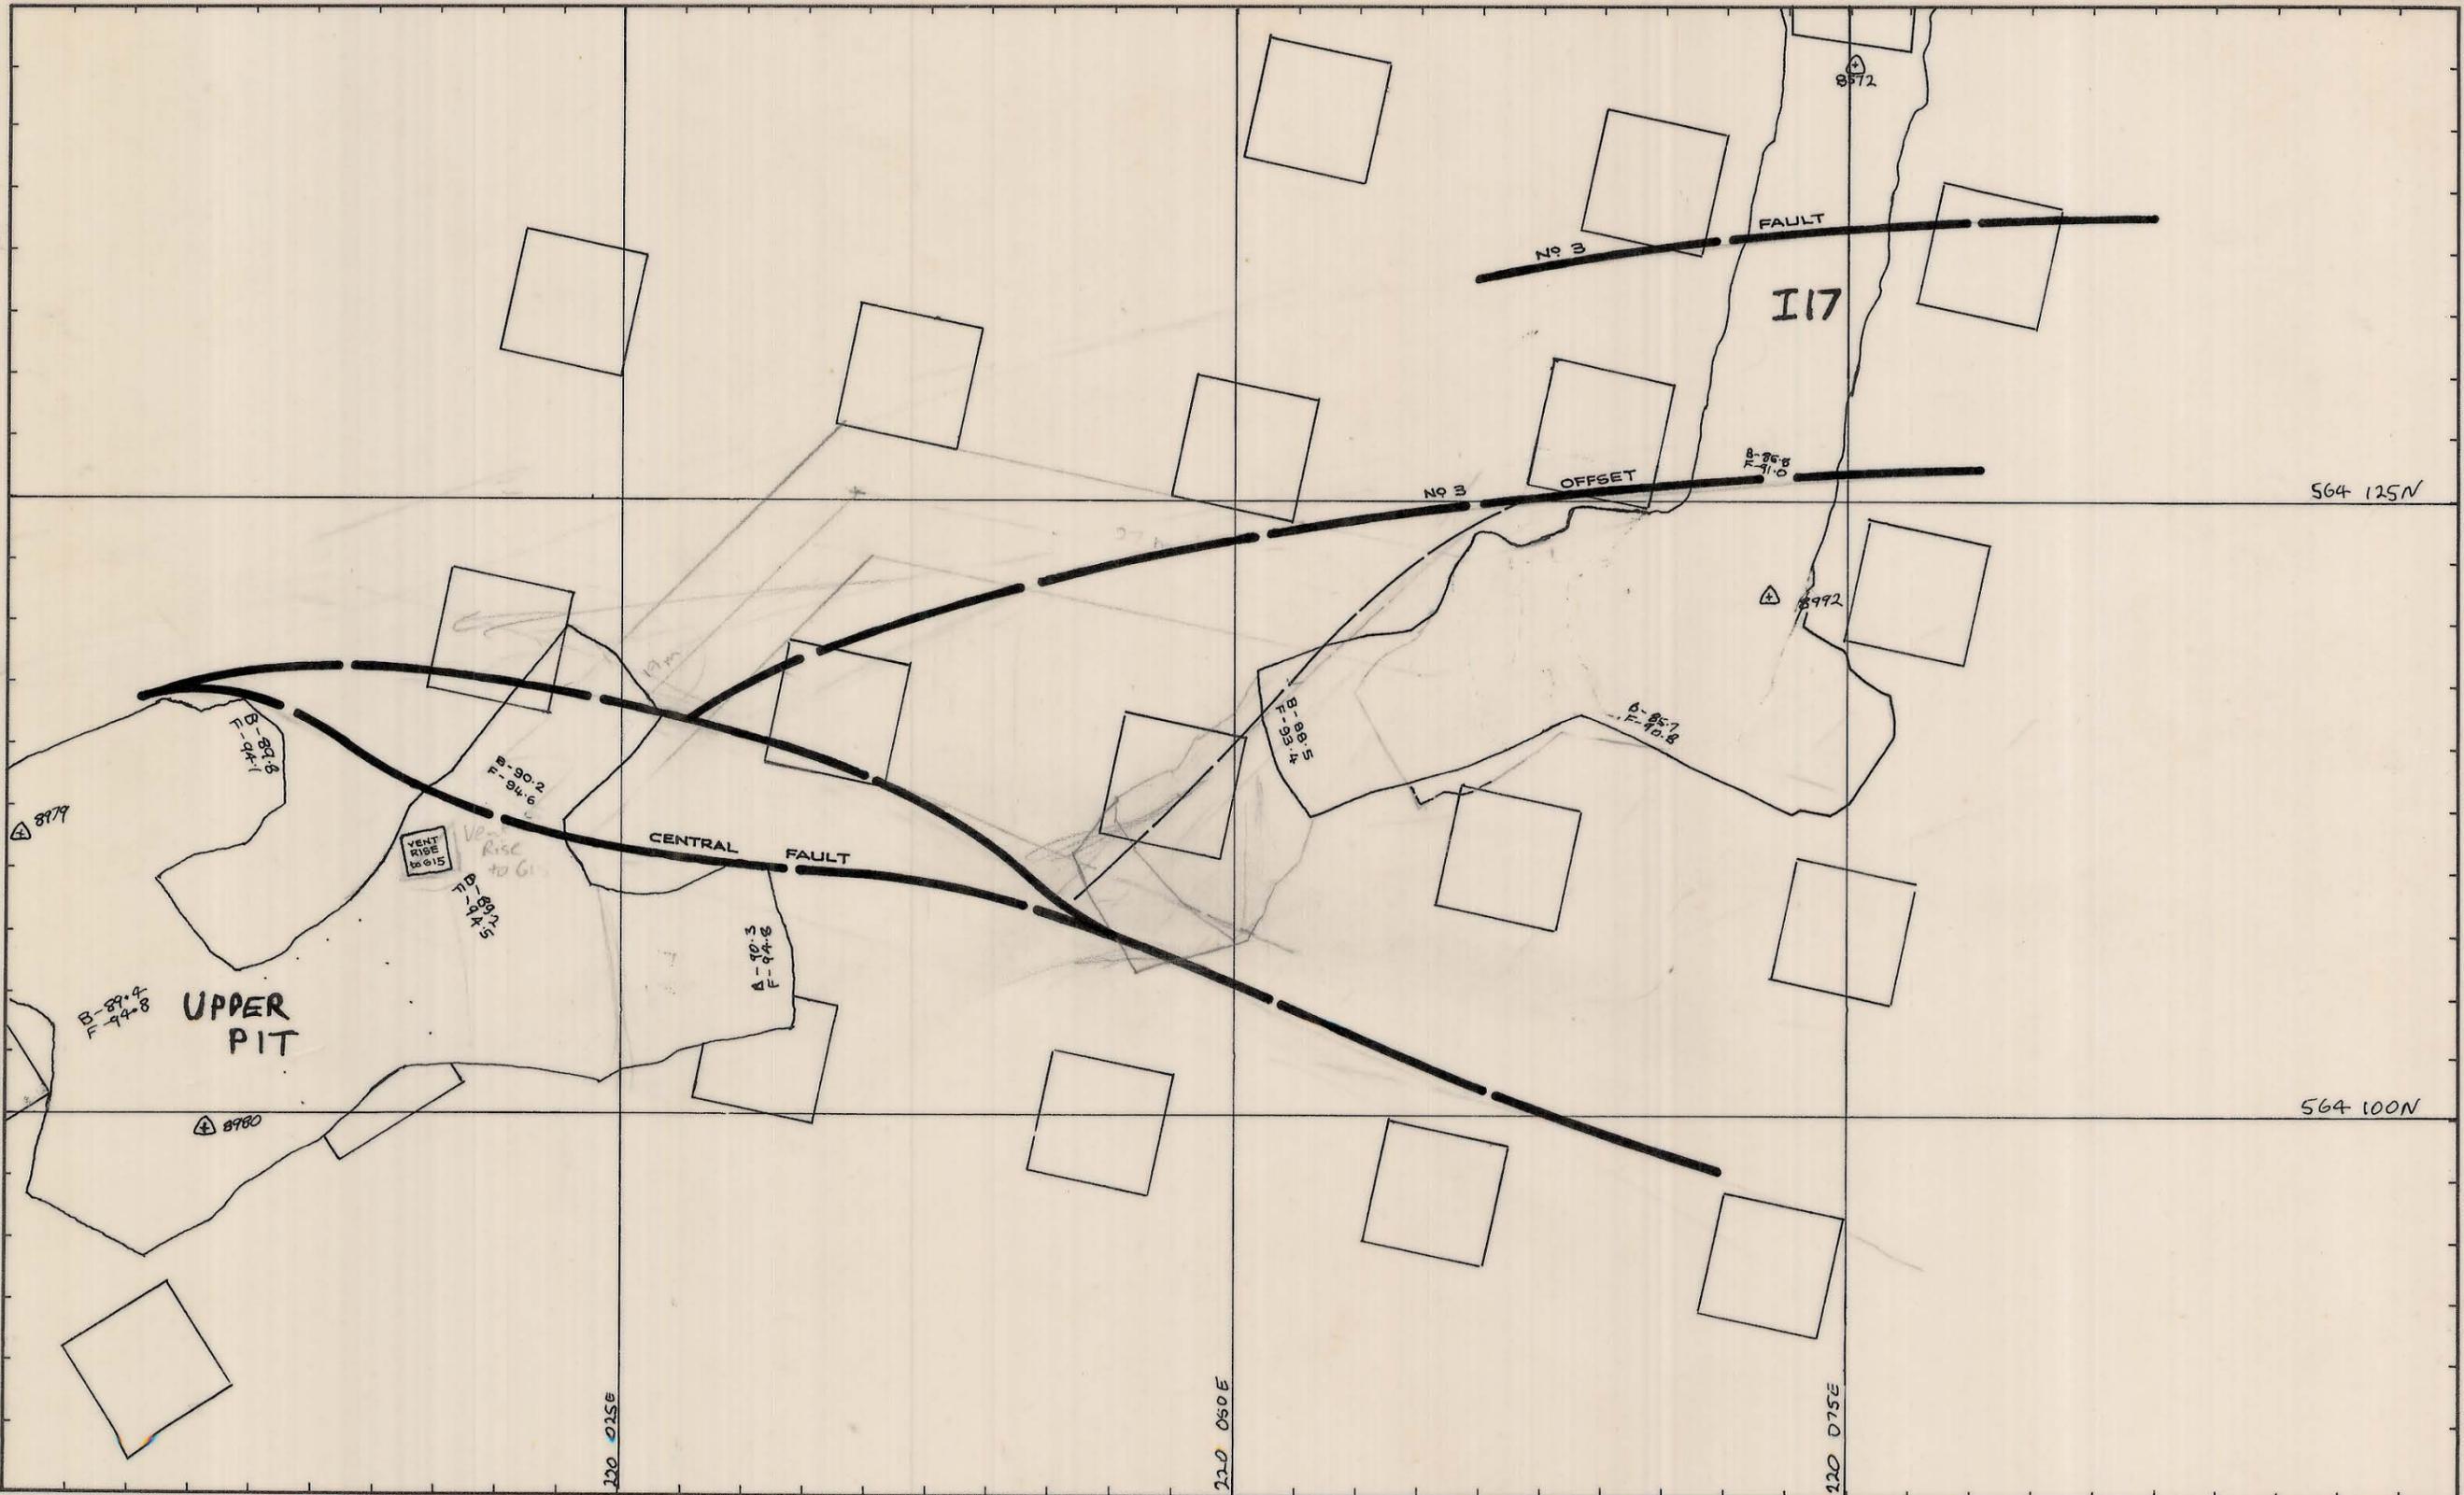

REF. PLAN	GEOLOGY		SCALE 1:250	
	SURVEY			
	PLANNING	Matt D. 08/11/83		
	ROCK MEC.			
	GRADE CON.			
	DRAFTING			
T.S.S.			UPPER PIT-CENTRAL LINK UP DRAWING NUMBER	