


0374_2374

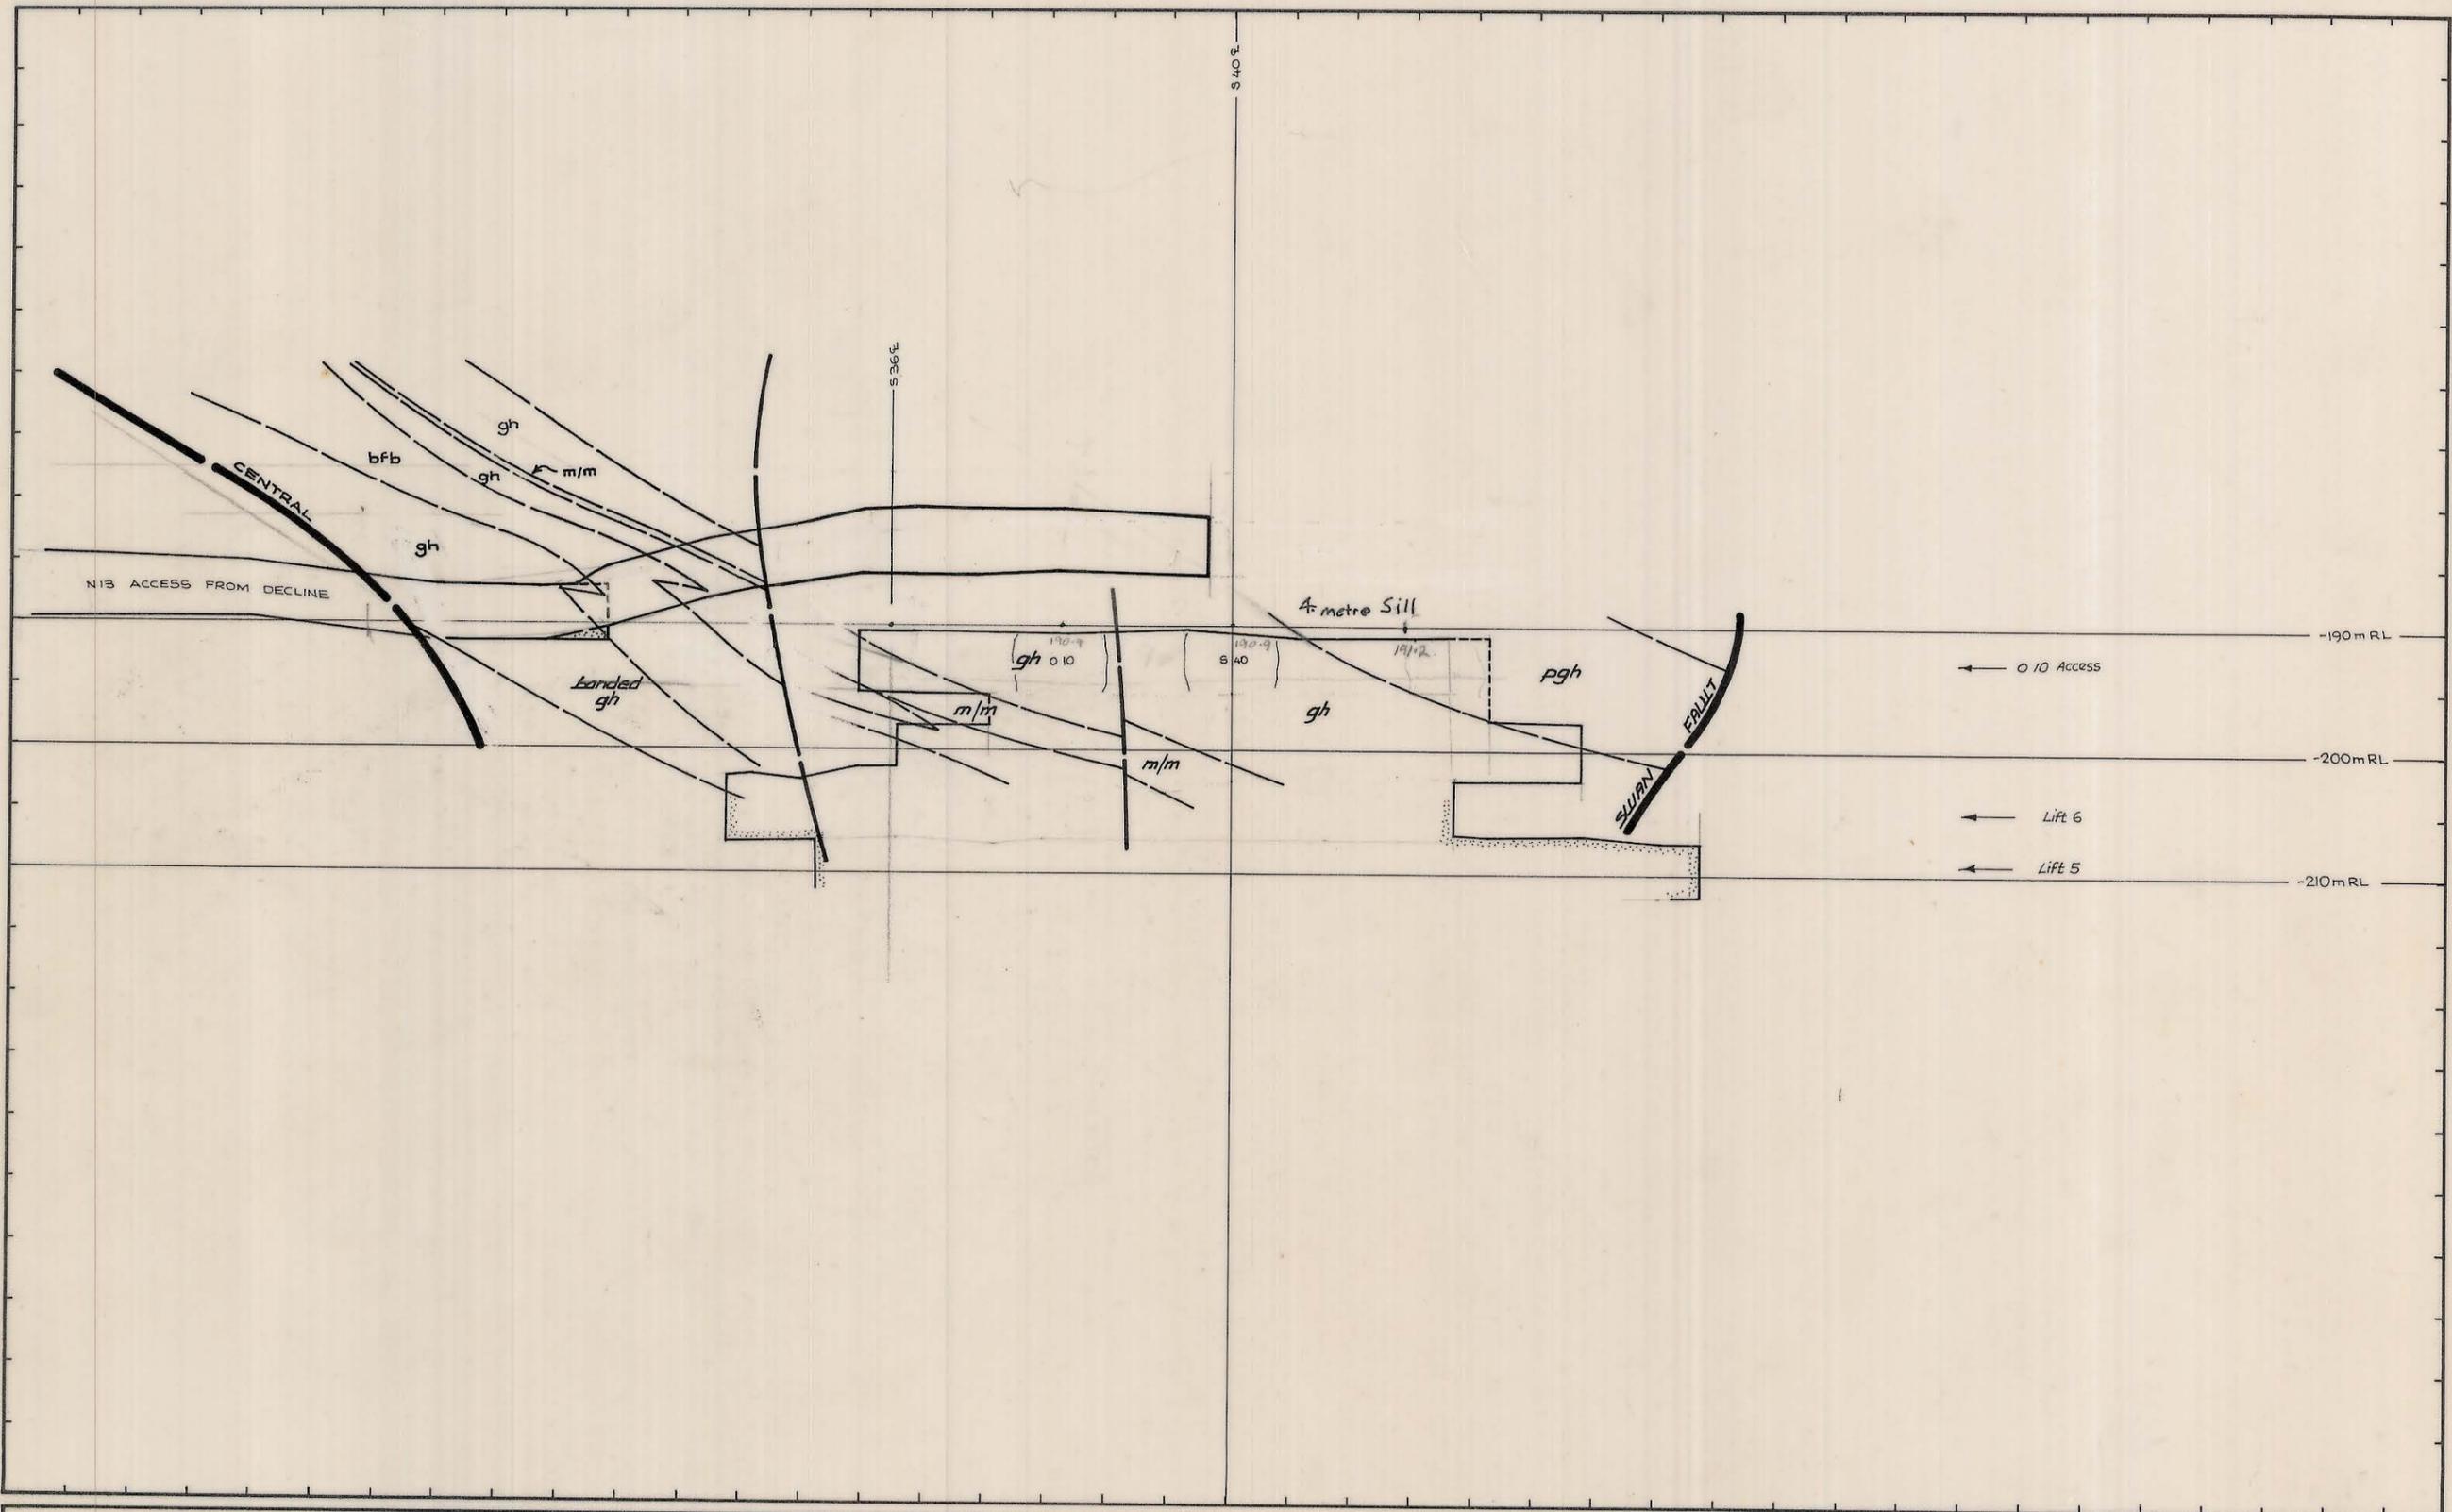

REF. PLAN	GEOLOGY	SGB	JUNE '85	SCALE 1:500	
	SURVEY				
	PLANNING			LOWER PIT STOPE S64 STOPE SECTION	
	ROCK MEC.				
	GRADE CON.				
DRAFTING	Bing Gaus	25 AUG. 1982	DRAWING NUMBER		
T.S.S.					