


0374-238

1010

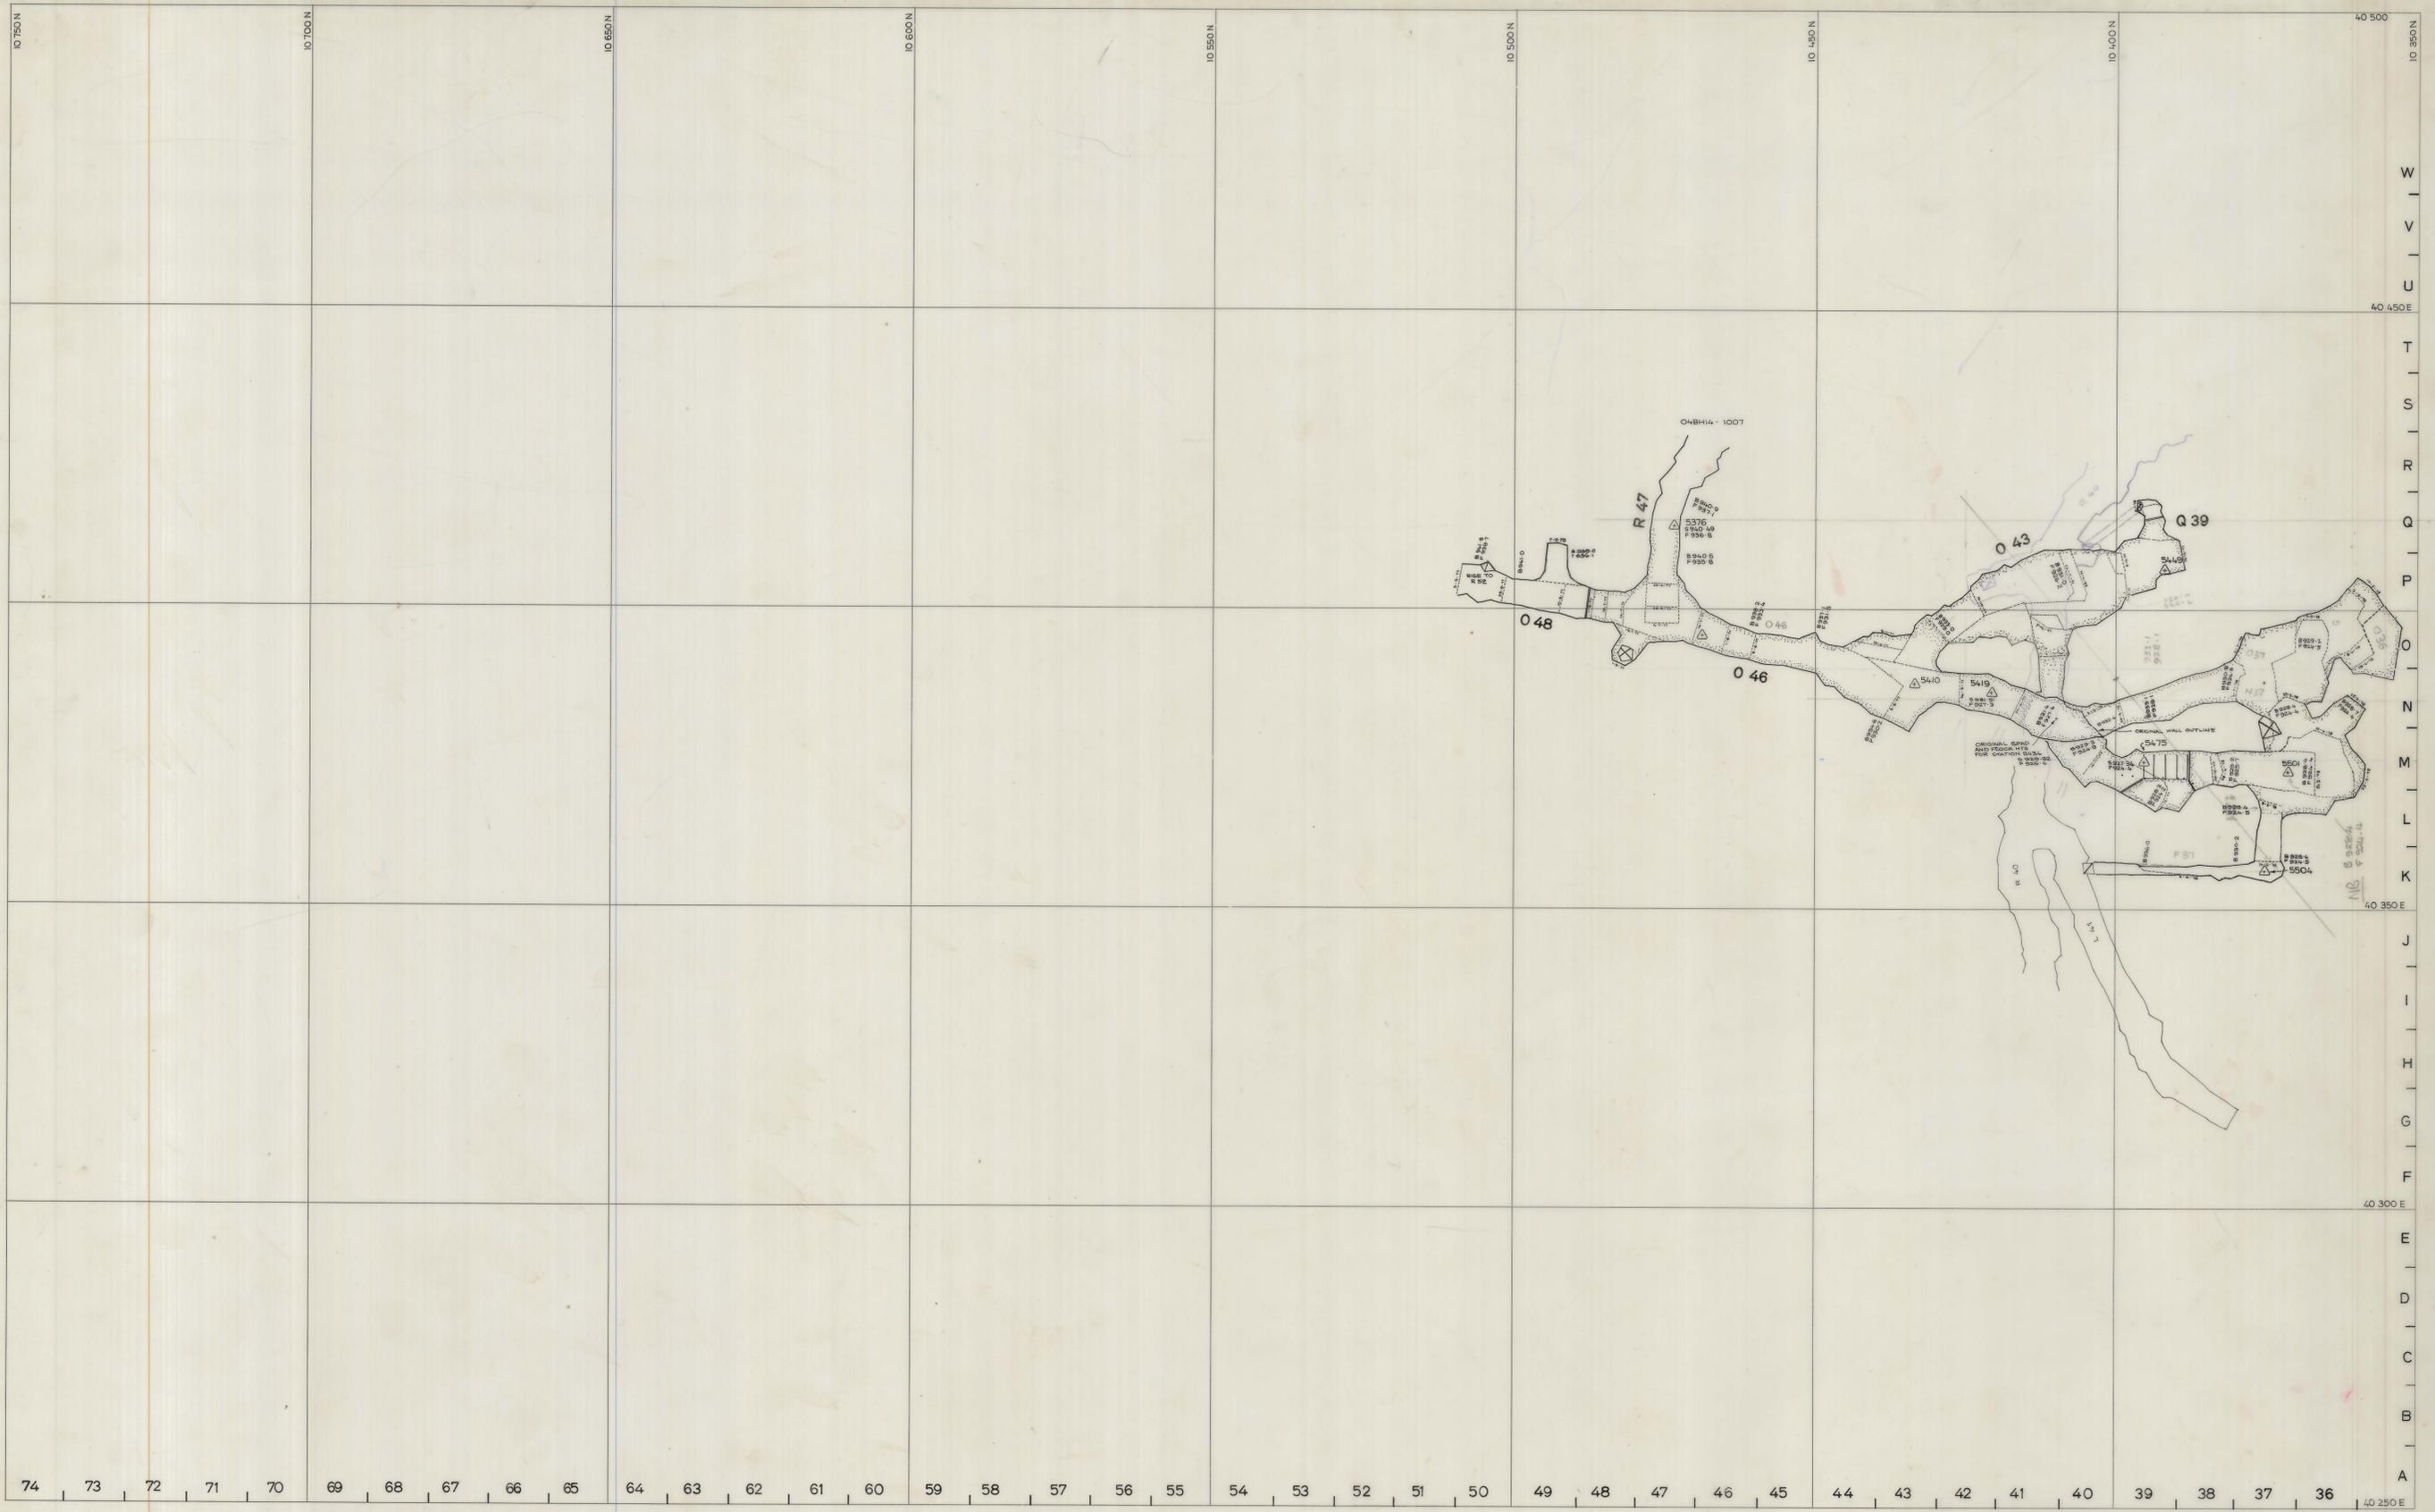

SCALE 1 : 500		LOCATION BOLD HEAD MINE	 <small>A DIVISION OF WARMAN INTERNATIONAL</small> GRASSY KING ISLAND PLAN NUMBER 04BH14 - 1010
		SUBJECT STOPE DEVELOPMENT	
north		B. F. 2.	

B +