

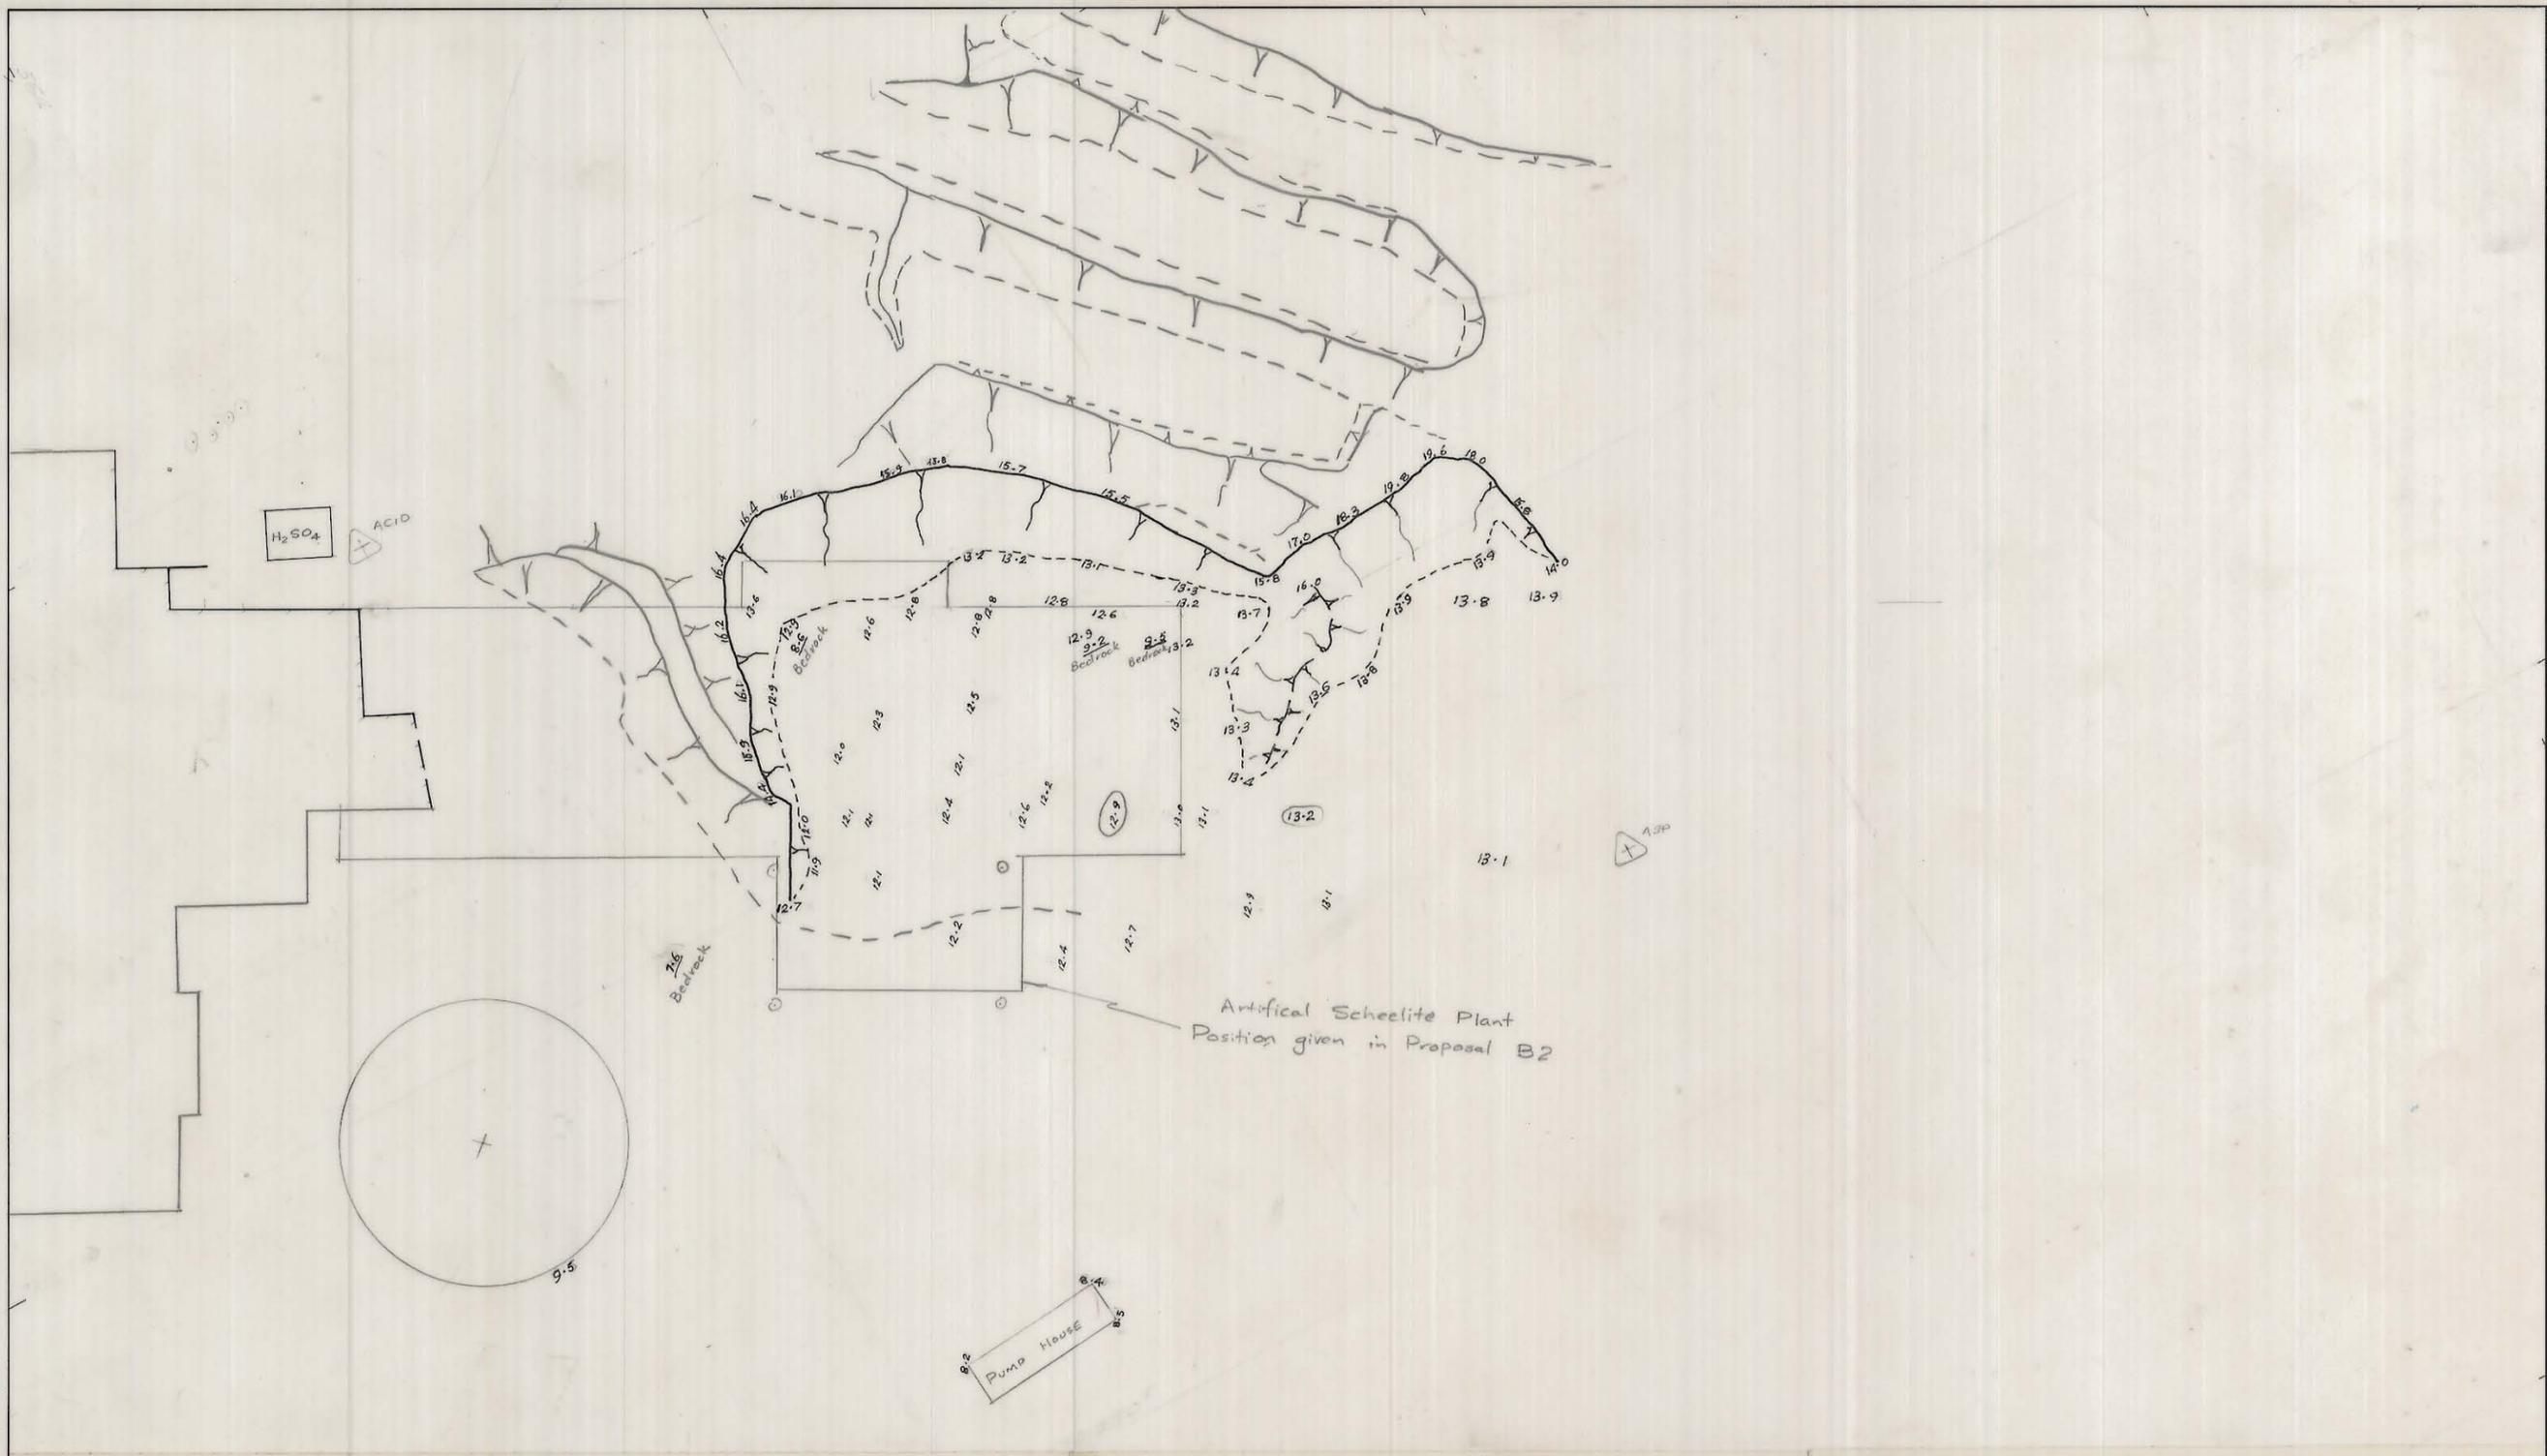


02WA03-3001

0374\_2382

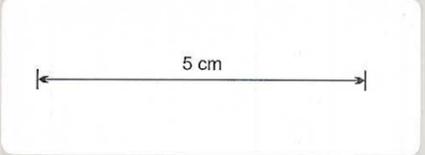

SCALE 1:500

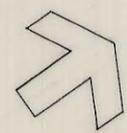

north

LOCATION  
MILL COMPLEX

SUBJECT  
**ARTIFICIAL SCHEELITE PLANT**

Preliminary Earthworks as at 4 - 8 - 76

**KIS** KING ISLAND SCHEELITE  
A DIVISION OF WARMAN INTERNATIONAL

GRASSY KING ISLAND

PLAN NUMBER  
02 WA 03 - 3001