


0374_2383

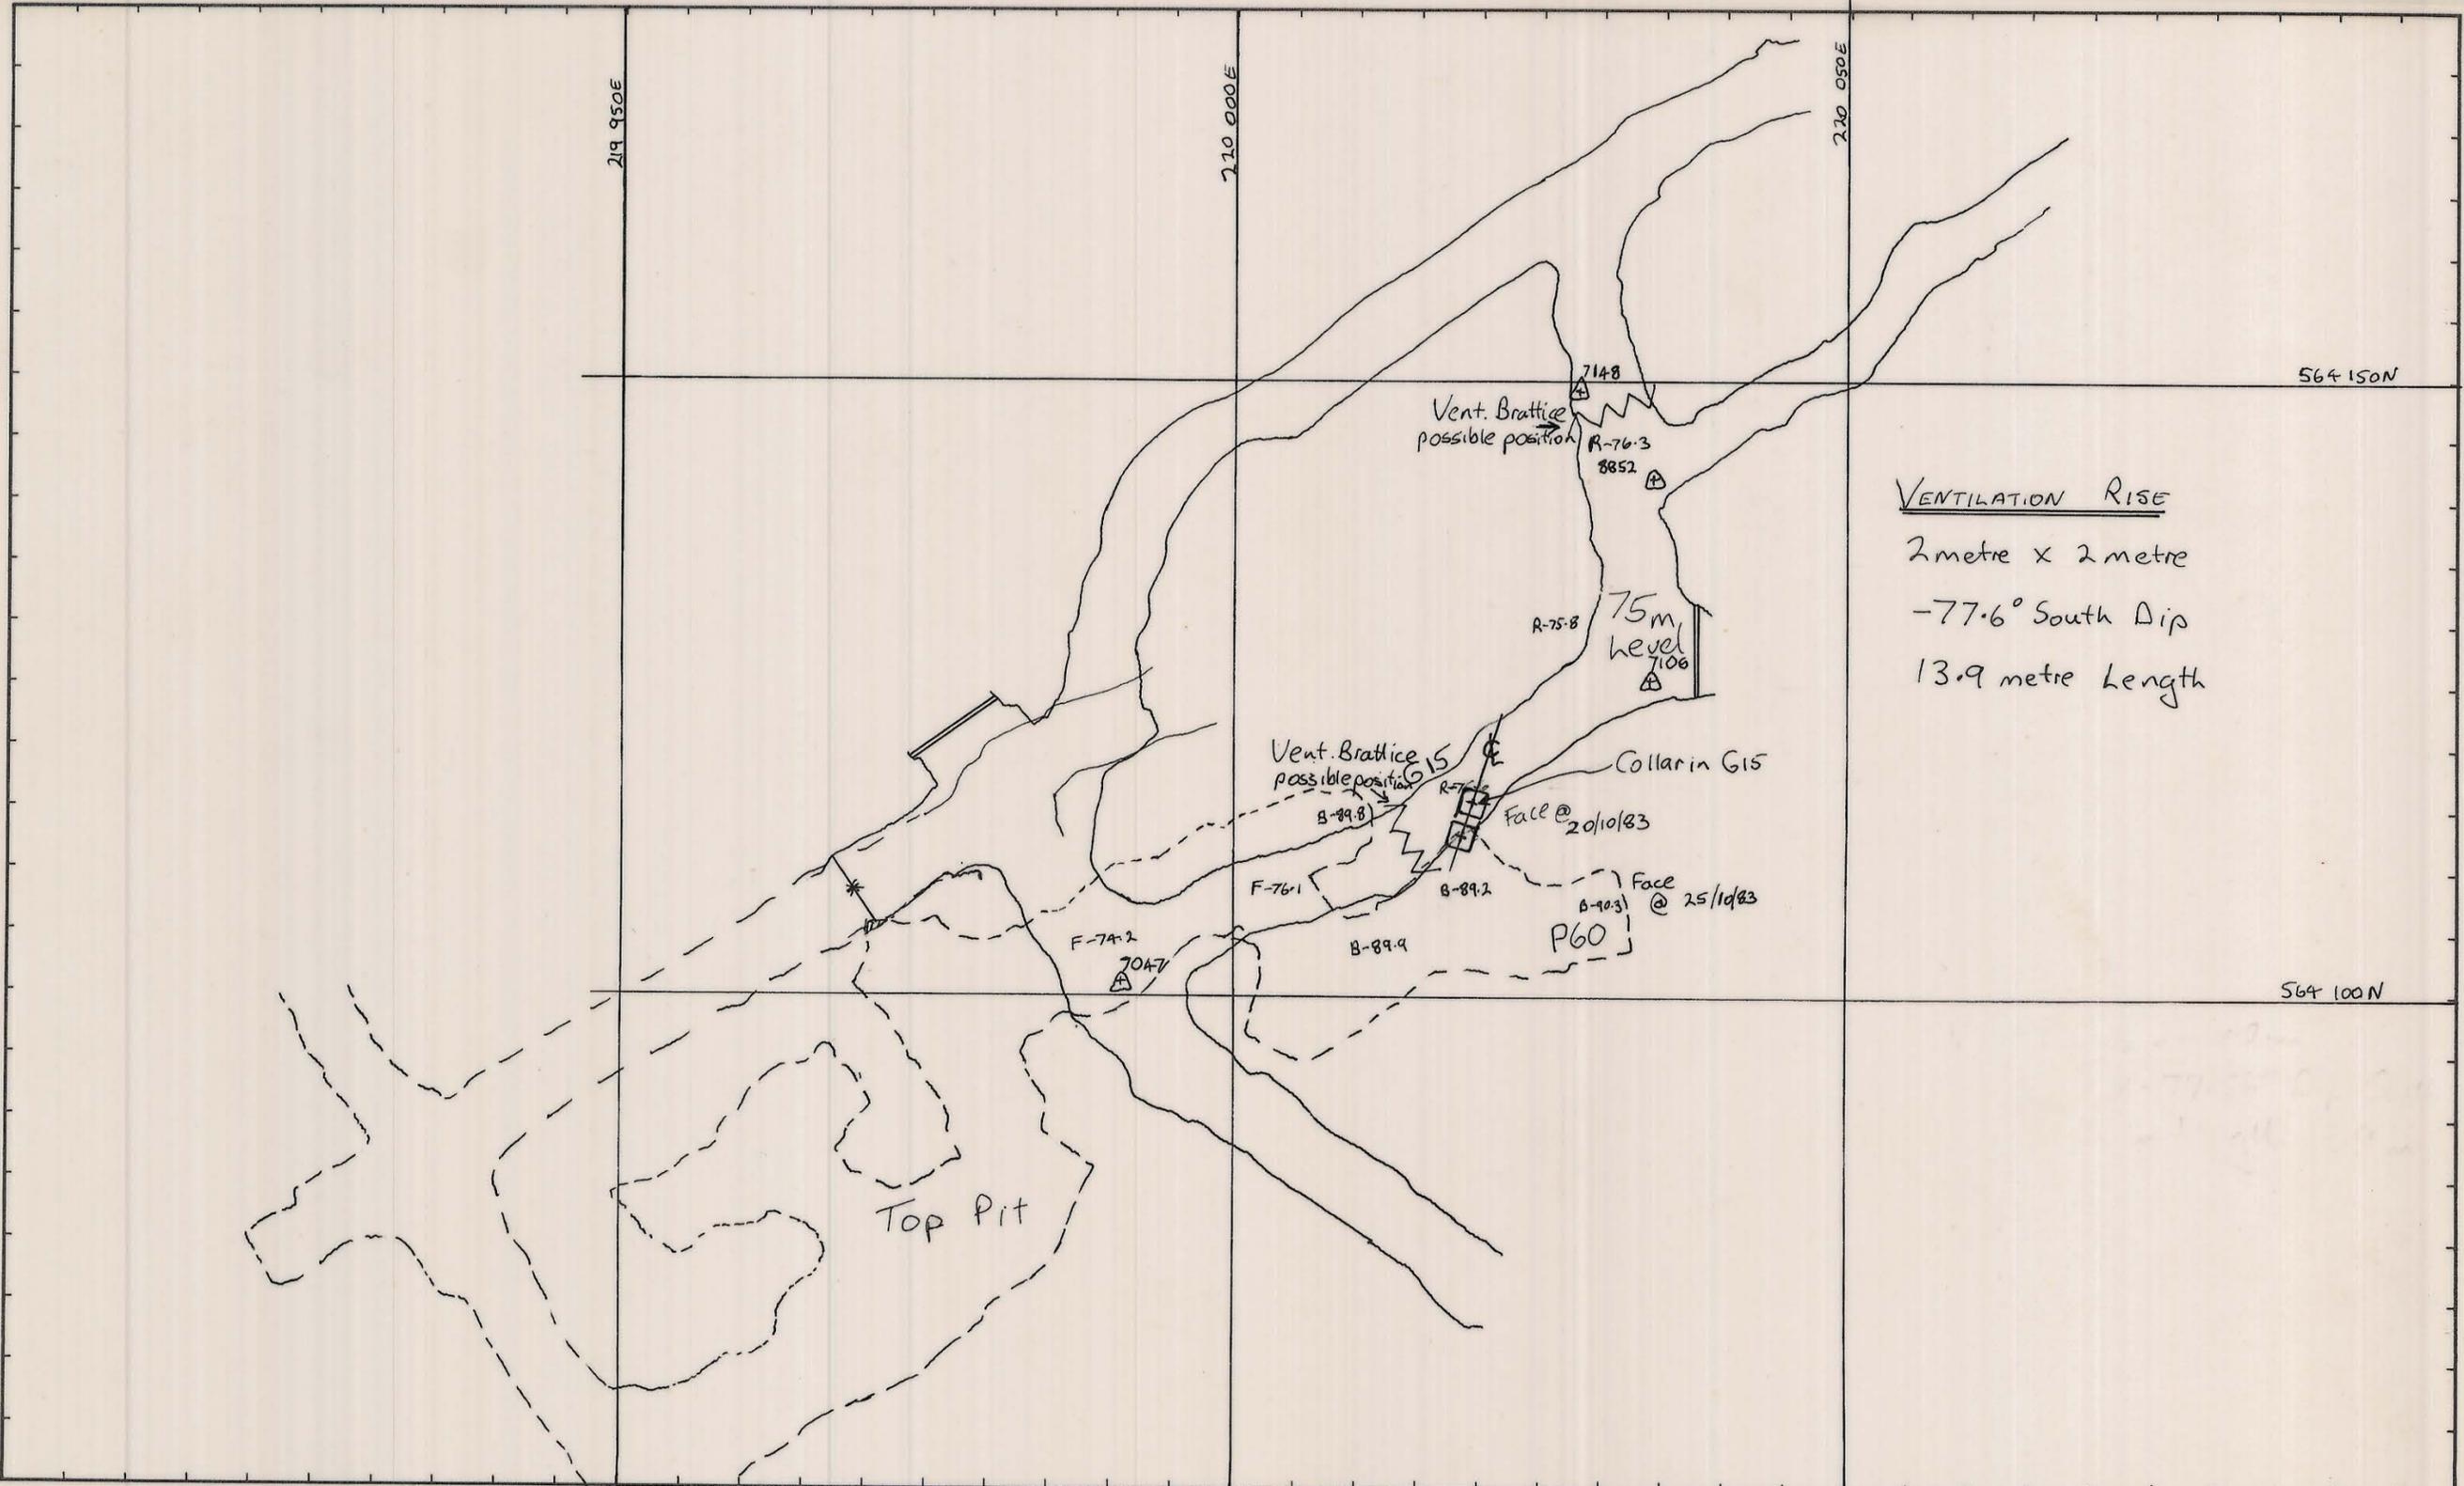

VENTILATION RISE
 2 metre x 2 metre
 -77.6° South Dip
 13.9 metre Length

REF PLAN	GEOLOGY	SCALE 1:500	
	SURVEY		
	PLANNING	Matth. 25/10/83	VENTILATION RISE Connection 75m RL to Top Pit DOLPHIN MINE <small>DRAWING NUMBER</small>
	ROCK MEC.		
	GRADE CON.		
	DRAFTING		
	T.S.S.		