
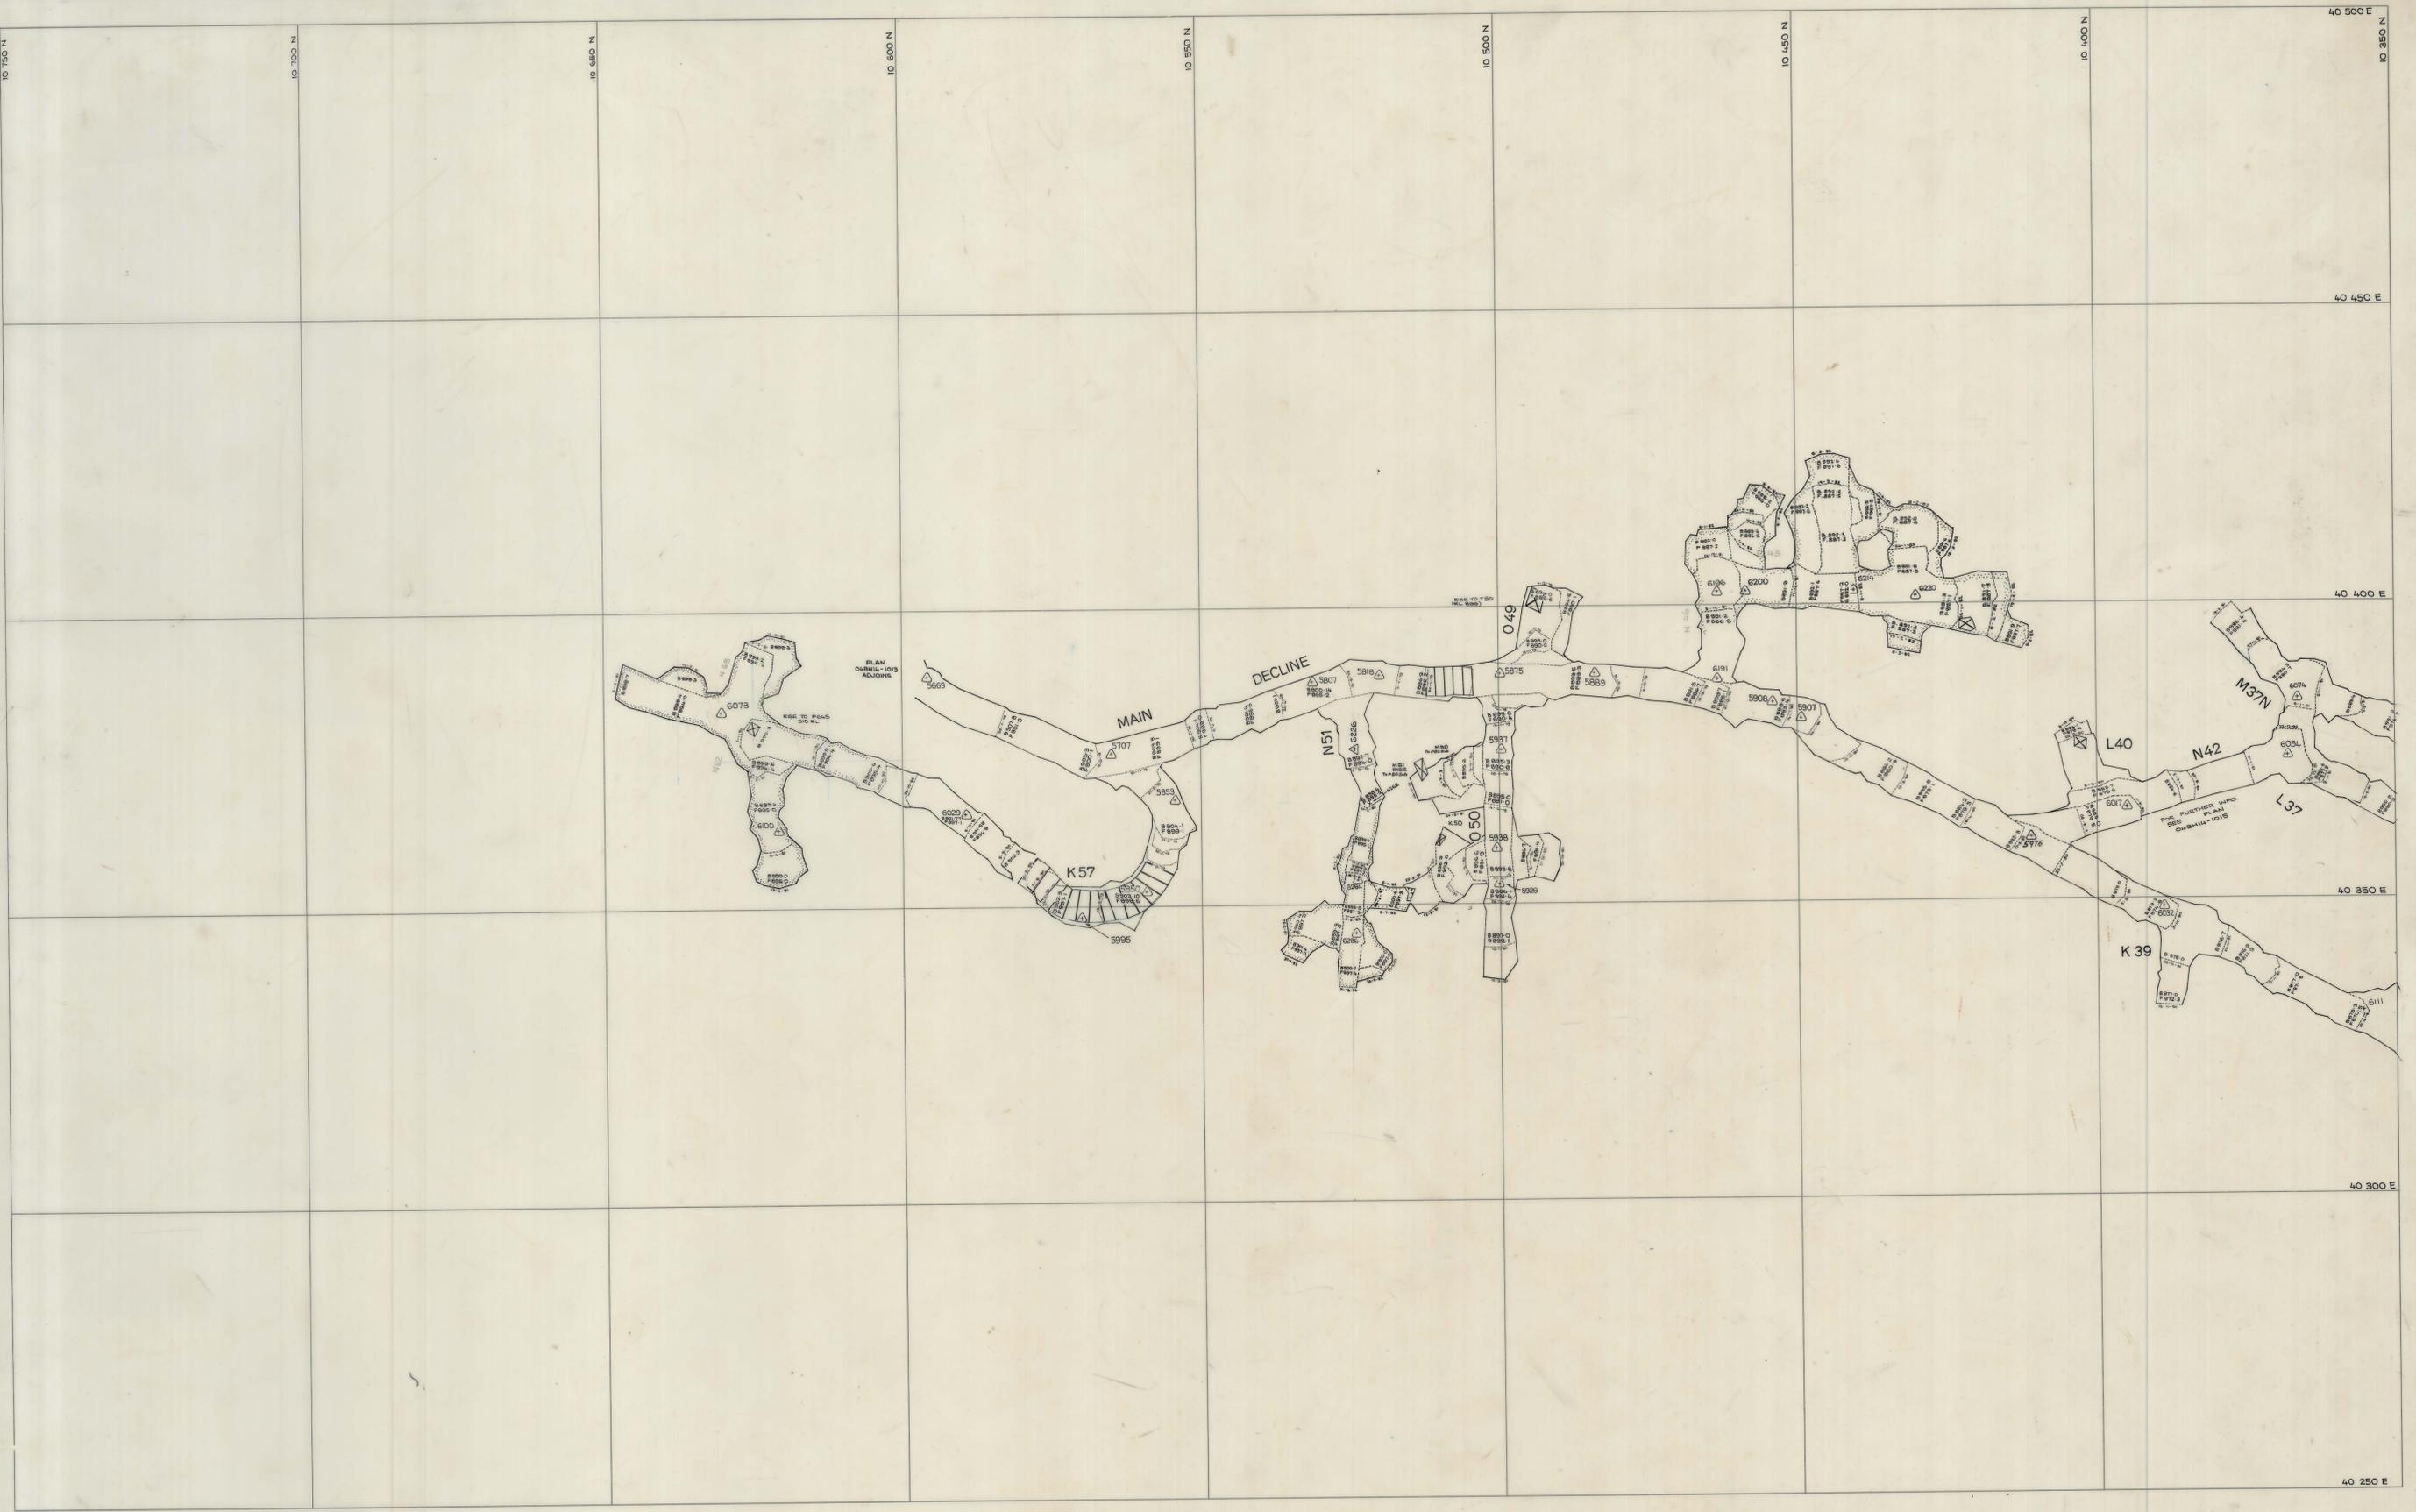


0374-241

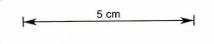

	SCALE 1: 500 	LOCATION BOLD HEAD MINE SUBJECT DECLINE DEVELOPMENT north	 A DIVISION OF WARRIOR INTERNATIONAL GRASSY KING ISLAND PLAN NUMBER 04BH14 - 1014
--	---	---	---