


NOTES

① R.L.s refer to floor

REVISIONS

1	29 DEC 74	Minor rev. of I16 removed Q13 redesigned	MM
2	12 JAN 75	Q13 redesigned	MM
3	5 FEB 75	Q13 redesigned	MM
4	4 MAR 75	M18 redesigned	DJP
5	10 JULY 75	Ramp fully redesigned	H.M.K.

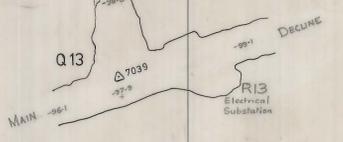

KING ISLAND SCHEELITE LTD.
 SCALE 1:500 | A1 | No 1-22-56
DOLPHIN MINE
 FOOTWALL RAMP DESIGN

DATE 12-11-74
 SURVEYED
 DRAWN M.D.B.
 TRACED
 CHECKED R.S.