


For more detailed plan of E.P.S. development see 03DM08-1009

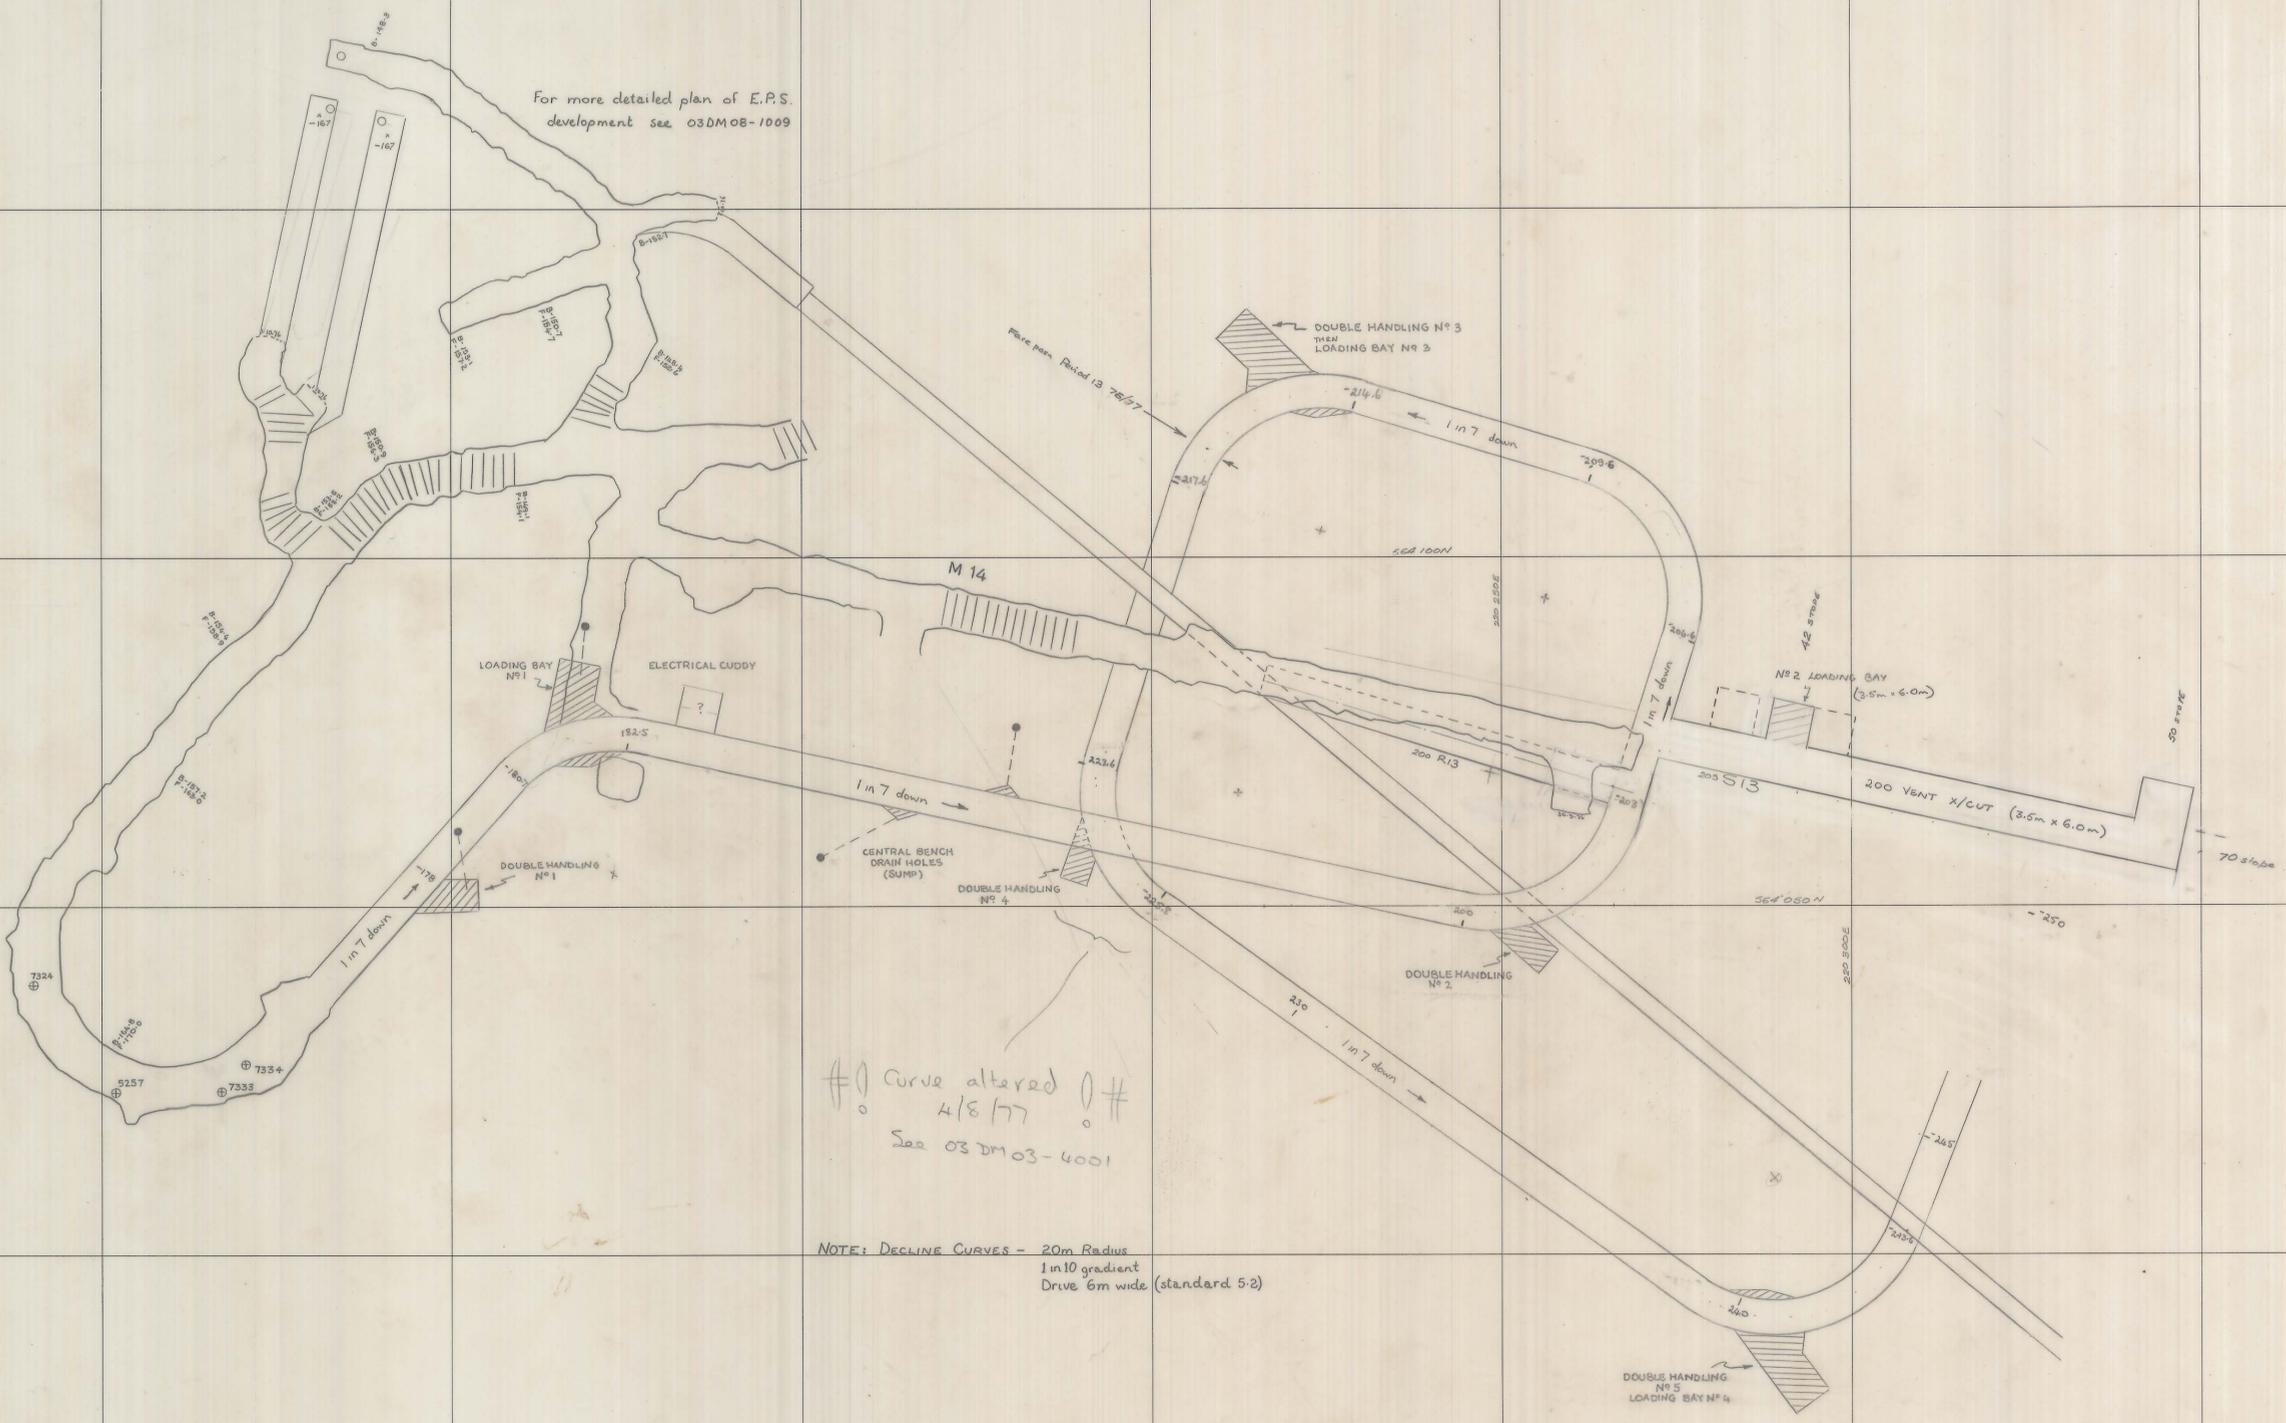

Curve altered 4/8/77 See 03DM03-4001

NOTE: DECLINE CURVES - 20m Radius 1 in 10 gradient Drive 6m wide (standard 52)

REVISIONS	DATE	DESCRIPTION	INITIALS
1	13.10.76	MAIN DECLINE - Minor Bearings Adjustment R.L.s redesigned	(initials)
2	22.11.76	DOUBLE HANDLING N° 1 - relocated R.L. Correction	(initials)
3	15.4.77	200m R.L. VENT X/CUT ADDED, N° 2 LOADING BAY RELOCATED	(initials)

KING ISLAND SCHEELITE		APPROVAL	
DATE: 13.10.76	SCALE: 1:500	PLANNING ENG.:	(initials)
MINE: DOLPHIN	DWG/NO.: 03 DM 03 1006	SENIOR PLAN. ENG.:	(initials)
MAIN DECLINE		MINE SUPT.:	(initials)
		G. MINING SUPT.:	(initials)
-150 to -250m. RL.		SENIOR SURV'R.:	(initials)
		SENIOR GEOLOGIST:	(initials)
PRELIMINARY	FINAL	SURVEYOR:	(initials)

COPY
1
2
1
1
1