

564 200N


564 150N

564 100N

564 050N

564 000N

563 950N

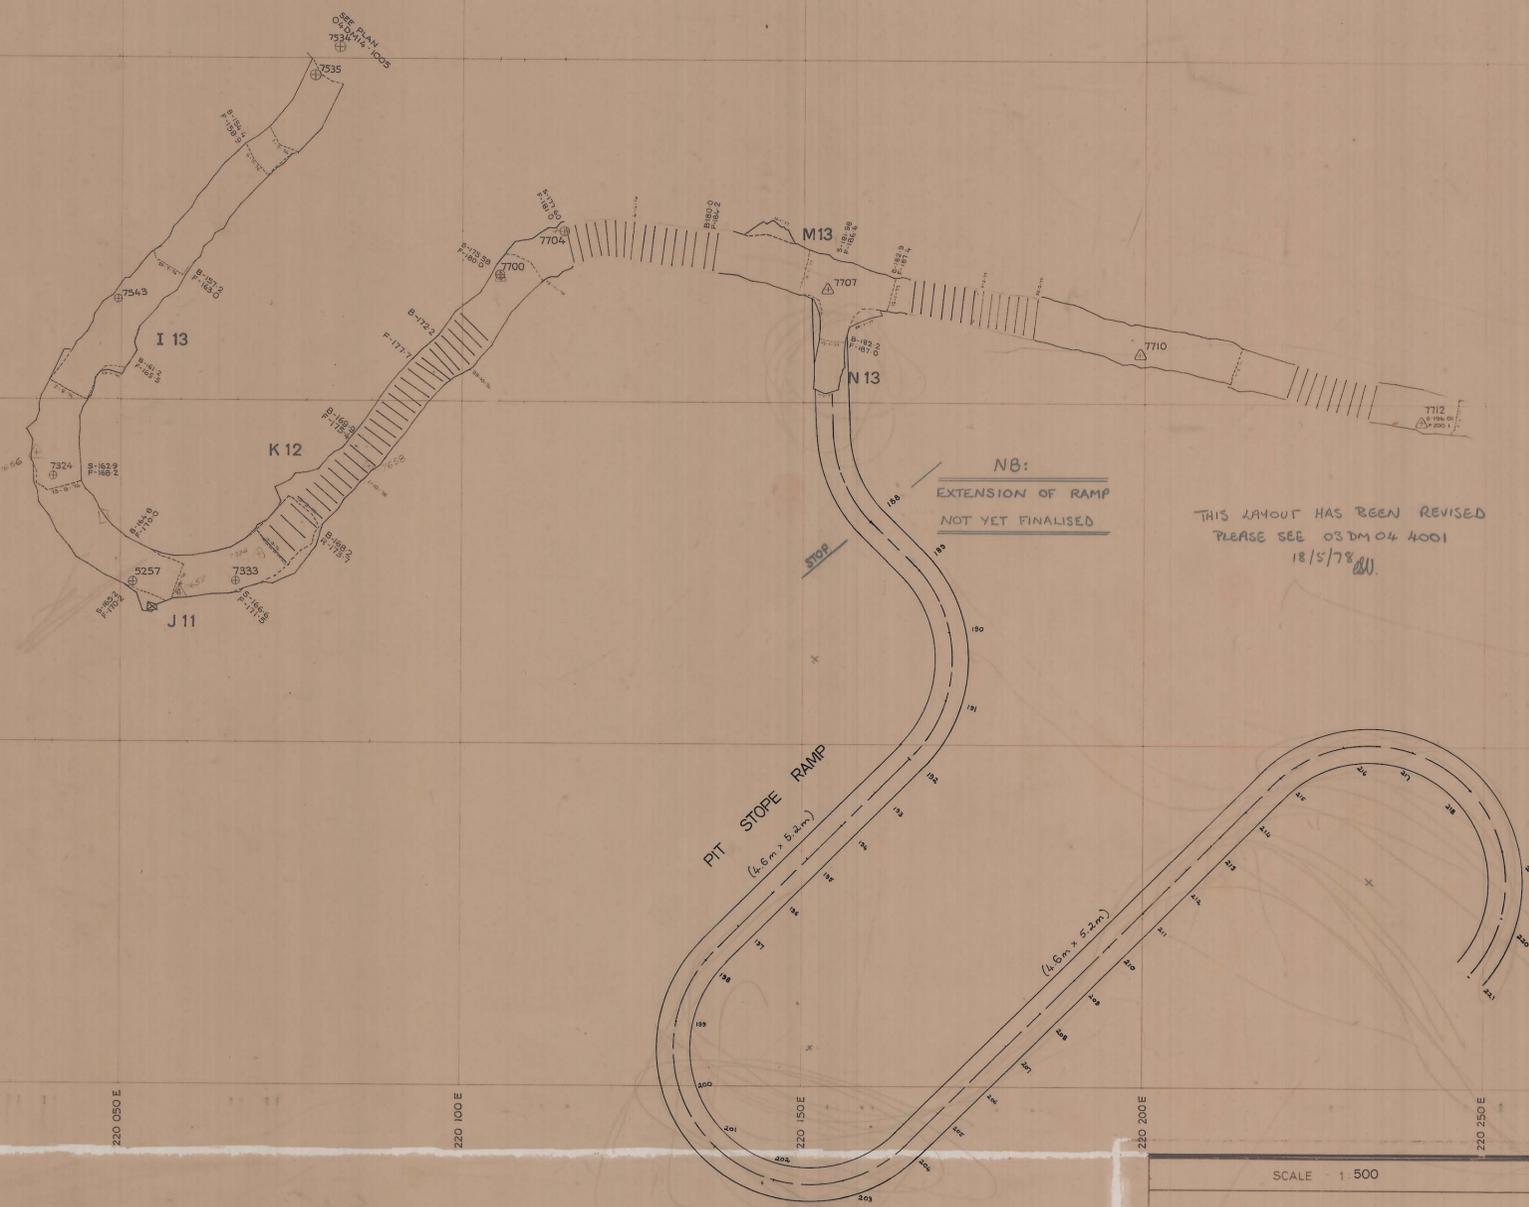


NB:
 EXTENSION OF RAMP
 NOT YET FINALISED

THIS LAYOUT HAS BEEN REVISED
 PLEASE SEE 03DM04 4001
 18/5/78 *AW*

KING ISLAND SCHEELITE		APPROVAL	COPY
DATE: 7 APRIL 1978	SCALE: 1:500	PLANNING ENG.: <i>AW 7/4/78</i>	
MINE: DOLPHIN MINE	DWG/NO.: 03 DM 03 1009	SENIOR PLAN. ENG.: <i>AS 2/4/78</i>	
N13 PIT STOPE RAMP		MINE SUPT.: <i>AW 7/4/78</i>	2
		G. MINING SUPT.:	
		SENIOR SURV'R.: <i>AW 7/4/78</i>	
		SENIOR GEOLOGIST: <i>AW 14/1/78</i>	1
PRELIMINARY <input checked="" type="checkbox"/> FINAL <input type="checkbox"/>			

220 000 E 220 050 E 220 100 E 220 150 E 220 200 E 220 250 E 220 300 E 220 350 E 220 400 E

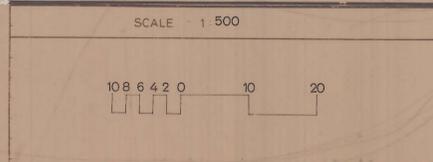

LOCATION: DOLPHIN MINE
 SUBJECT: - 175 m ZONE
 F - 162 m to B - 187 m

KIS KING ISLAND SCHEELITE
 A DIVISION OF WARMAN INTERNATIONAL
 GRASSY KING ISLAND
 PLAN NUMBER: 03 DM 03 1009