


0374-244

04BH15-1002

5 cm

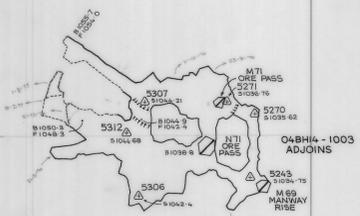

SCALE 1:500

north

LOCATION BOLD HEAD MINE

SUBJECT M 71 STOPE UPPER B LENS

KIS KING ISLAND SCHEELITE A DIVISION OF WARMAN INTERNATIONAL

GRASSY KING ISLAND

PLAN NUMBER 04BH15 - 1002