


0374_2442

01 DM 07 3002

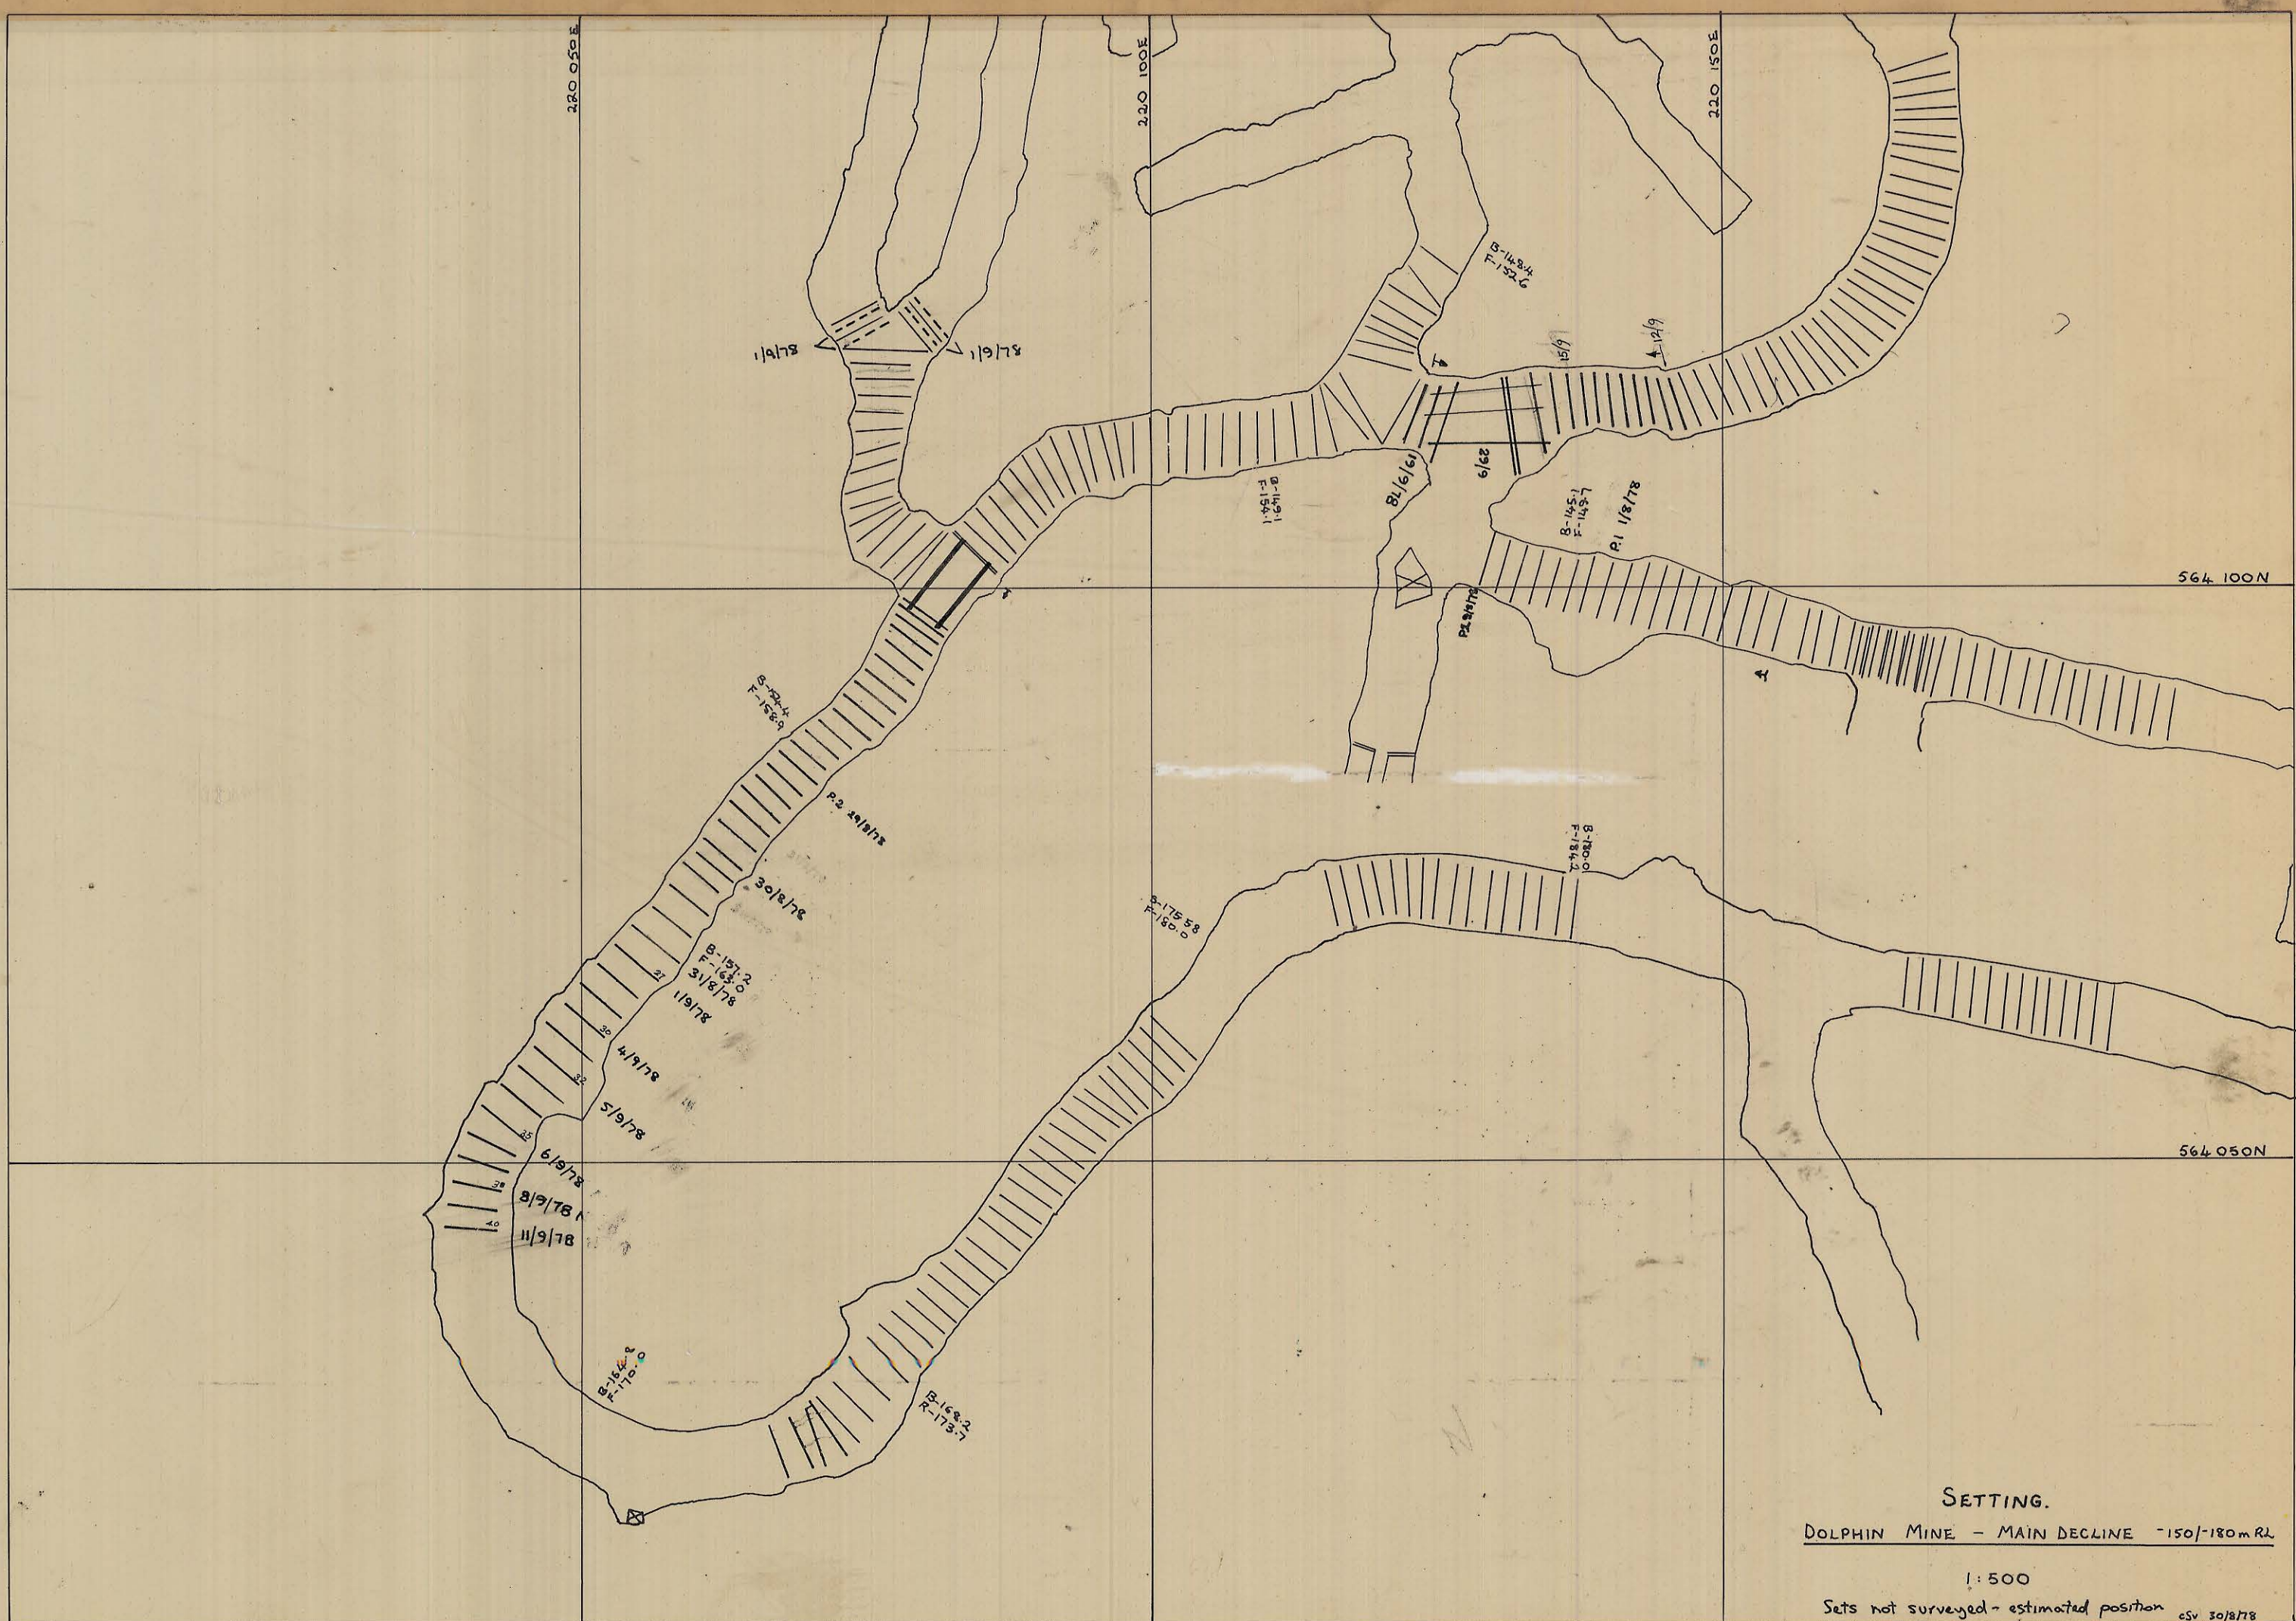

SETTING.
DOLPHIN MINE - MAIN DECLINE -150/-180m RL
1:500
Sets not surveyed - estimated position c/v 30/8/78