


27 JUN 1981

0374-245

04BH15-1003

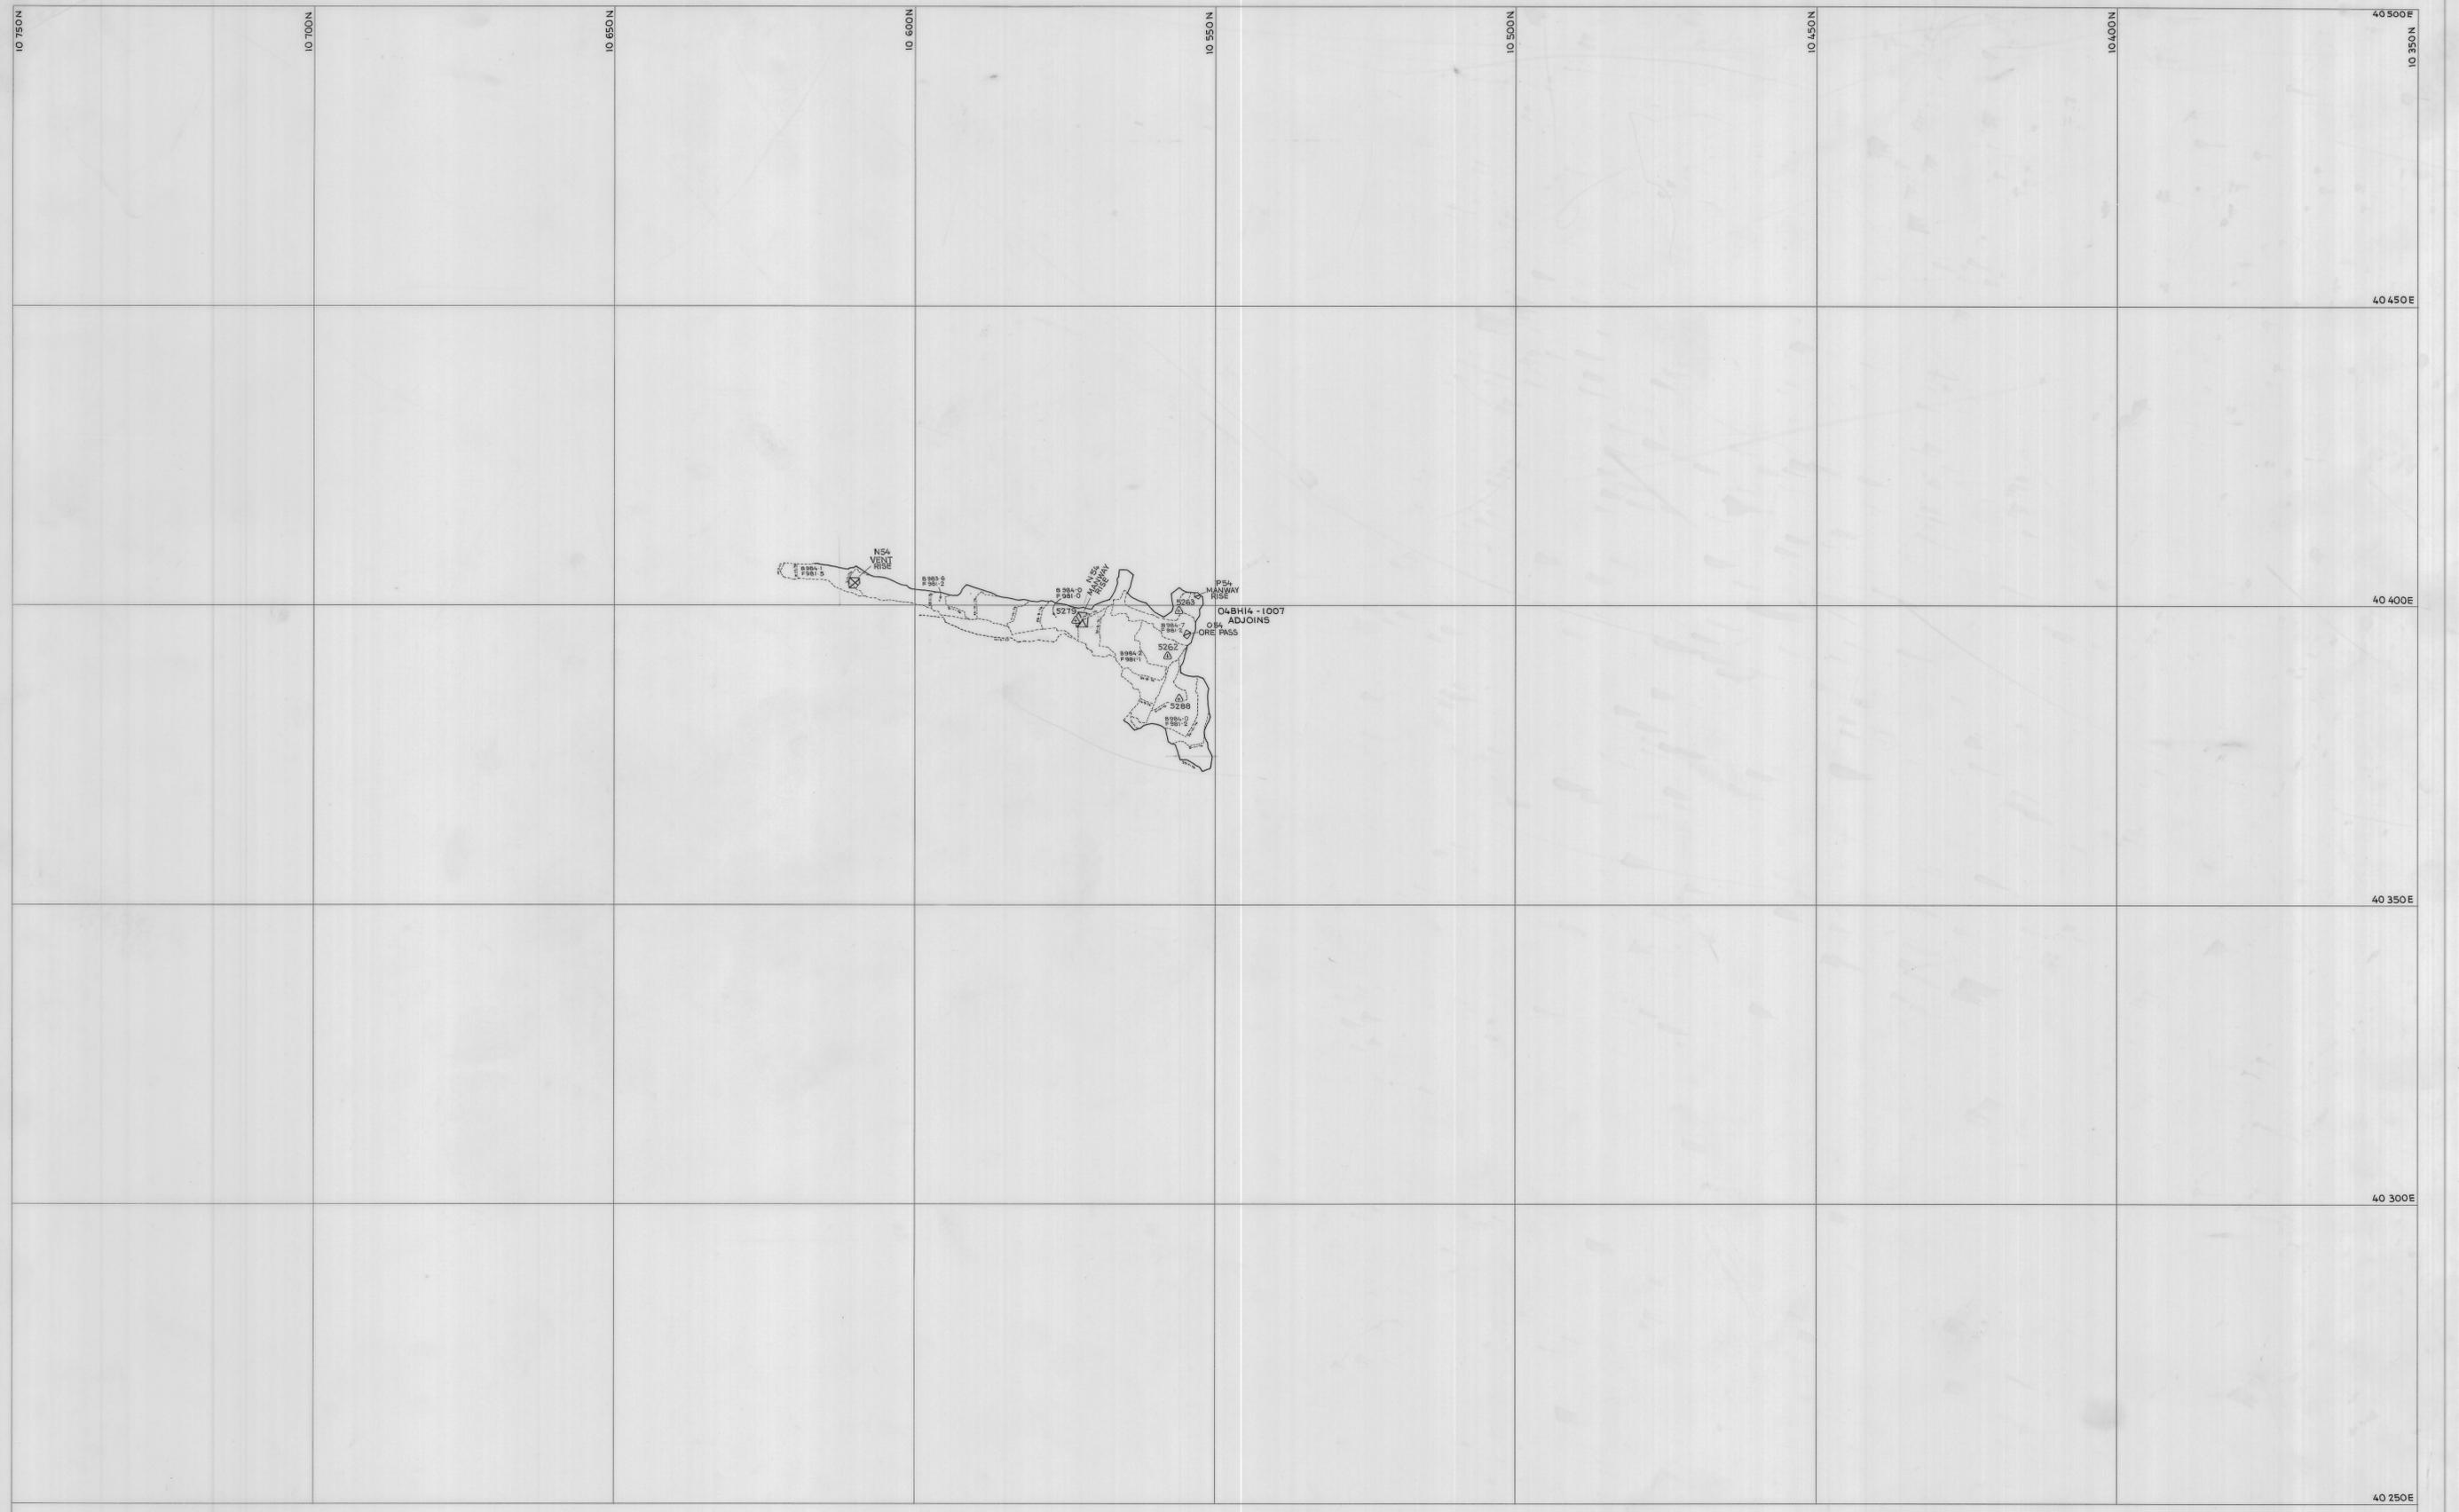

	<p>SCALE 1:500</p>	<p>LOCATION BOLD HEAD MINE</p> <p>SUBJECT</p> <p>N 54 STOPE B LENS FAULT BLOCK</p> <p>north</p>	<p>KIS KING ISLAND SCHEELITE A DIVISION OF WARMAN INTERNATIONAL</p> <p>GRASSY KING ISLAND</p> <p>PLAN NUMBER</p> <p>04BH15 - 1003</p> <p>M 23/5/77</p>
--	--------------------	--	--