




**CROSS SECTION 3**  
2.5m IN FROM DECLINE  
Looking East  
Scale 1:50

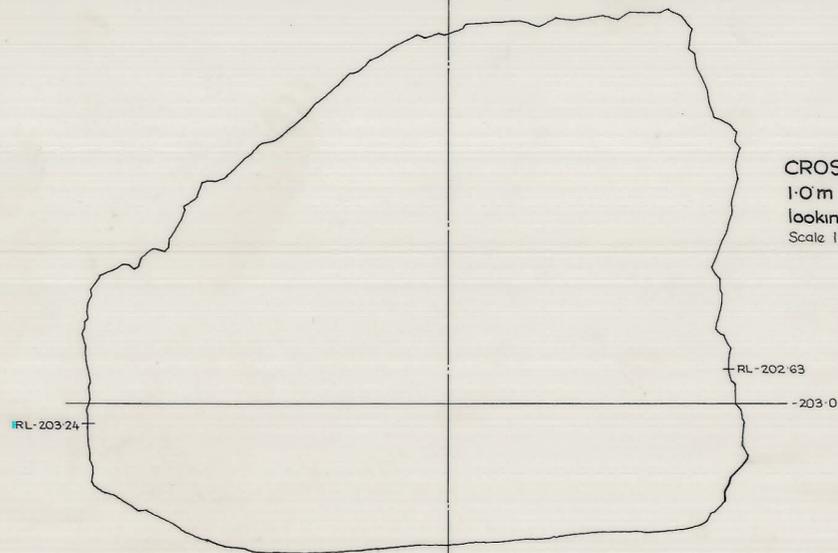


**CROSS SECTION 2**  
1.0m IN FROM DECLINE  
looking East  
Scale 1:50

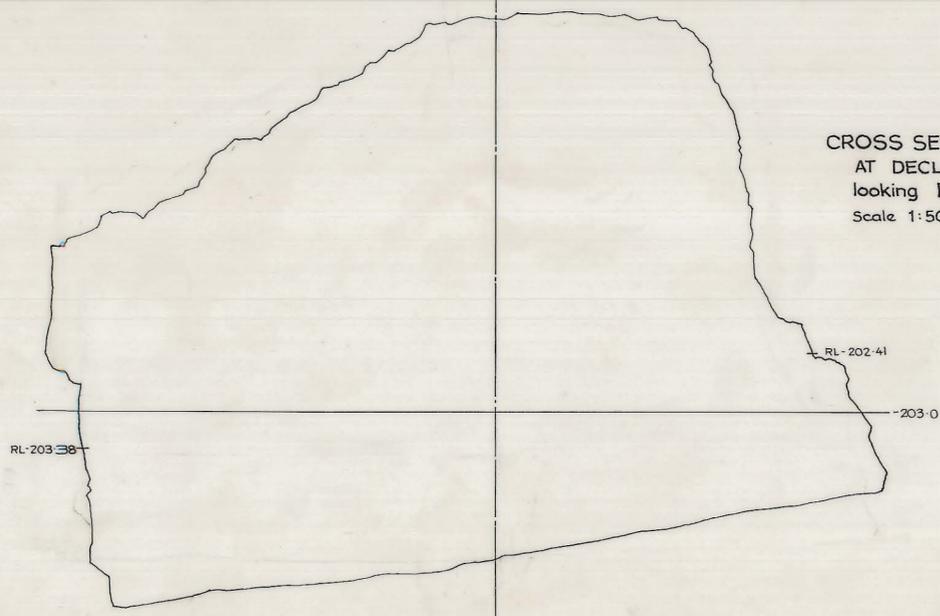


**CROSS SECTION 1**  
AT DECLINE  
looking East  
Scale 1:50

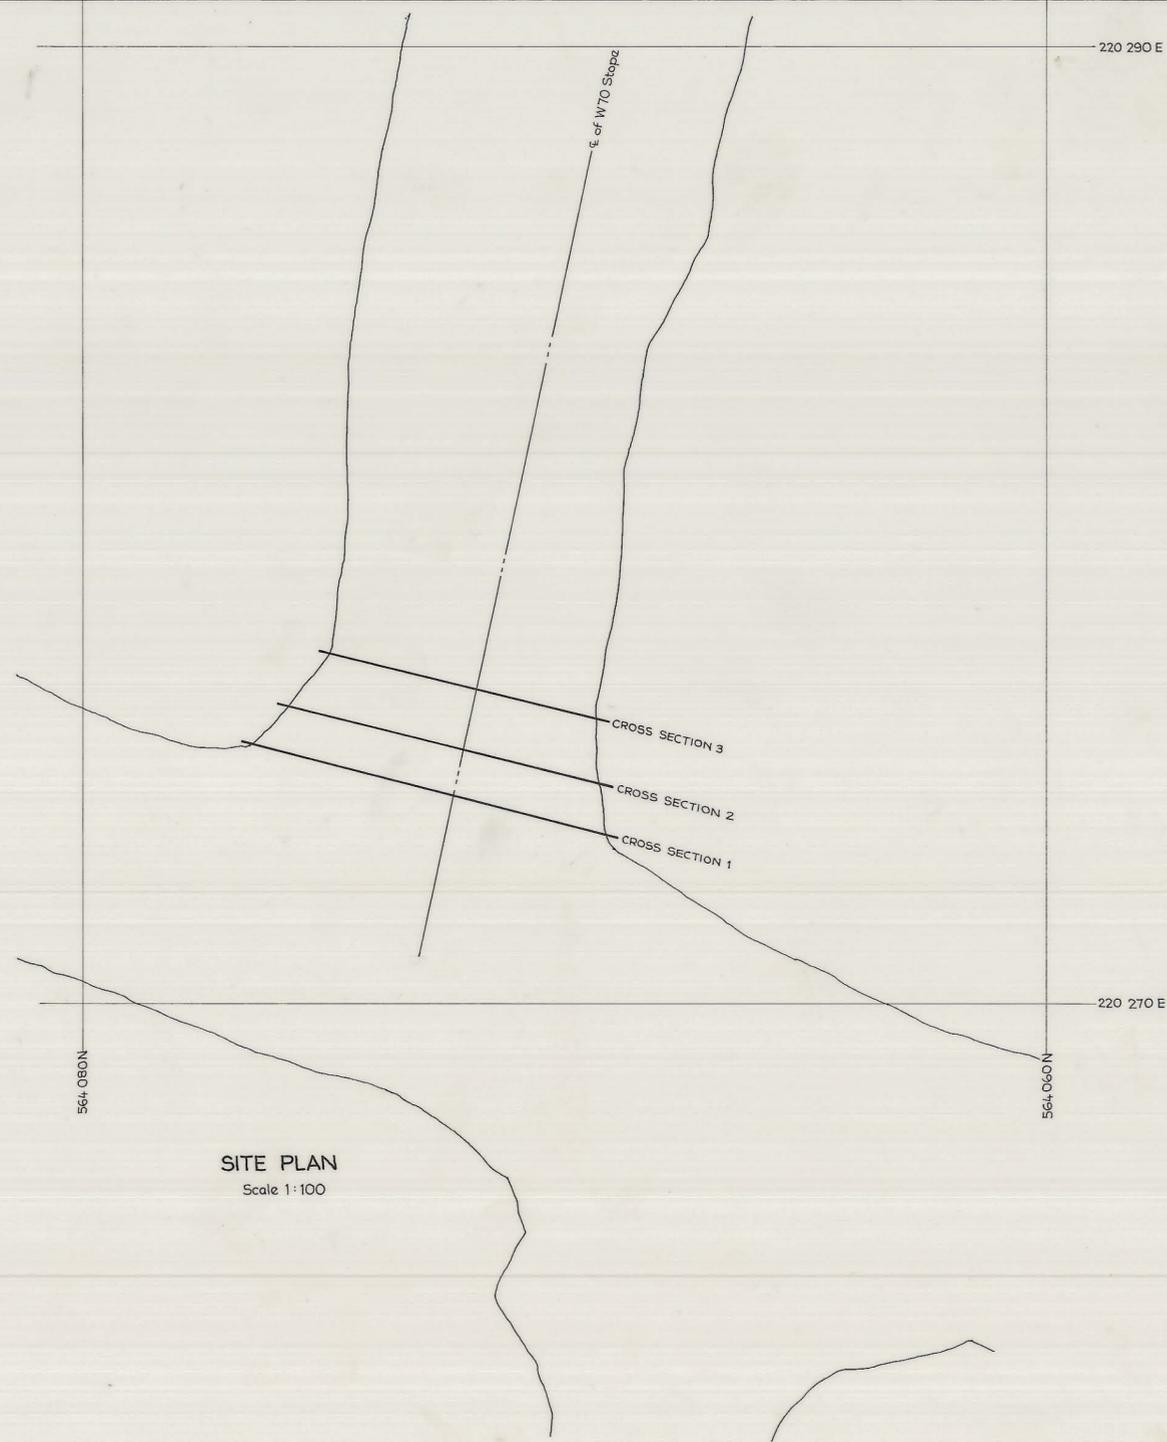

**SITE PLAN**  
Scale 1:100

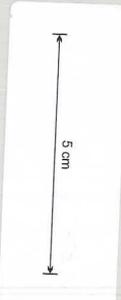

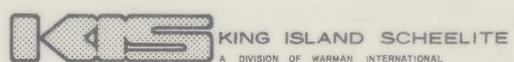LOCATION	DOLPHIN MINE	 KING ISLAND SCHEELITE <small>A DIVISION OF WARMAN INTERNATIONAL</small>
SUBJECT	S13 SETS - 200m LEVEL	
PLAN NUMBER	01DM07 - 2001	

01DM07 - 2001

0374\_2452