


0374-247

04BH15-102-94

P62
7th
Lift

5 cm

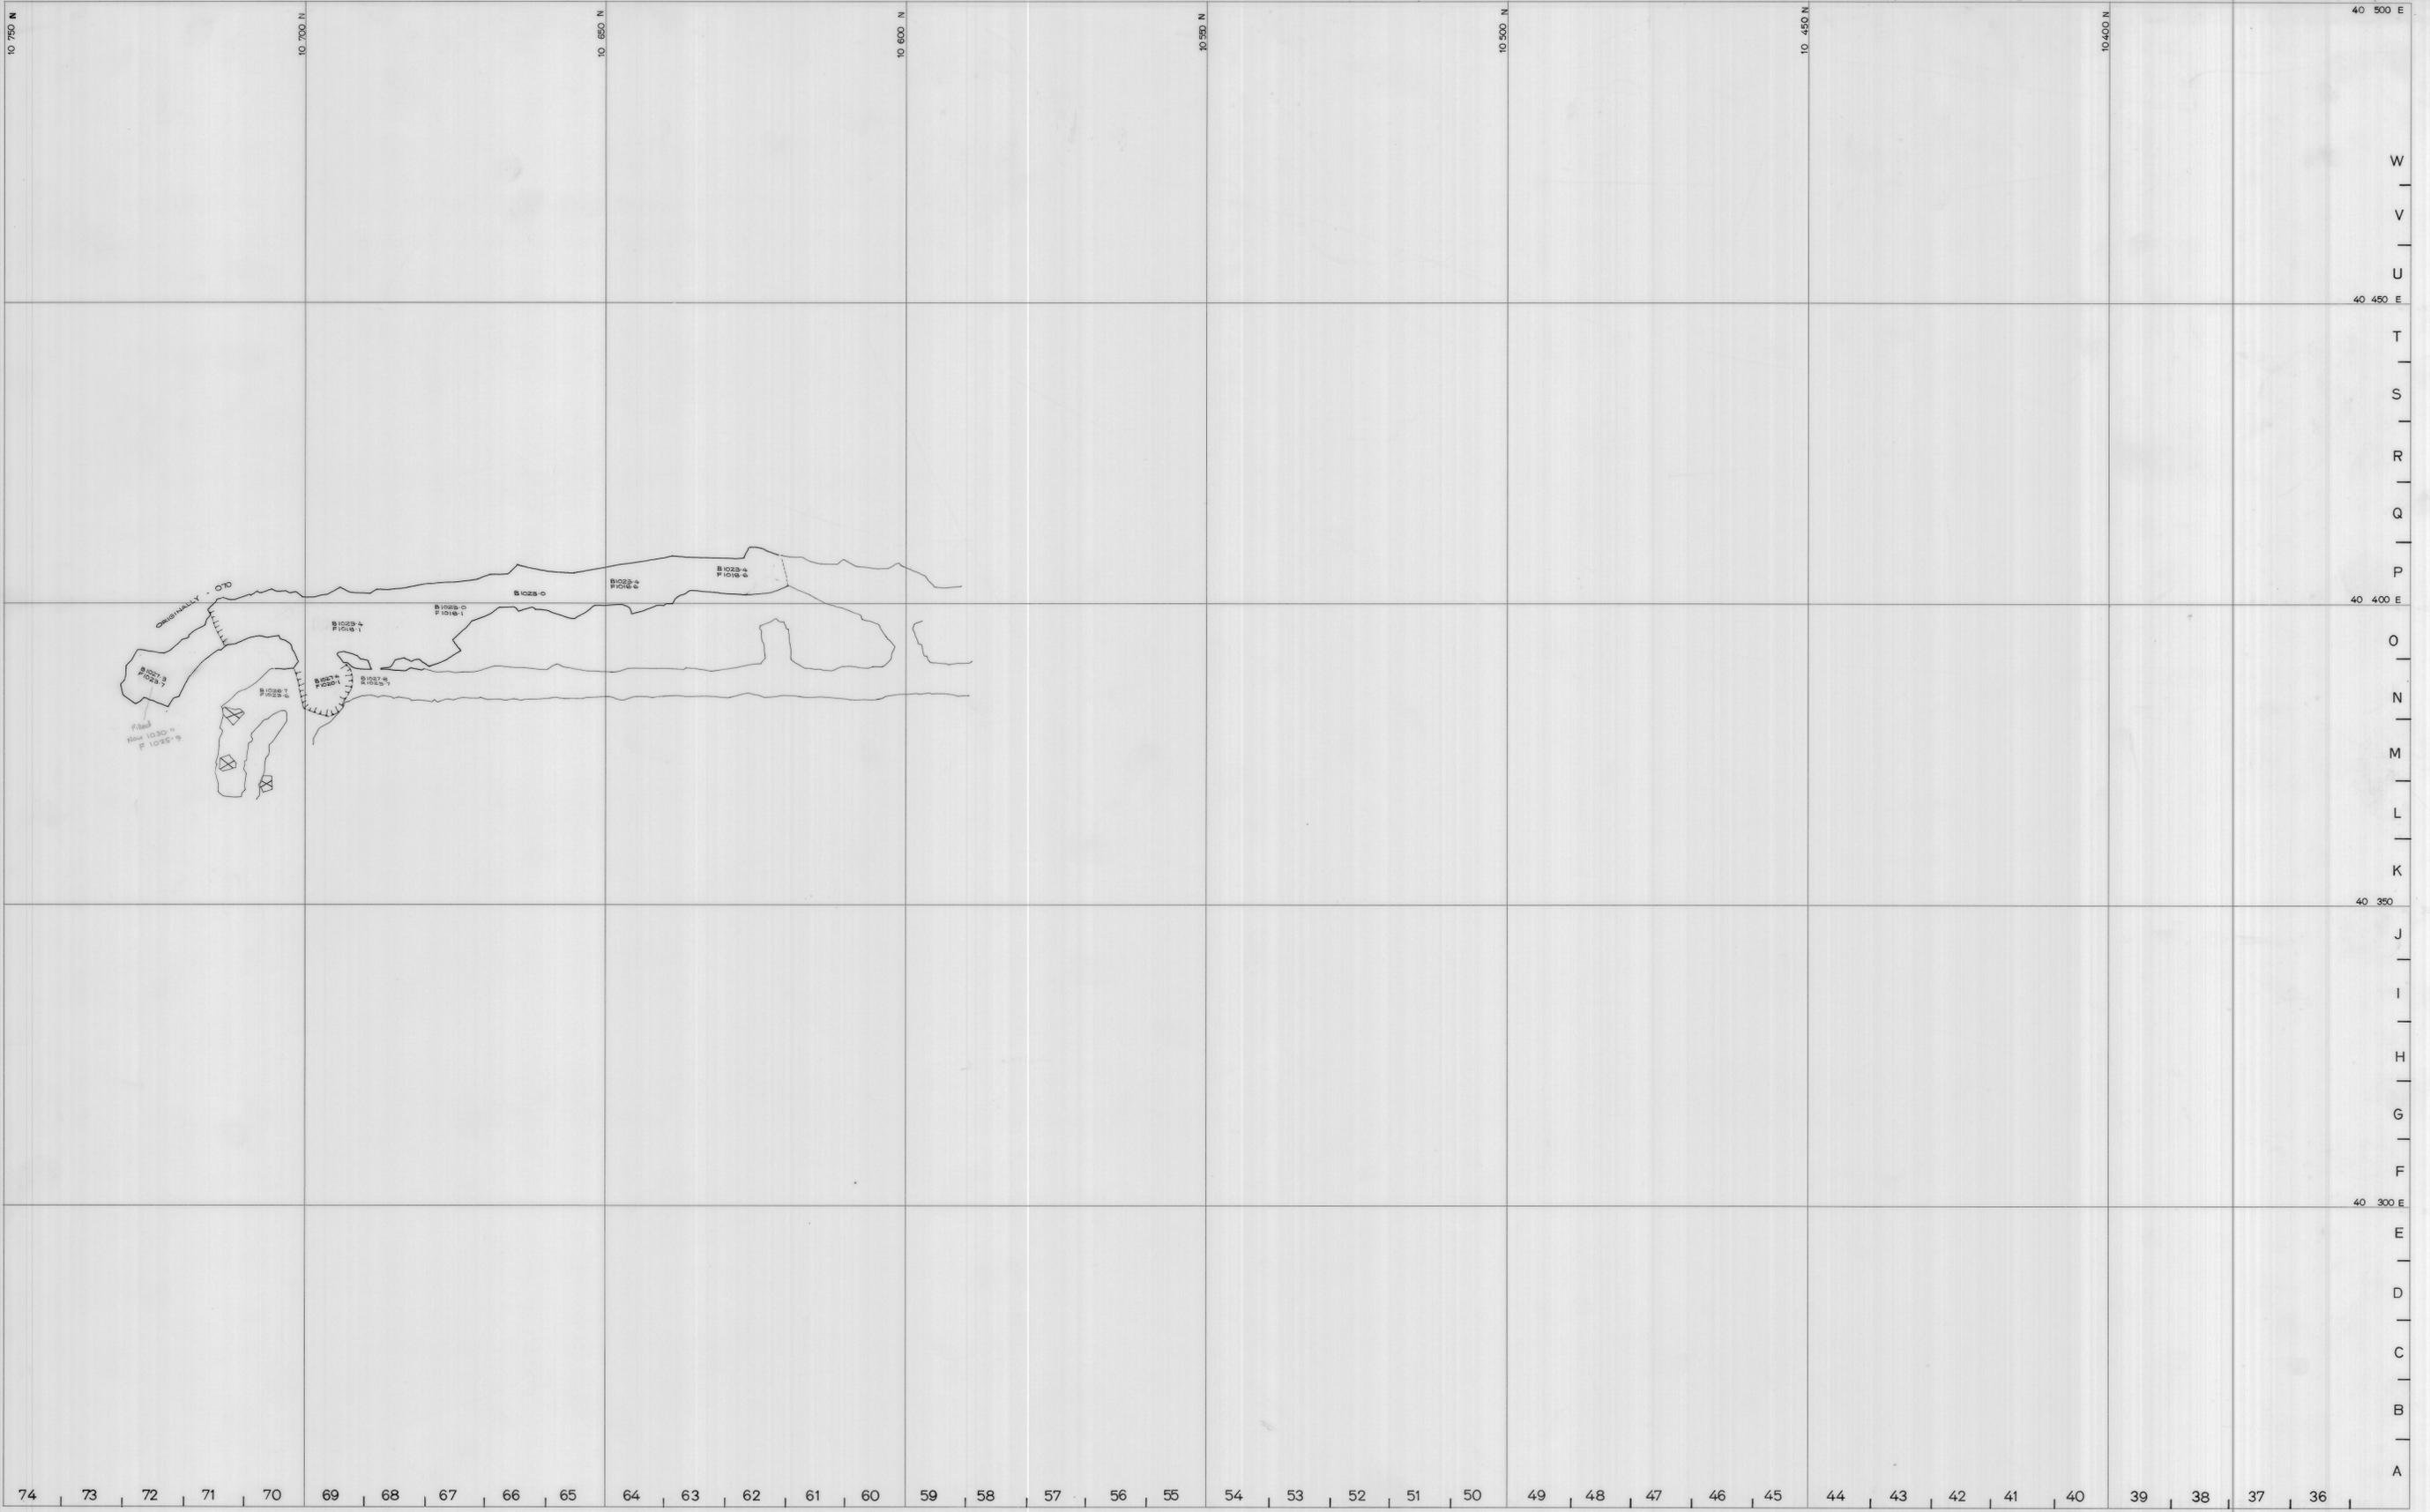

SCALE 1 500		LOCATION BOLD HEAD MINE	 <small>A DIVISION OF WARMAN INTERNATIONAL</small> GRASSY KING ISLAND
		SUBJECT P62 STOPE [6th Lift]	
		north	PLAN NUMBER 04BH15-102-94