


5 cm

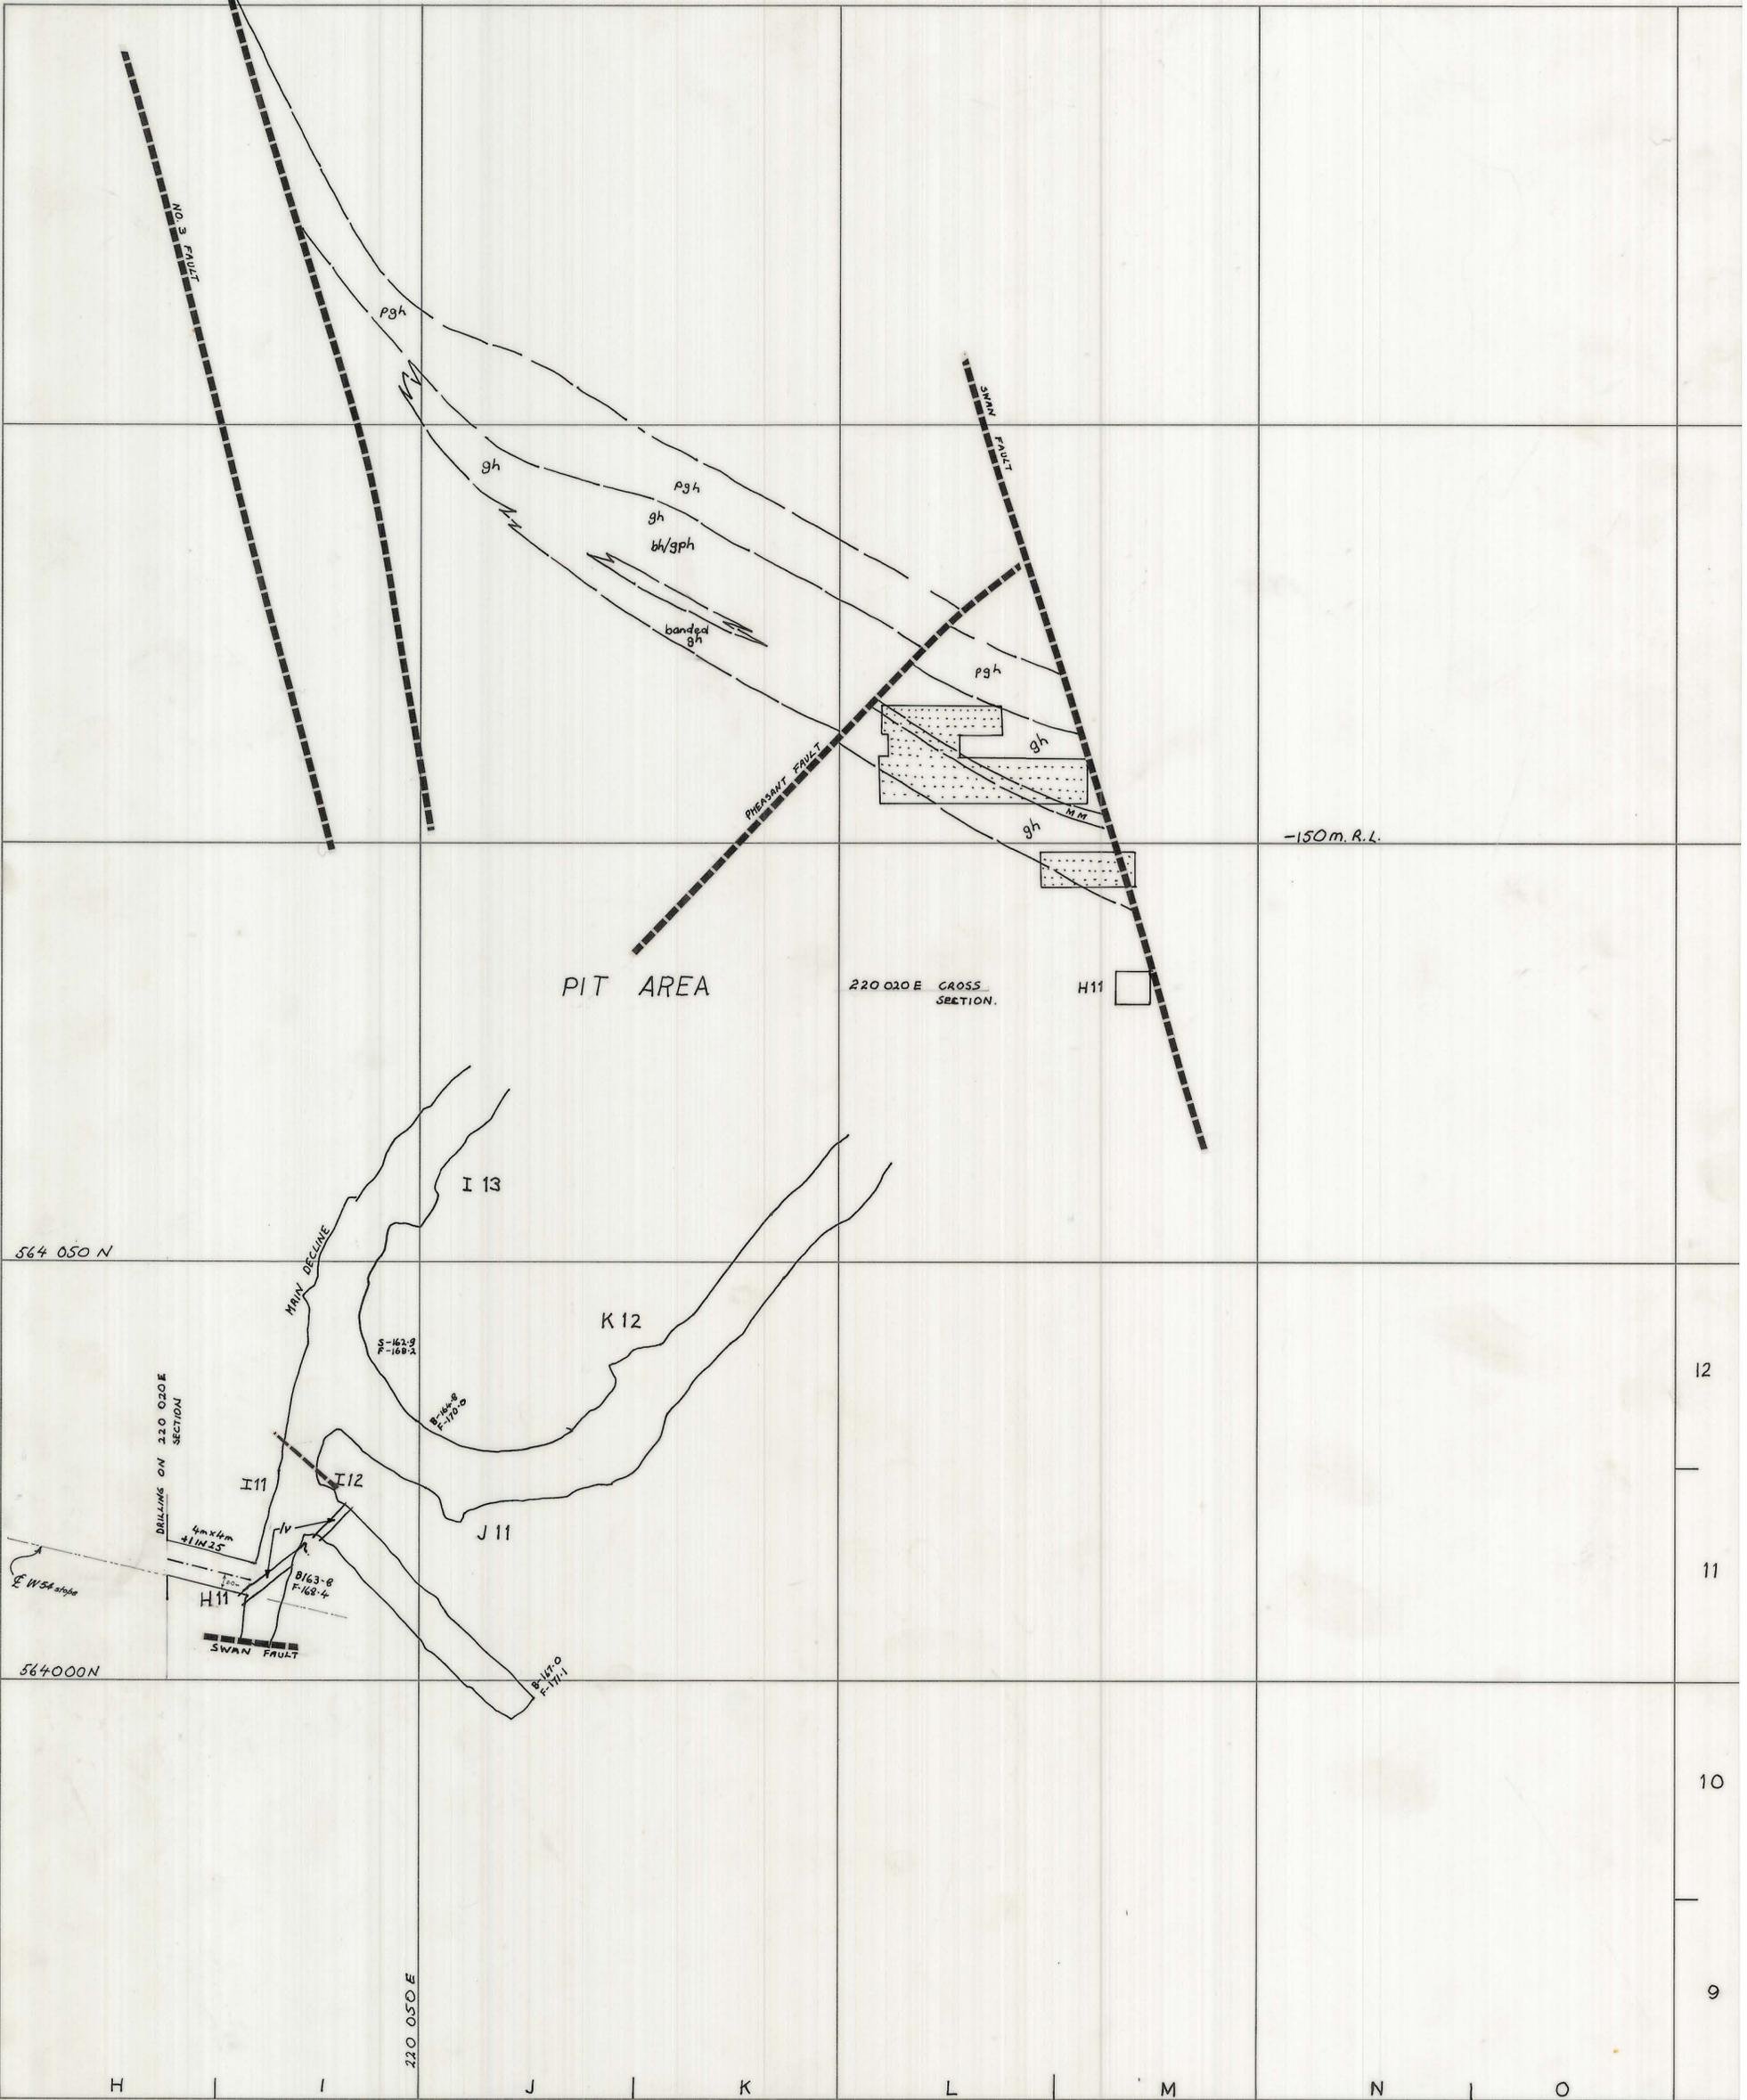

KING ISLAND SCHEELITE

DATE: 12 FEB 1979 SCALE: 1:500
MINE: DELPHIN DWG/NO.: 03DM03-2002/1

APPROVAL

PLANNING ENG.: *awicks*
SENIOR PLAN. ENG.: *LDN*
MINE SUPT.: *B*
G. MINING SUPT.: *Don*
SENIOR SURV'R.: *Don 11/1/79*
SENIOR GEOLOGIST: *49 Ruyter 12/2/79*
SURVEYOR: *Clair*

COPY

PRELIMINARY FINAL