




03DM103-1014
DOL. DEC. -260 to -280m

0374_2483

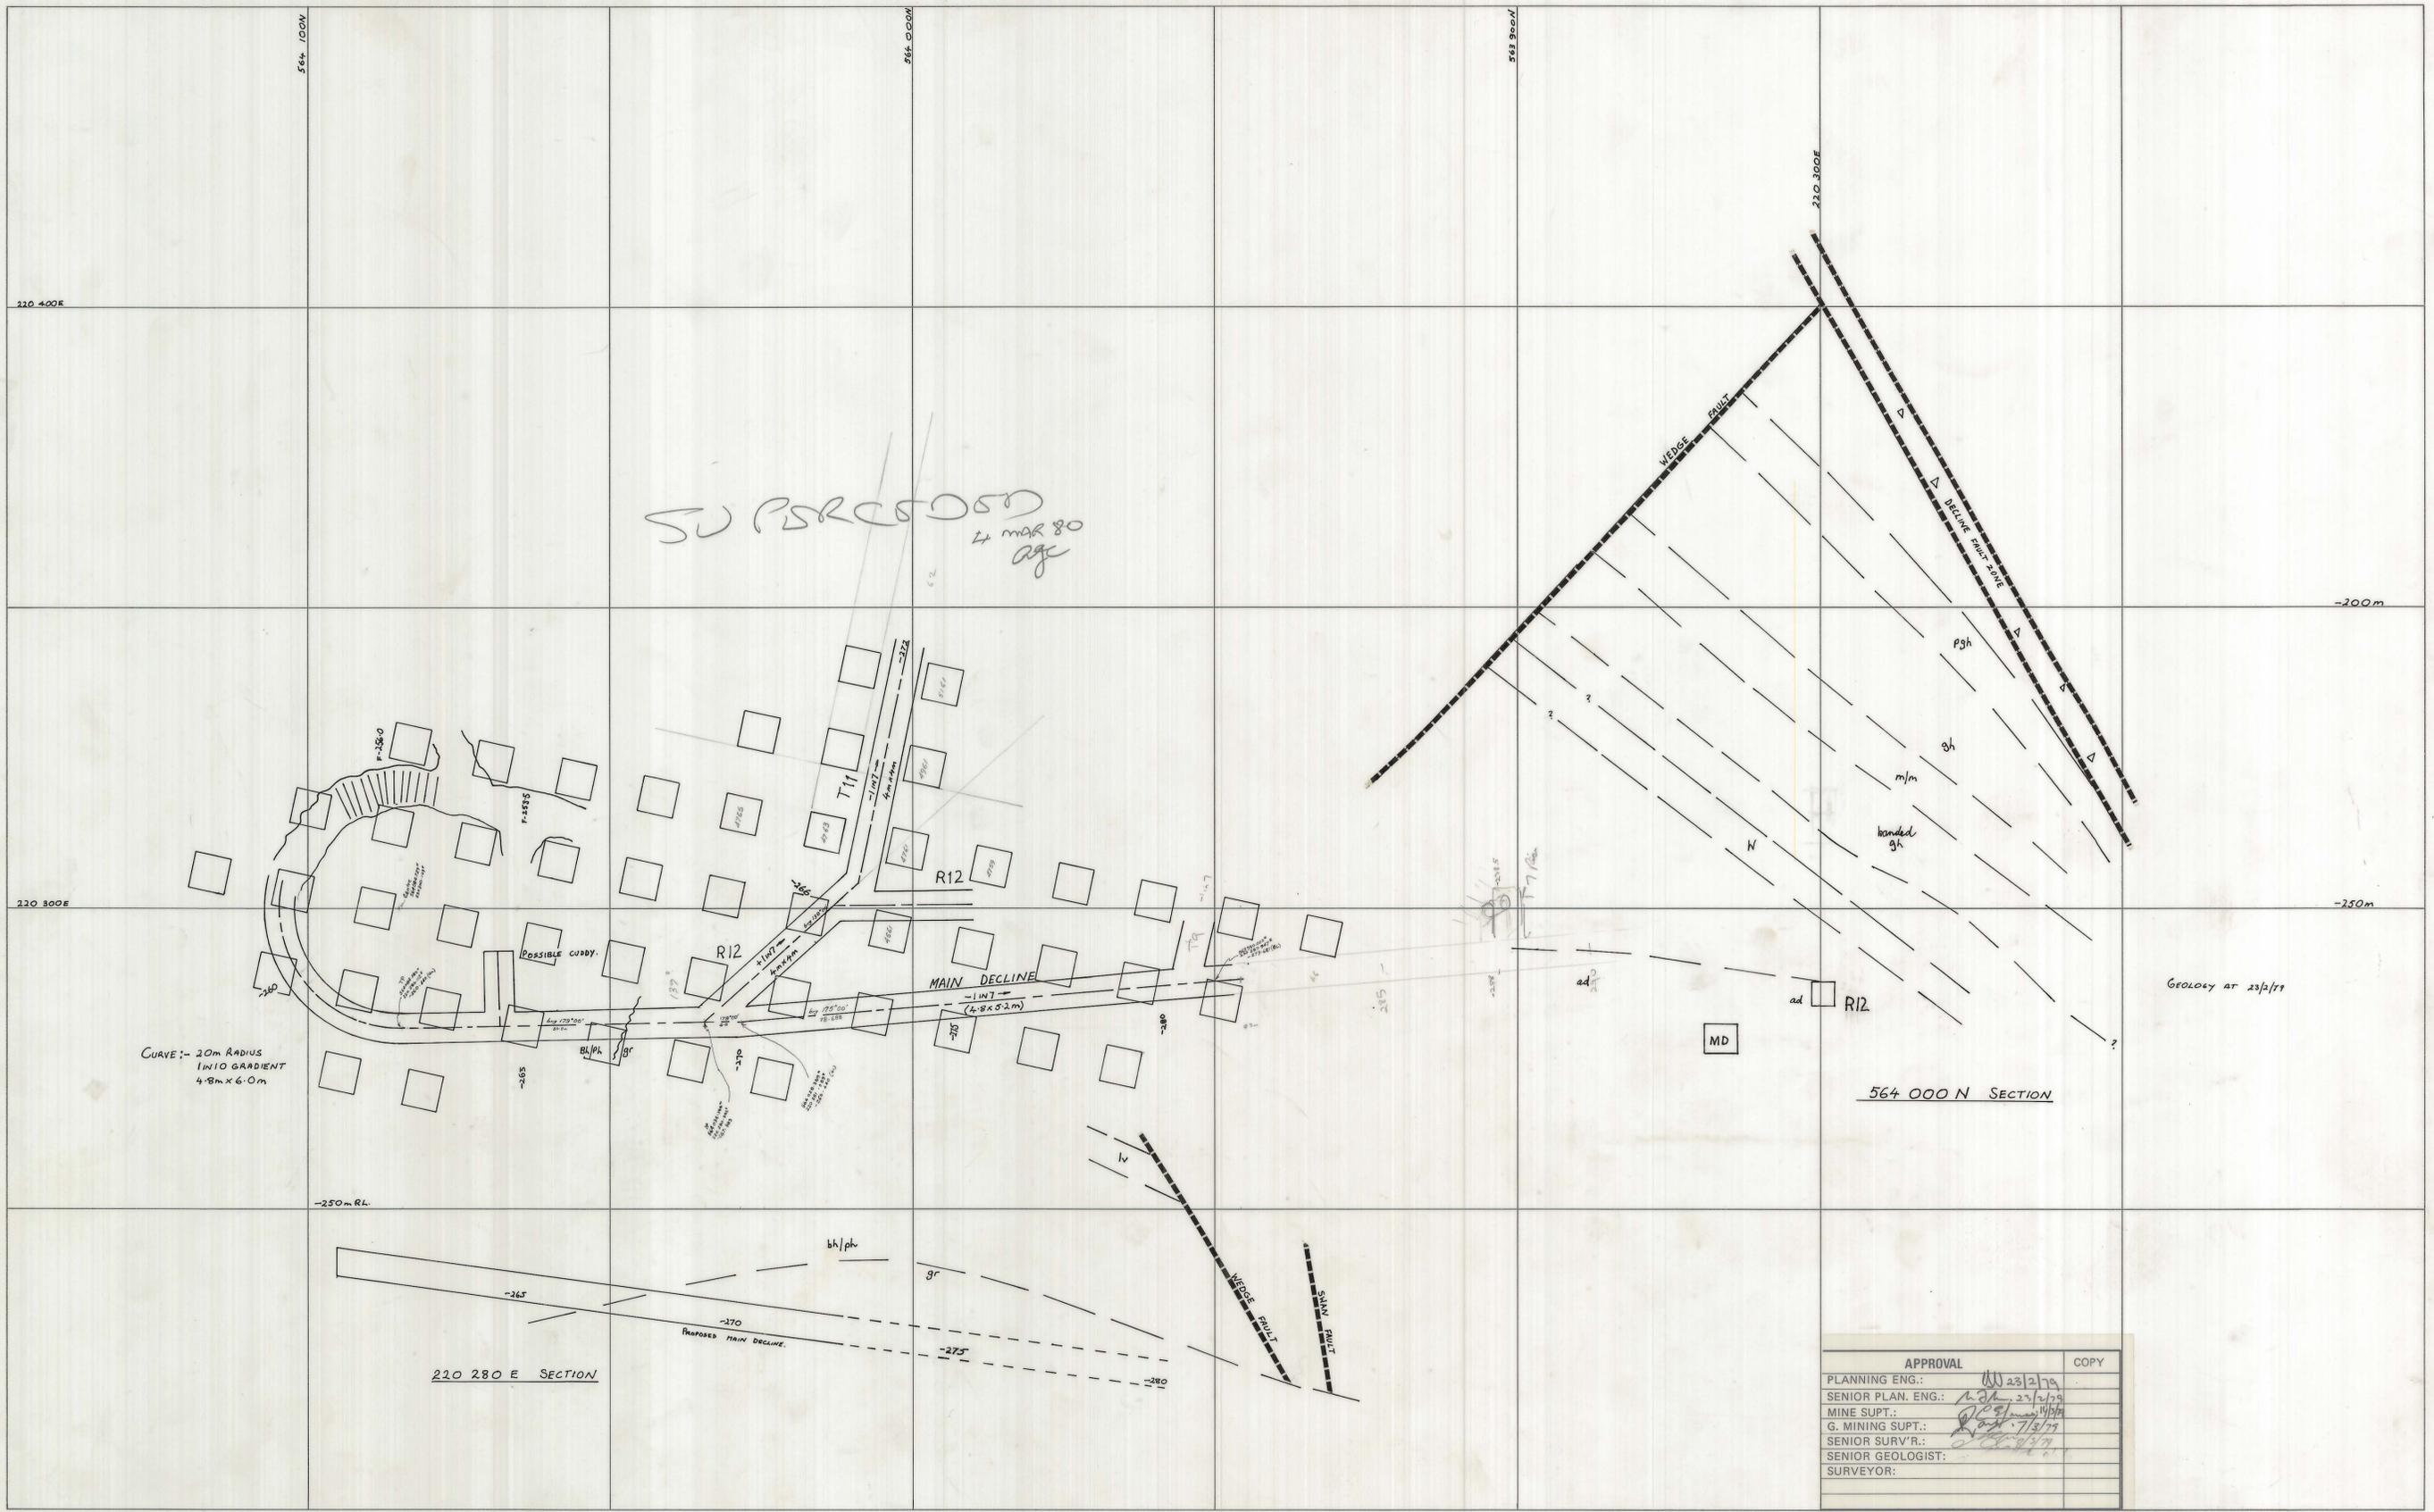

APPROVAL		COPY
PLANNING ENG.:	<i>[Signature]</i> 23/2/79	
SENIOR PLAN. ENG.:	<i>[Signature]</i> 23/2/79	
MINE SUPT.:	<i>[Signature]</i> 11/3/79	
G. MINING SUPT.:	<i>[Signature]</i> 7/3/79	
SENIOR SURV'R.:	<i>[Signature]</i>	
SENIOR GEOLOGIST:	<i>[Signature]</i>	
SURVEYOR:		

SCALE 1:500	<p>north</p>	LOCATION DOLPHIN MINE	KING ISLAND SCHEELITE A DIVISION OF WARMAN INTERNATIONAL GRASSY KING ISLAND
		SUBJECT MAIN DECLINE -260 to -280 mRL	