


27 JUN 1981

0374-249

04BH15-102-96

P 62
4th
LIFT

5 cm

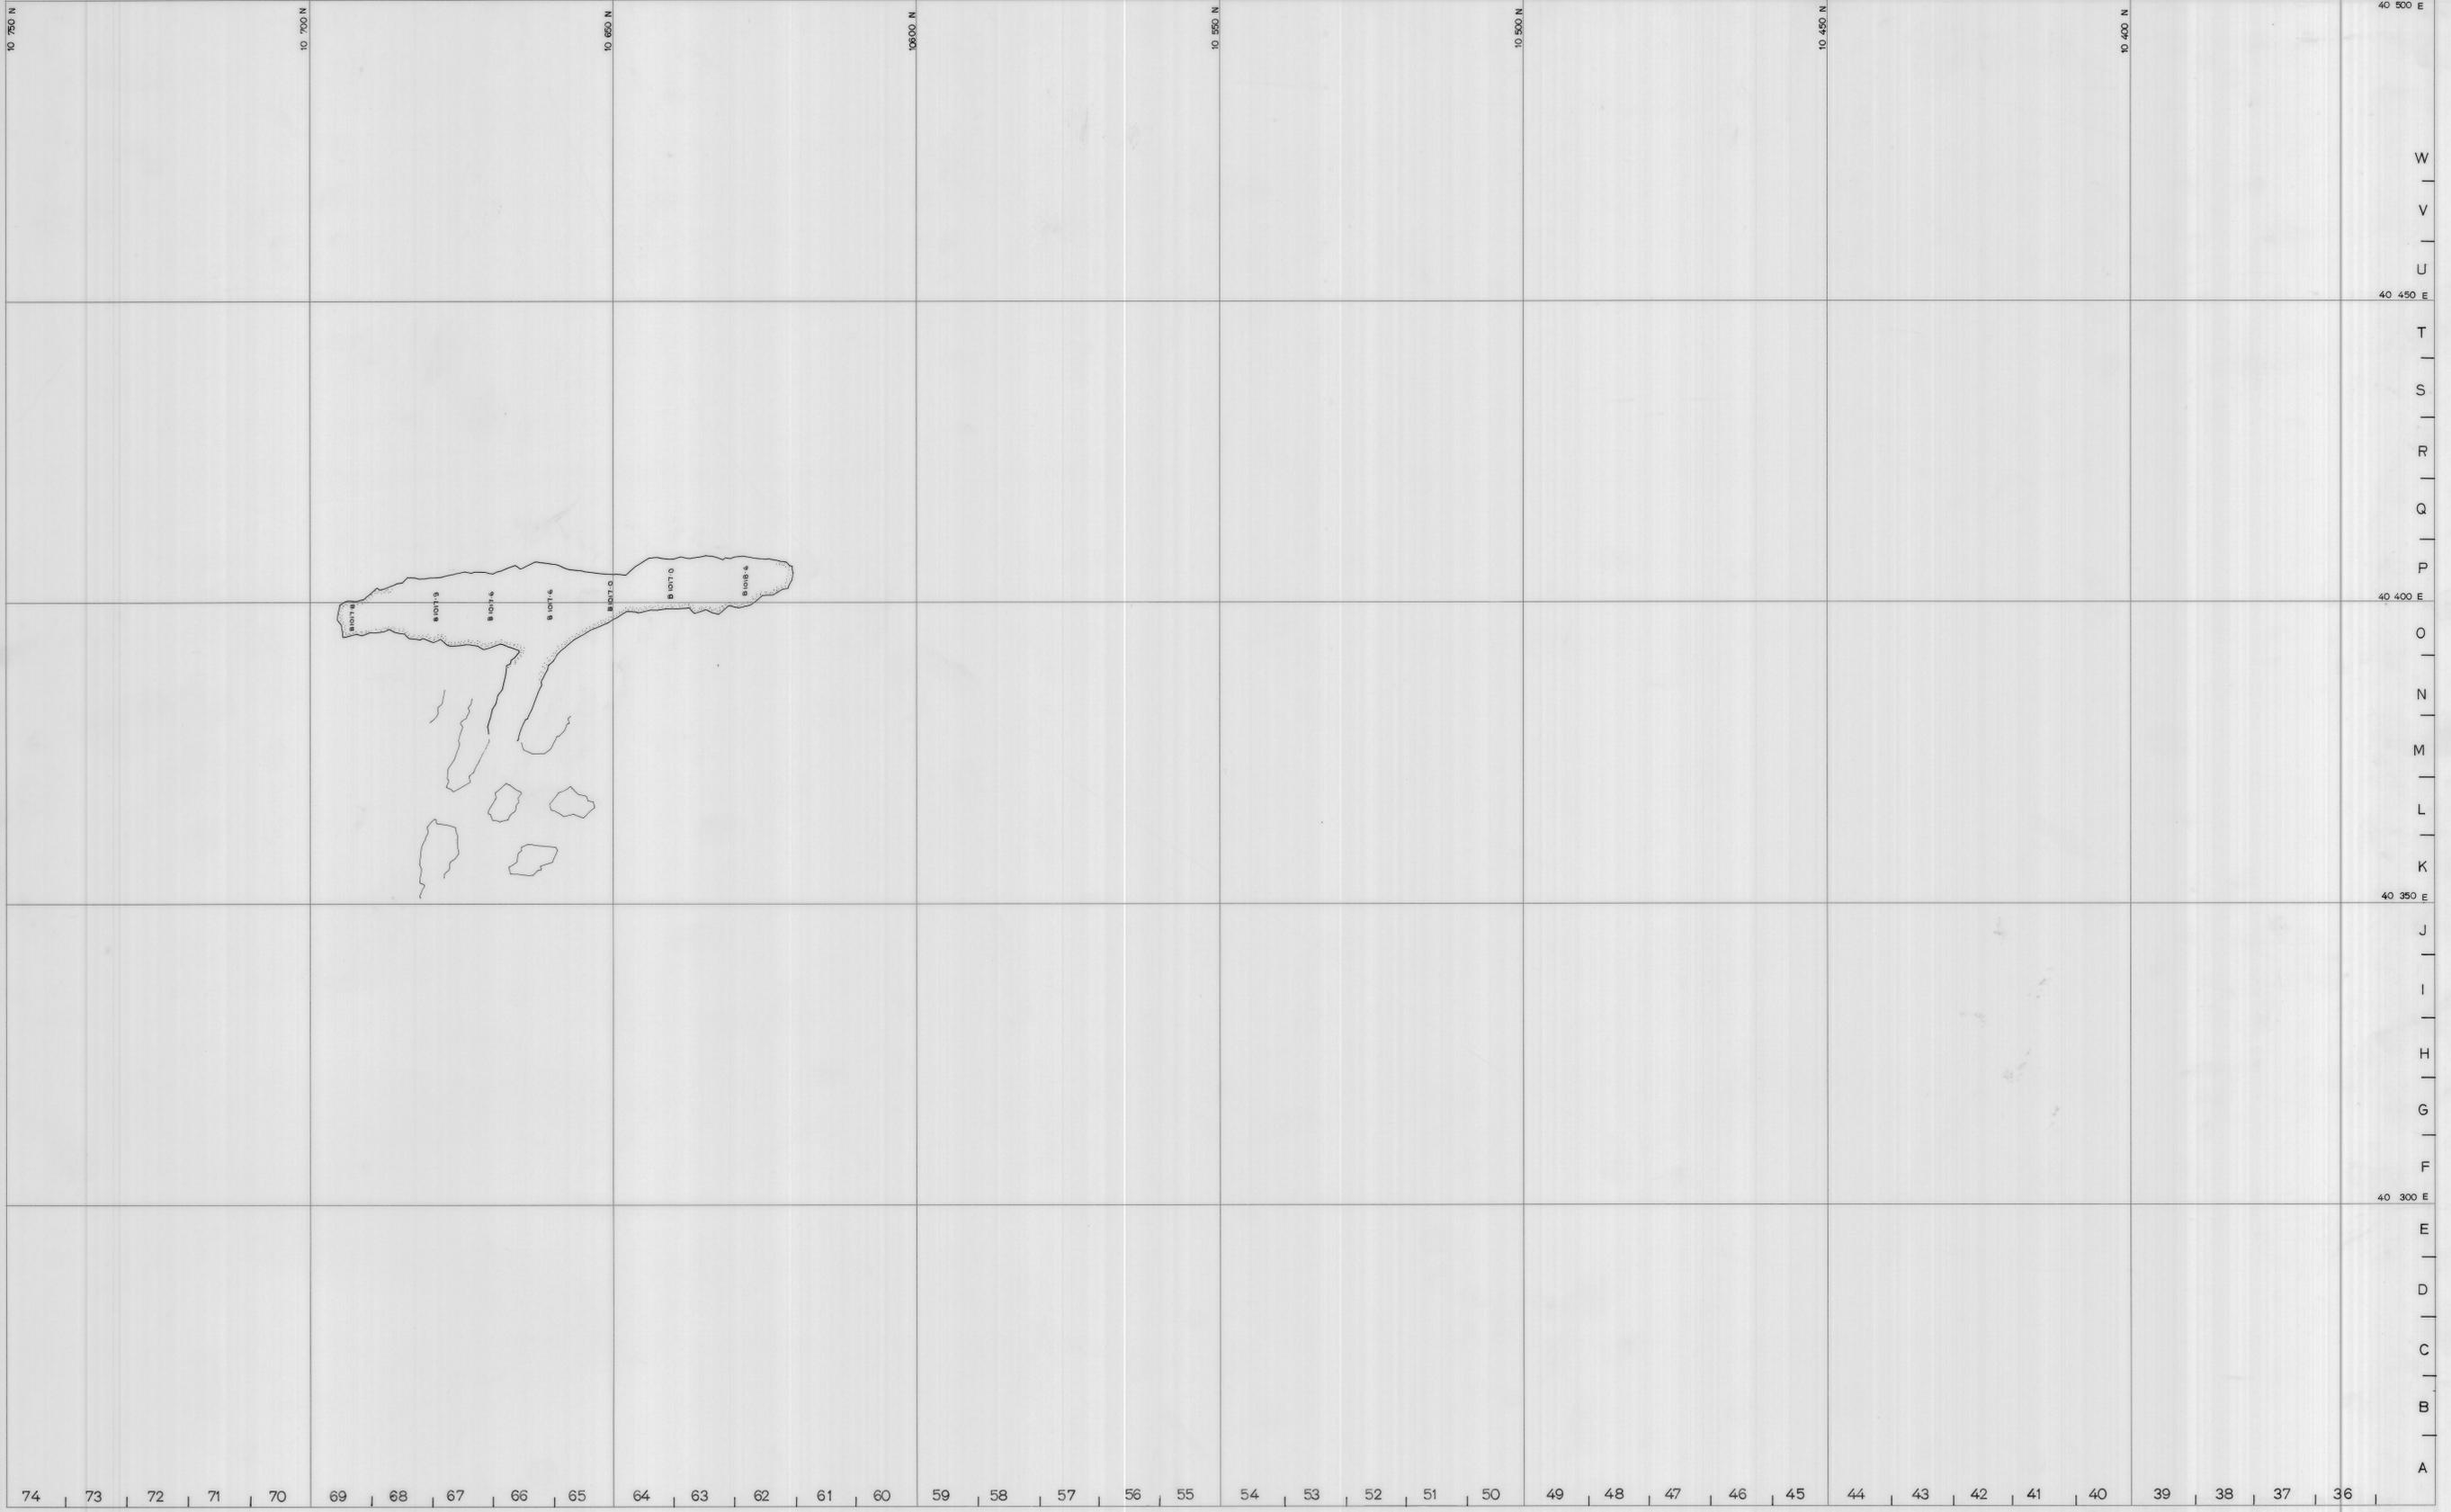

SCALE 1 500		LOCATION BOLD HEAD MINE	 <small>A DIVISION OF WARMAN INTERNATIONAL</small> GRASSY KING ISLAND <small>102-96</small>
SUBJECT P 62 STOPE [4th Lift]		PLAN NUMBER 04BH15-102-96	